



PLAN No. 4028  
FOR ENCLOSURE TO  
MESSRS LLOYDS SURVEYORS  
HULL FROM  
COCHRANE & SONS, LTD  
SHIPBUILDERS, SELBY  
DATE 3/3/14 154

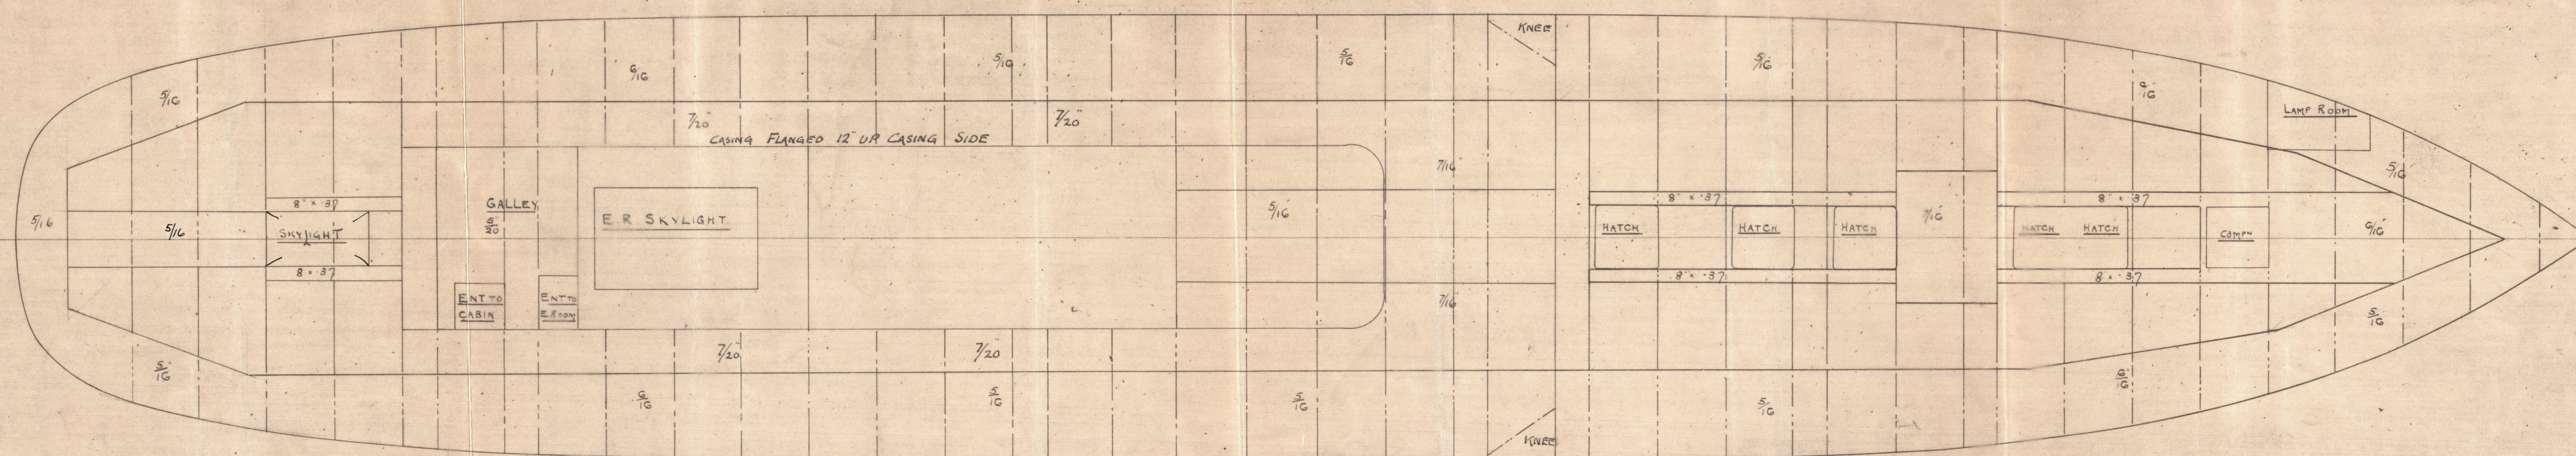

arini  
F-3-1

668  
6.2.14

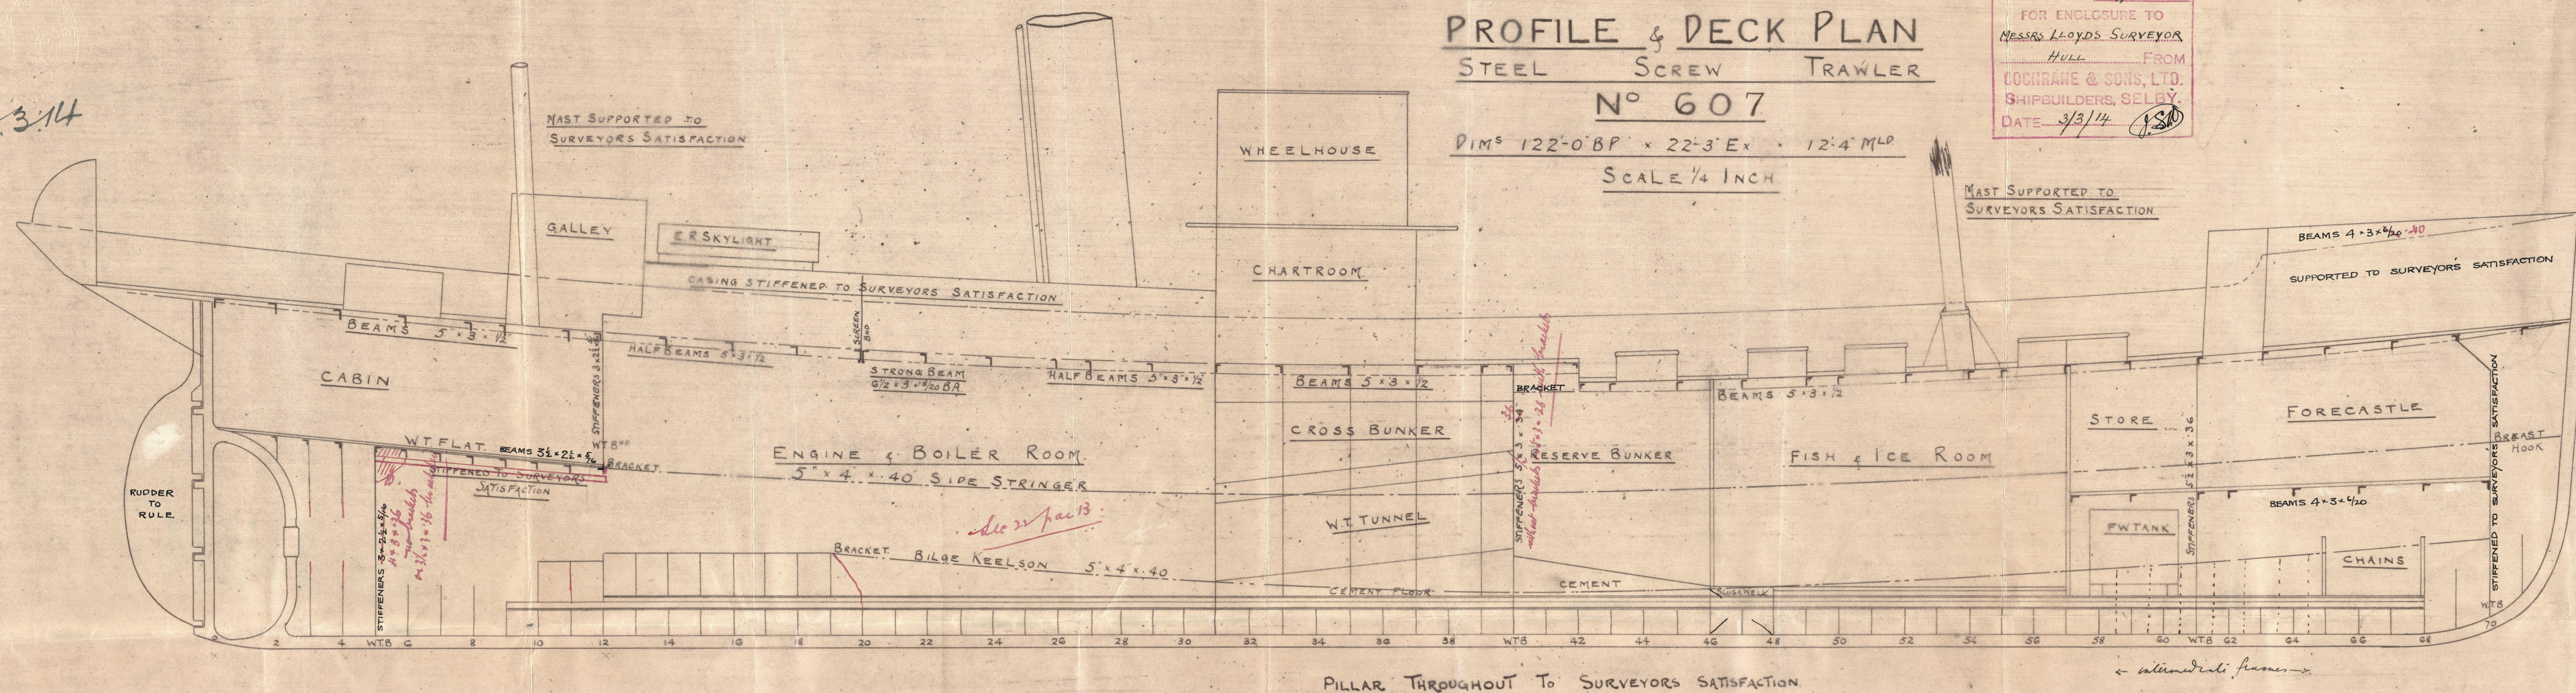

Cochran & Sons, Ltd.  
No. 607.



Profile and Deck  
Dimensions

122-0 x 22-12 x 12-33

S/S Mena.

Hull Report No

27946

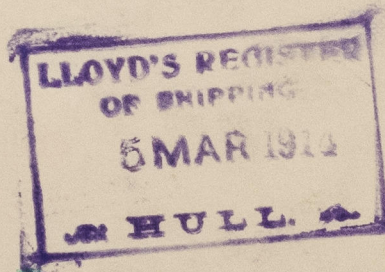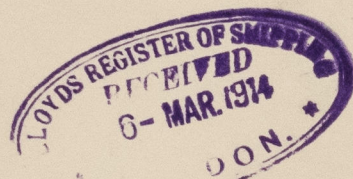

REMAIN



© 2021

Lloyd's Register  
Foundation

W1317-0186