





HARIMA YARD No. 184


Ship's Name :

**MIDSHIP SECTION.**

(Revised plan)

No.

TEIKOKU STEAMSHIP CO., LTD., KOBE, JAPAN.

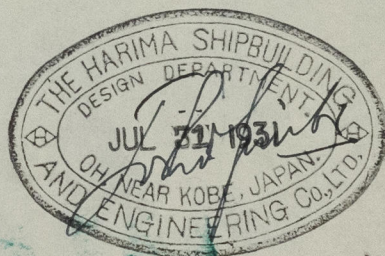

© 2021

Lloyd's Register  
Foundation