

MIDSHIP SECTION.

S. S. N° 335.

STEEL.

DIMENSIONS: 126' 0" BP X 21' 9" EX X 11' 9" DEPTH OF HOLD

CLASS 100A1

FOR FISHING PURPOSES.

SCALE 1/2" = ONE FOOT.

Cook, Welton & Semmell,

Iron Shipbuilders.

HULL.

27 MAY 1902

LLOYDS NOS

| | |
|---------------|---------------------------------|
| 1/2 GIRTH | 10.33 |
| 1/2 BREADTH | 10.80 |
| DEPTH | 12.95 WITH NORMAL ROUND OF BEAM |
| LLOYDS LENGTH | 125.85 |
| | 5334.59 2ND NO |

1/2 B: 5.7 1/2 B: 9.5

ANCHORS AND CHAINS

1 ANCHOR 50 CWT EX STOCK

1 5 1/2" 2 1/2" 1/2"

105 50 FATHOMS 1/2" CHAIN

60 6 HAWSER

60 4 1/2 WARP



2.6.02

21. 10. 02

HOLLOW BEAD

3 x 1 1/2"

BULWARKS 5

9/16 IN WAY OF RQD

SINGLE LAP

3/4 RIVETS

31 x 7

31 x 16

DOUBLE LAP

3/4 RIVETS

E 16 45

DOUBLE LAP

3/4 RIVETS

D 7 1/2 38

DOUBLE LAP

3/4 RIVETS

BULB 7 1/2 10

ANGLES 3 1/2 x 3 1/2

C 38 x 10

DOUBLE LAP

3/4 RIVETS

B 10 1/2 10 x 41

DOUBLE LAP

3/4 RIVETS

A 9 1/2 46

DOUBLE LAP

3/4 RIVETS

31 x 7 1/2

DOUBLE LAP

3/4 RIVETS

31 x 16

DOUBLE LAP

3/4 RIVETS

31 x 7 1/2

DOUBLE LAP

3/4 RIVETS

31 x 16

DOUBLE LAP

3/4 RIVETS

31 x 7 1/2

BULB ANGLE 6 1/2 x 3 1/2

2 1/2 x 2 1/2 x 5/16

2 1/2 x 2 1/2 x 5/16

QUARTER DECK 50' 0" x 12'

SCANTLINGS SAME AS MAIN DECK

WOOD DECK 5' 3" x 7' 6"

7" CROP

BEAMS 5' 3" x 1/2"

ON ALTERNATE FRAME

STRINGER PLATE

20' x 9/16 TO 17' x 16

FRAMES 3' 2 1/2" x 5/8" SPACED 20" APART.

REV " 2 1/2" x 2 1/2" x 1/4" TO UPPER TURN OF BILGE.

DOUBLE IN ENGINE AND BOILER SPACE

KEEL 7' 1/2" x 1/2" STEM 8' 2"

STERNFRAME 8' 3" RUDDER HEAD 4' 4" KEEL 3' 2 1/2"

BULKHEADS 1/2" THICK STIFFENED AS PER RULE

HOLD STANCHIONS 8' 0" DIA

FLOORS 10' x 10' 1/2" IN ETS SPACE

BUTTSTRAPS OF SHEERSTAKE & ONE

STAKE AT BILGE 1" THICKER THAN

PLATES THEY CONNECT & DOUBLE

RIVETTED. STRINGER DOUBLE

BUTT LAPS.

BUTT LAPS.

BALLAST TANK 8' 4" LONG

3' 3" x 3' 3"

IN WAY OF

MAIN DECK

FRAME CUT HERE

MARGIN PLATE 3/8"

3' 3" x 3' 3"

3' 3" x 3' 3"

BUTTSTRAPS 3/4 RIVETS

3 3/4" x 1 1/2"















Hull

Cook No 335



s/s Swan

Hull Report No 15000

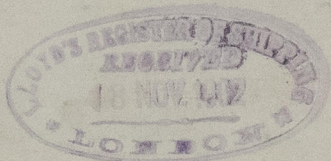

R/S

RETAIN

© 2021

Lloyd's Register
Foundation

w 1318-0206