

S.S. 271.

DIMENSIONS

TWEEN DECKS 8'-6"

F. STRAKE IN
66' x 62" to 46"
BUTTS QUADRUPLE RIVETED FOR
1/2 LENGTH TREBLE AT ENDS

E. J. M.
28/5/11


Northumberland L. Co

SS 271

Widship section as built

S. S. WAITEMATA
NEWCASTLE C. TYNE.

Report No. 71907

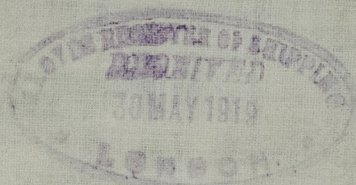

© 2021

Lloyd's Register

W1318-0294