



NO 1056.  
STRUCTURAL ARRANGEMENT.  
SCALE 1/8 IN. TO ONE FT.


PROFILE

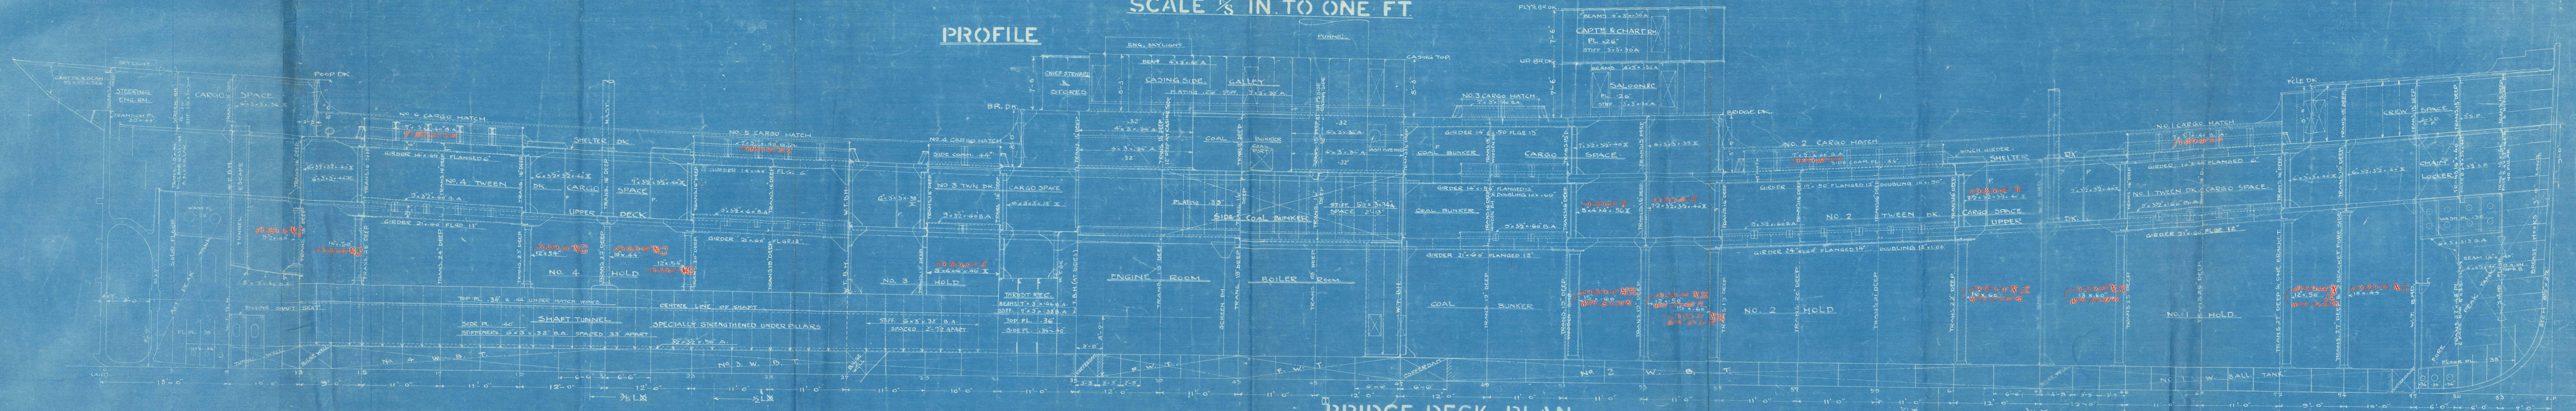


POOP DECK PLAN

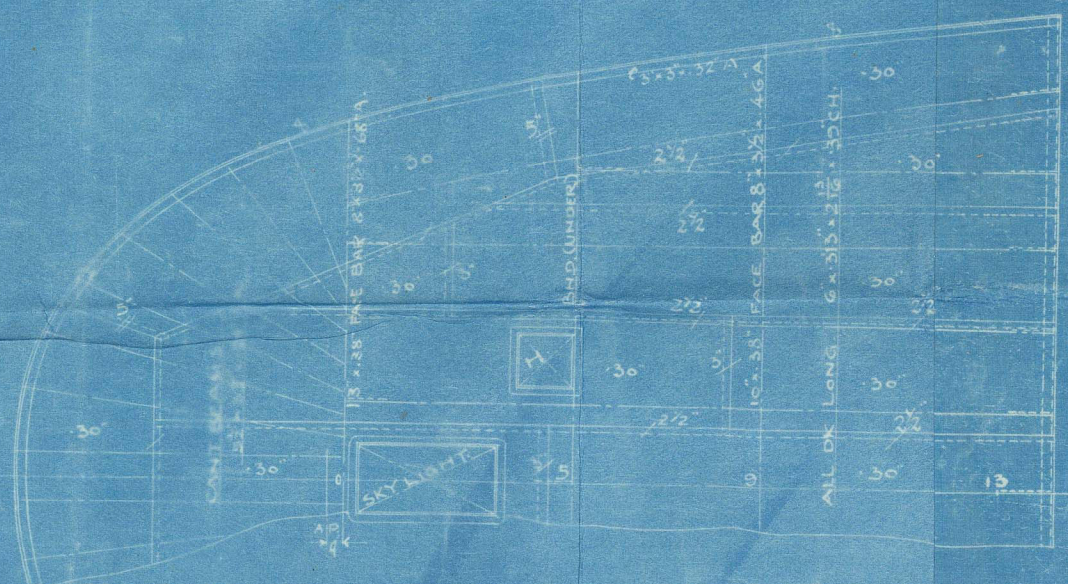


BRIDGE DECK PLAN

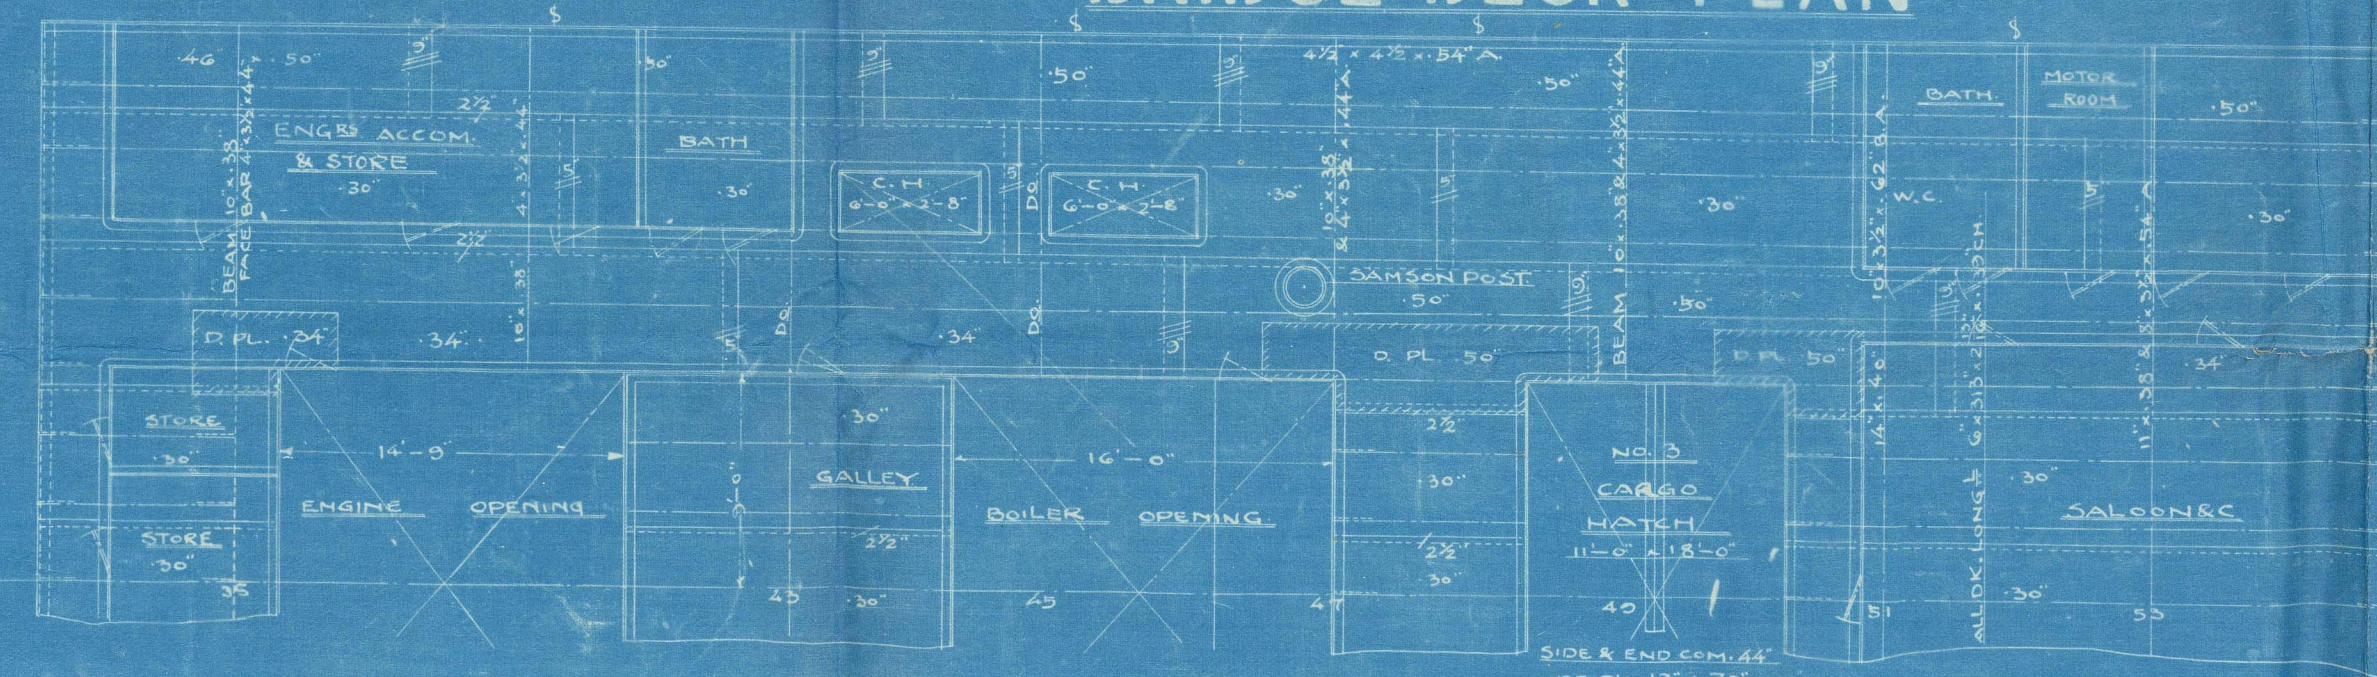


FORECASTLE DECK PLAN

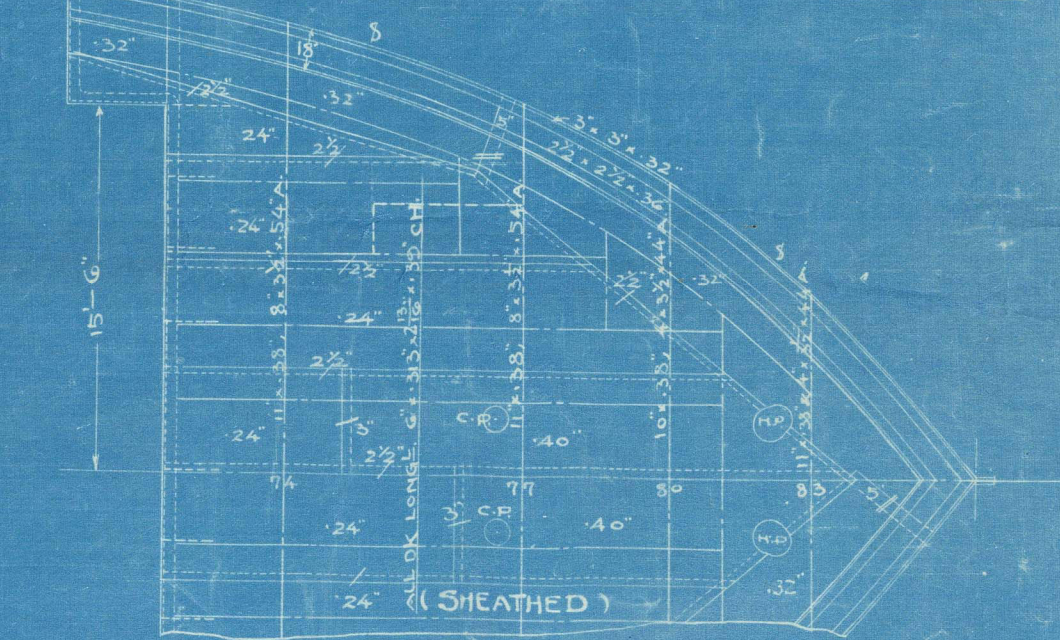

SHELTER DECK PLAN

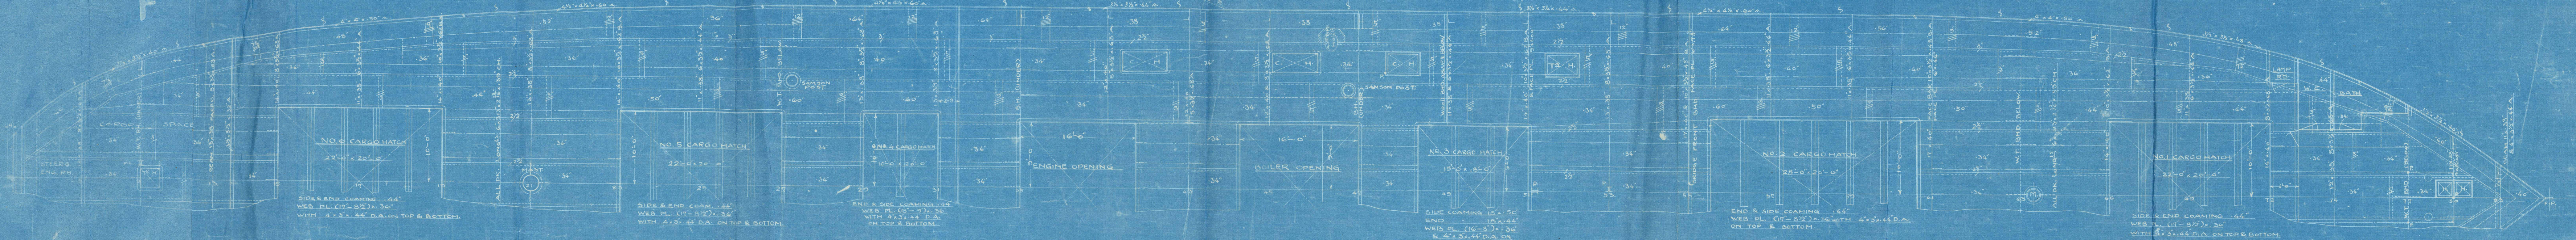

UPPER DECK PLAN

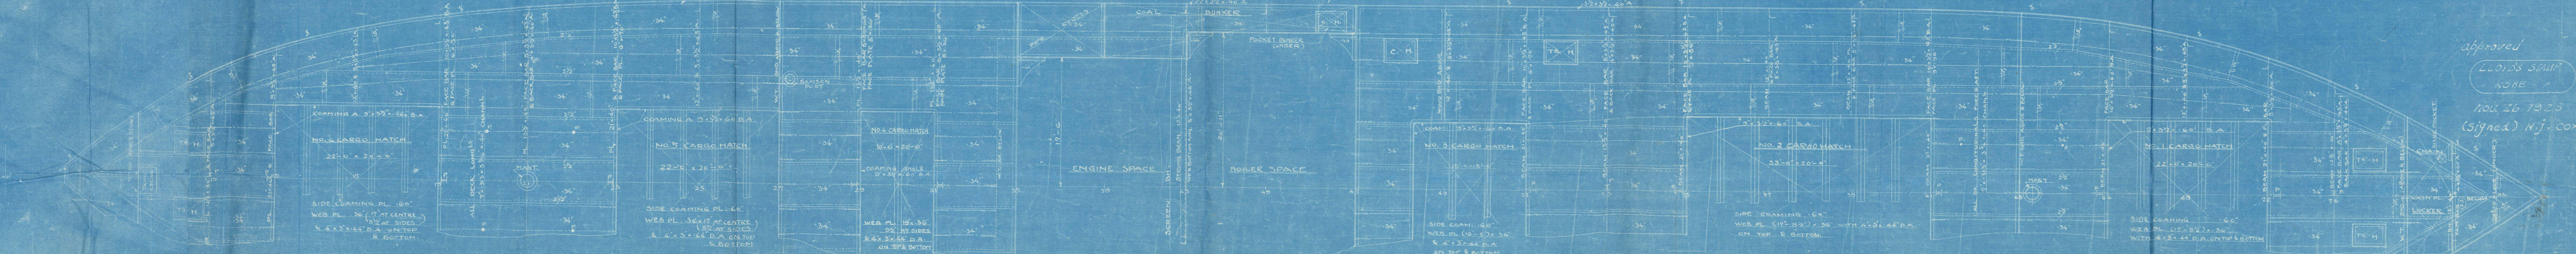

Approved  
LLOYD SHIP  
NOV. 26 1925  
(Signed) W.J. COX



W1320-0236


NO 1056

SS ITIYO MARU  
STRUCTURAL  
ARRANGEMENT

P/D



RETAIN

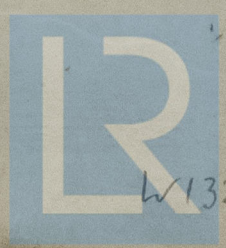

© 2021

Lloyd's Register  
Foundation

W1320-0236