


Tensan Maru

Kebe 6536

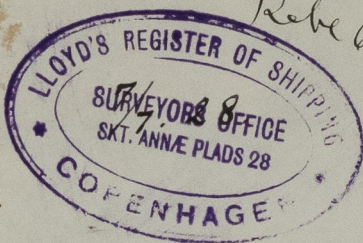

Plan of
CRANK AND THRUST SHAFT
for the Main Diesel Oil Engine
designated "MITSUBI 10 & 11"

to be constructed by

AKTIESELSKABET
BURMEISTER & WAIN MASKIN- OG SKIBSBYGGERI
Copenhagen

for the Screw Motor Diesel
Yard No 159 & 160

being built by
Messrs Mitsui Bussan Kaisha.
Yama. Japan.

Copenhagen Report No 8011.

— " — " — 8012.

Lloyd's Register
Foundation

W1320-0285