







REGISTERED AND SURVEYED BY THE
HYDROGRAPHIC SURVEY
SUNDERLAND

 

PROFILE. N^o 320 S.S. CAIRNGOWAN.

LENGTH B.P. 400'-0", BREADTH M^d 52'-0", DEPTH M^d 31'-0".

SCALE: 1" = 1 FOOT.
TO CLASS 100-A. LLOYD

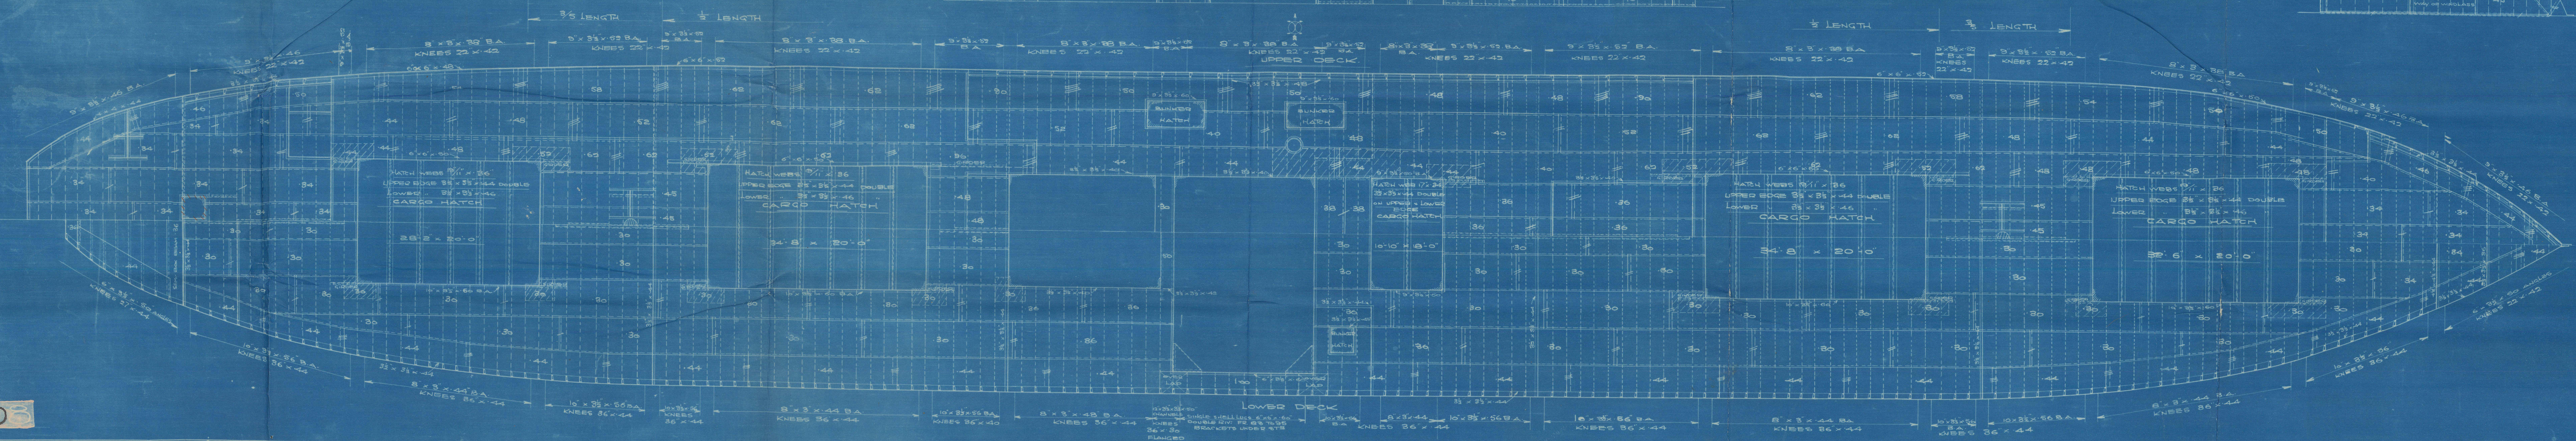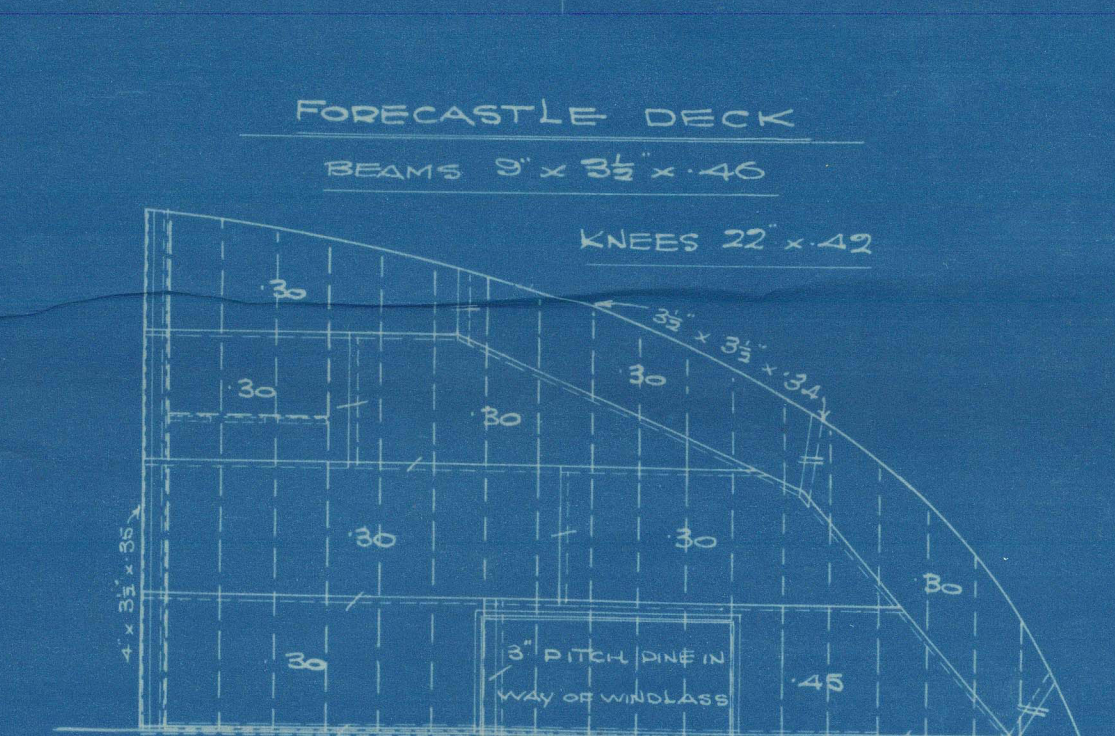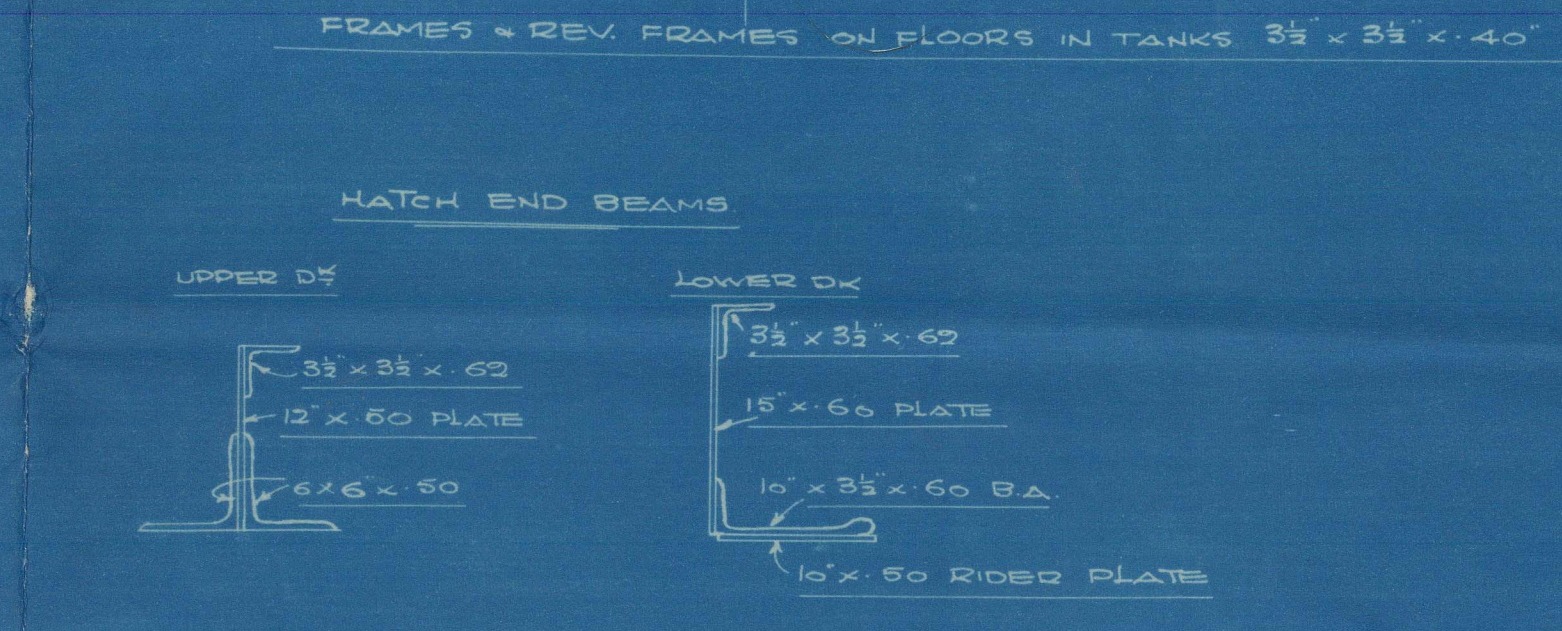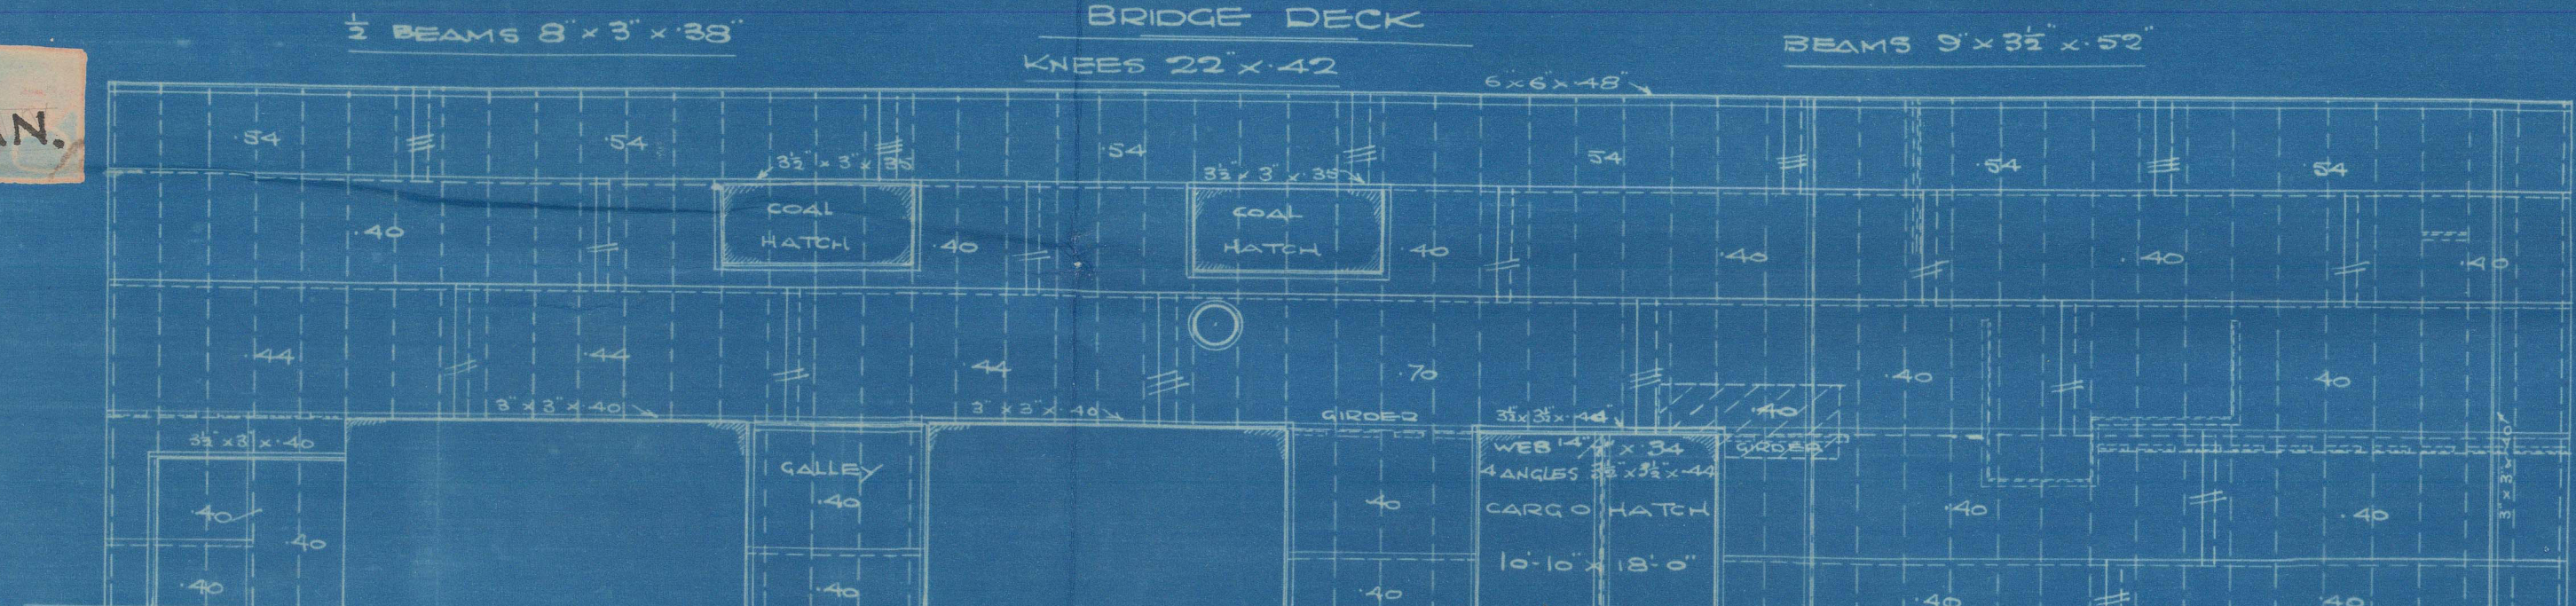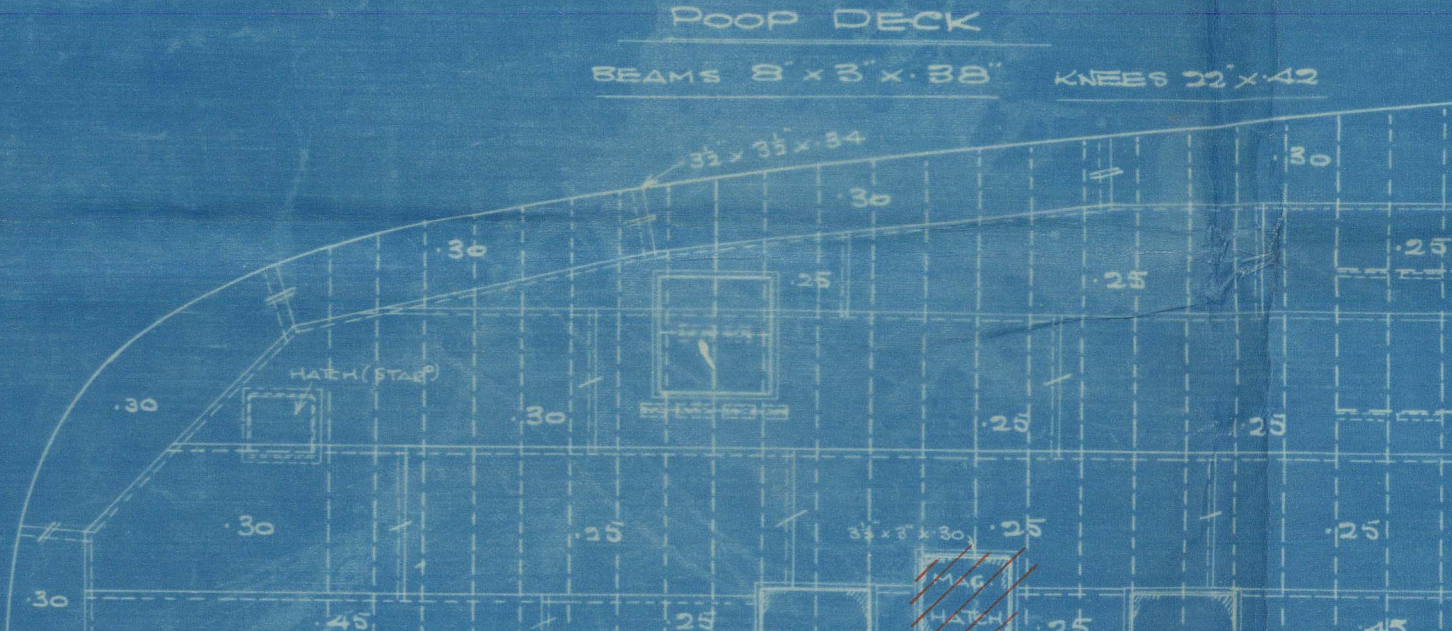

N^o 320

PROFILE

Nº 320^s/_s

Cairngowan

as built.

GUNDEMLAND RPT. NO. 27487.1.

Yamahagi Maru
(D) 176

RETAIN



© 2021

Lloyd's Register
Foundation

W1321-0052