
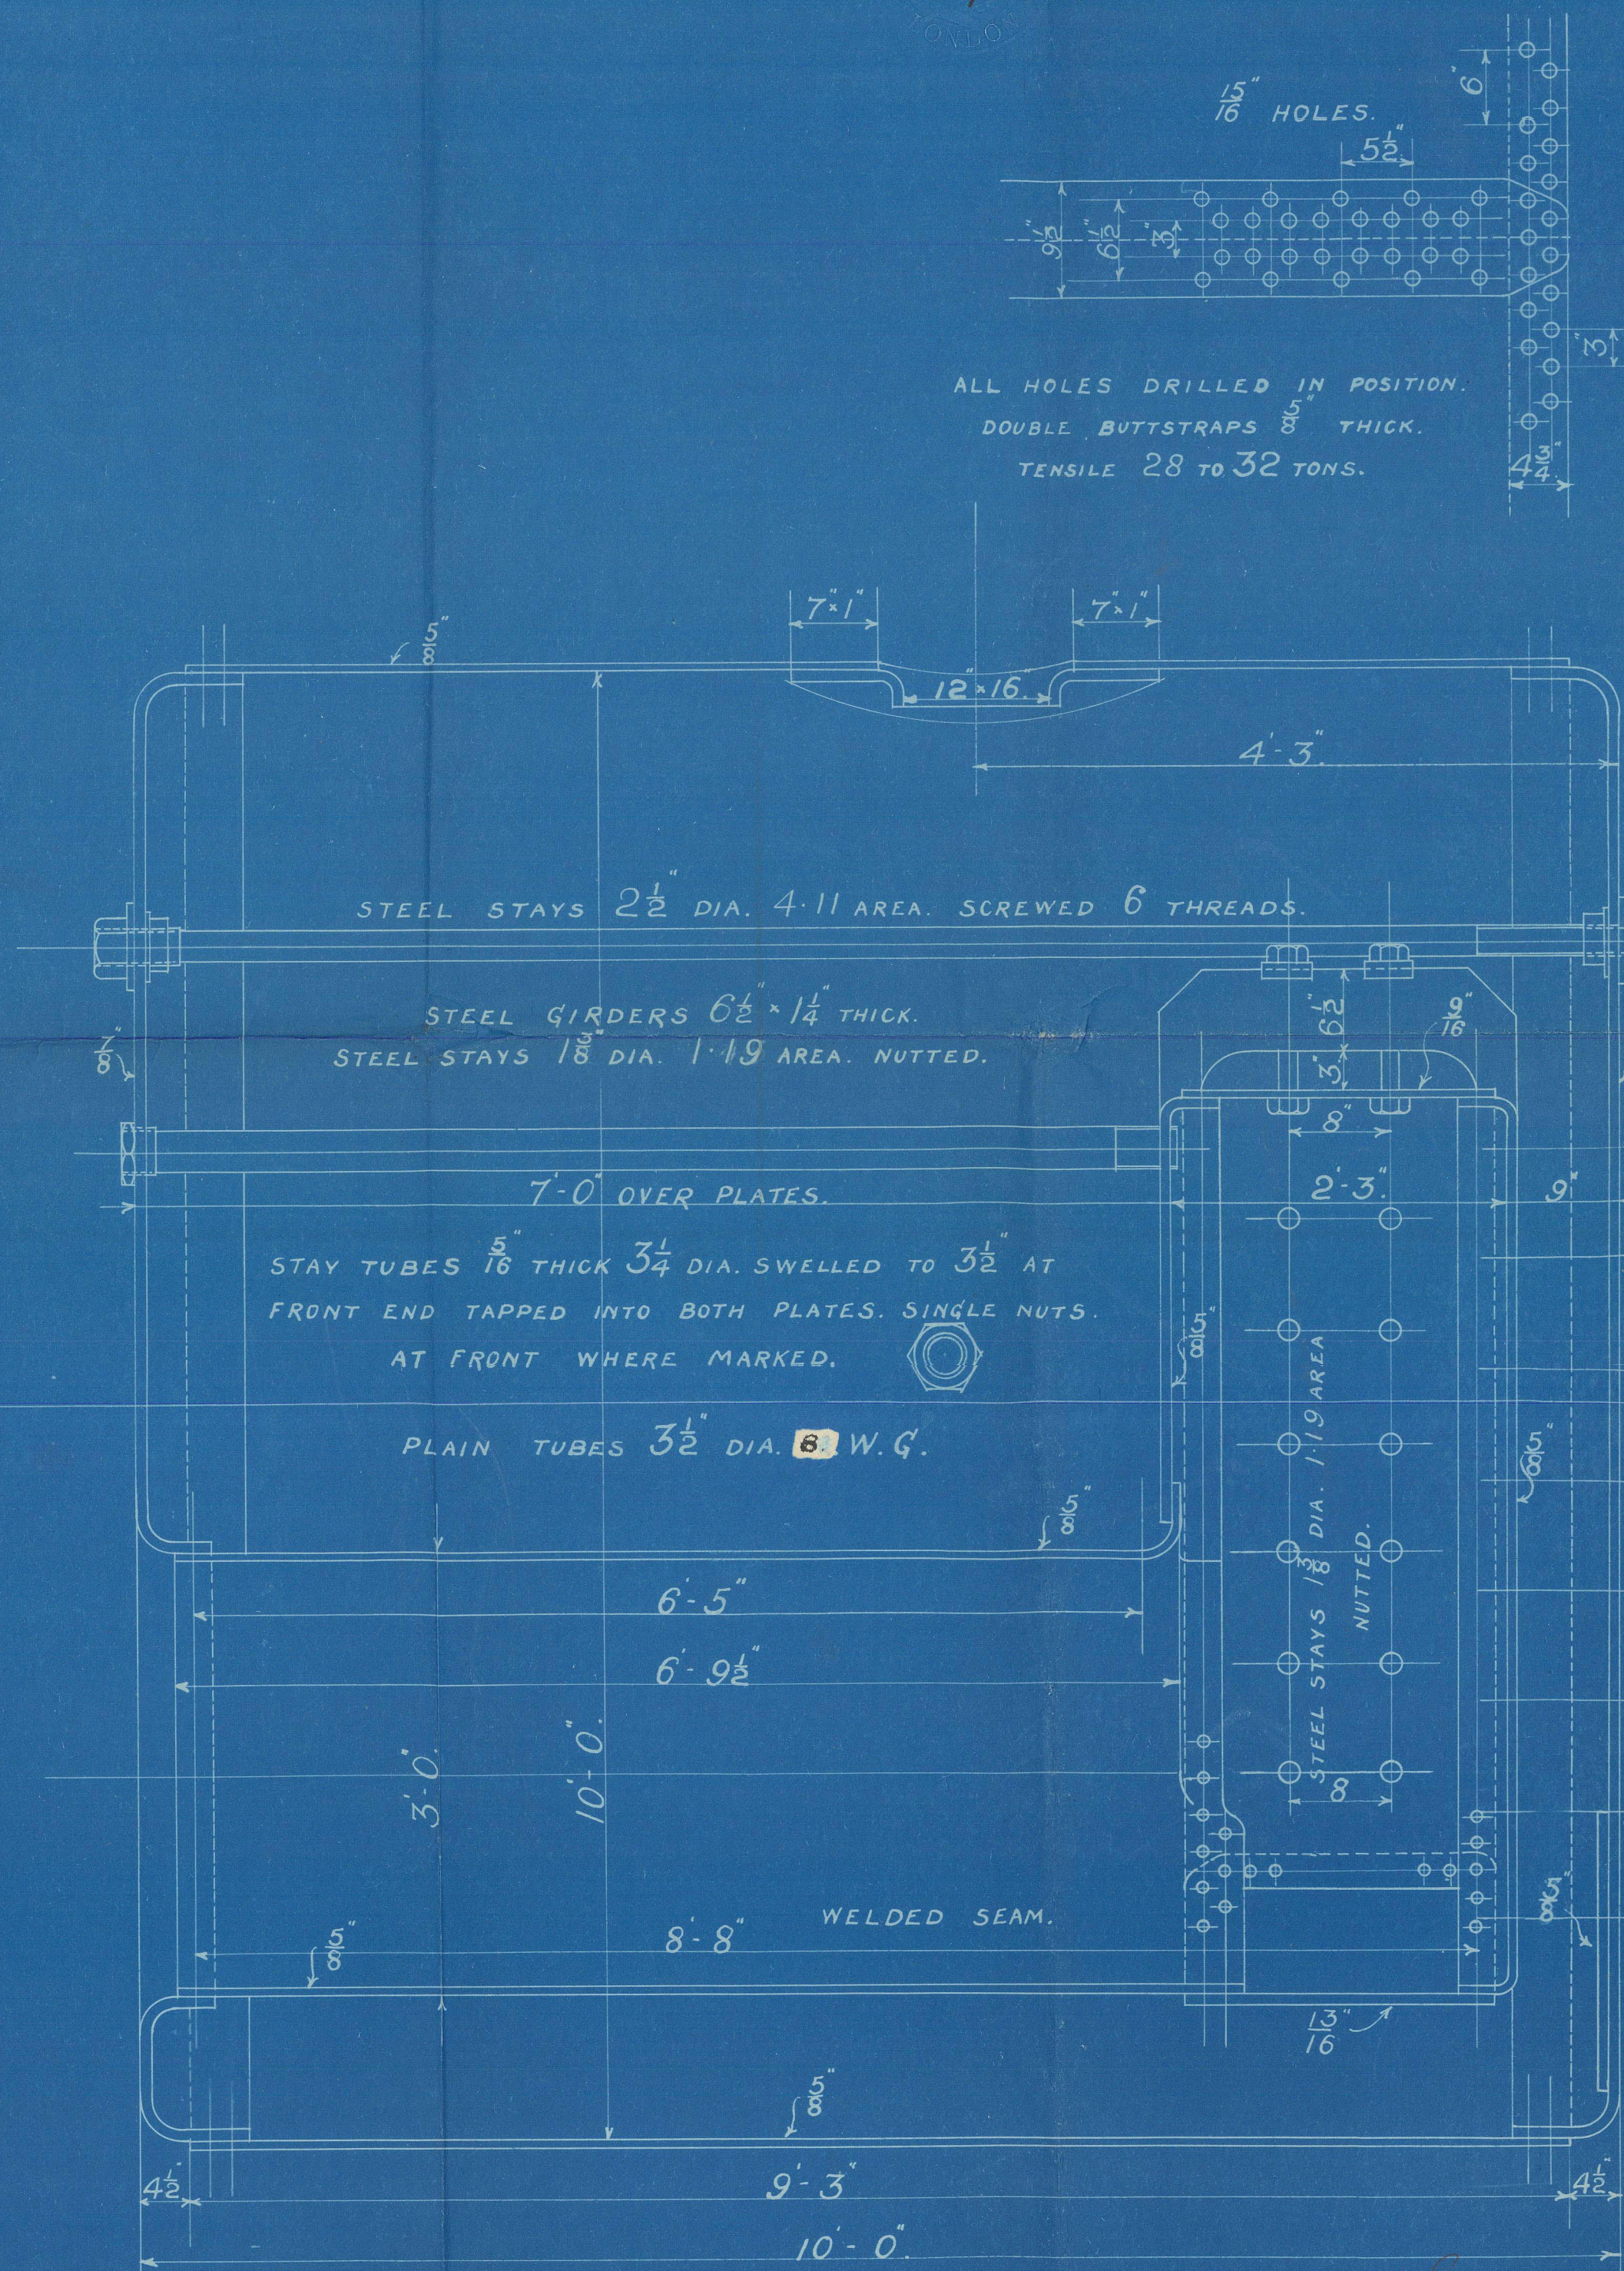


STEEL BOILER 10-0 DIA 10-0 LONG 120 LBS W.P. LLOYDS


4457-8

15/10/12

RILEY BROS. (BOILERMAKERS) LTD
STOCKTON ON TEES.

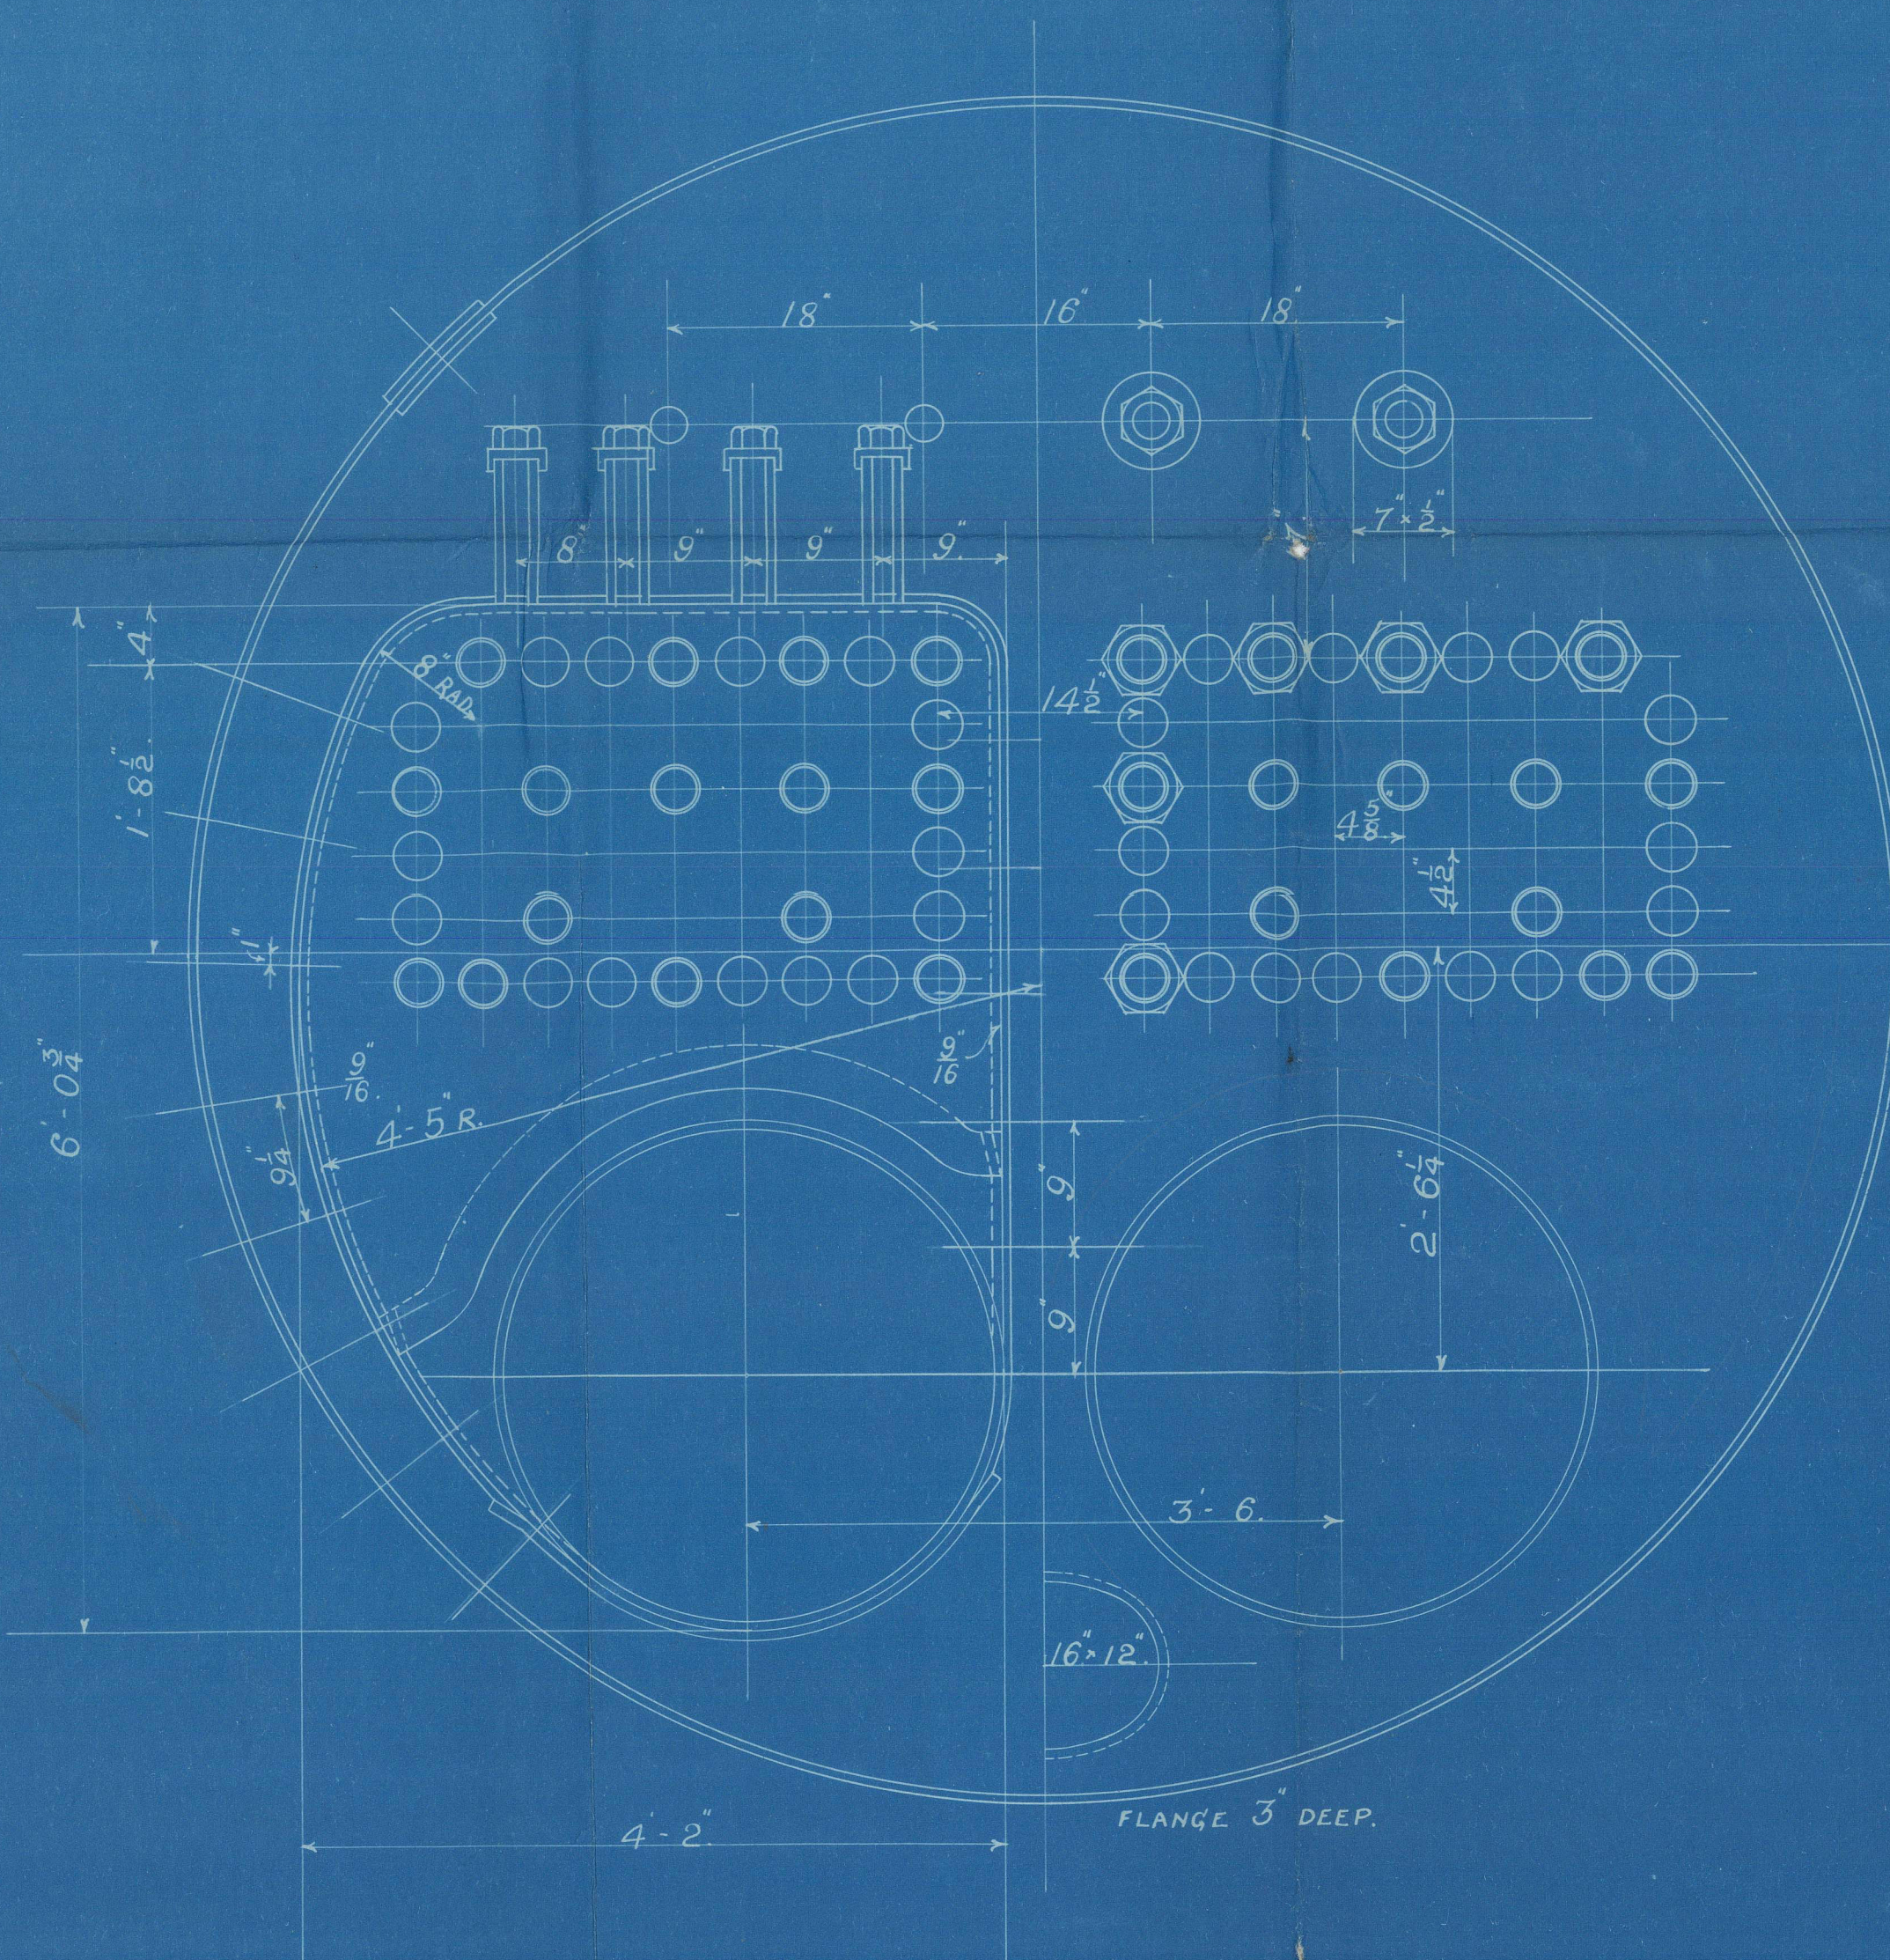

TO BE 1 3/8" DIA. 2.03 AREA
ALL SCREW STAYS OF
STEEL 9 THREADS PER I.
NUTTED BOTH ENDS.

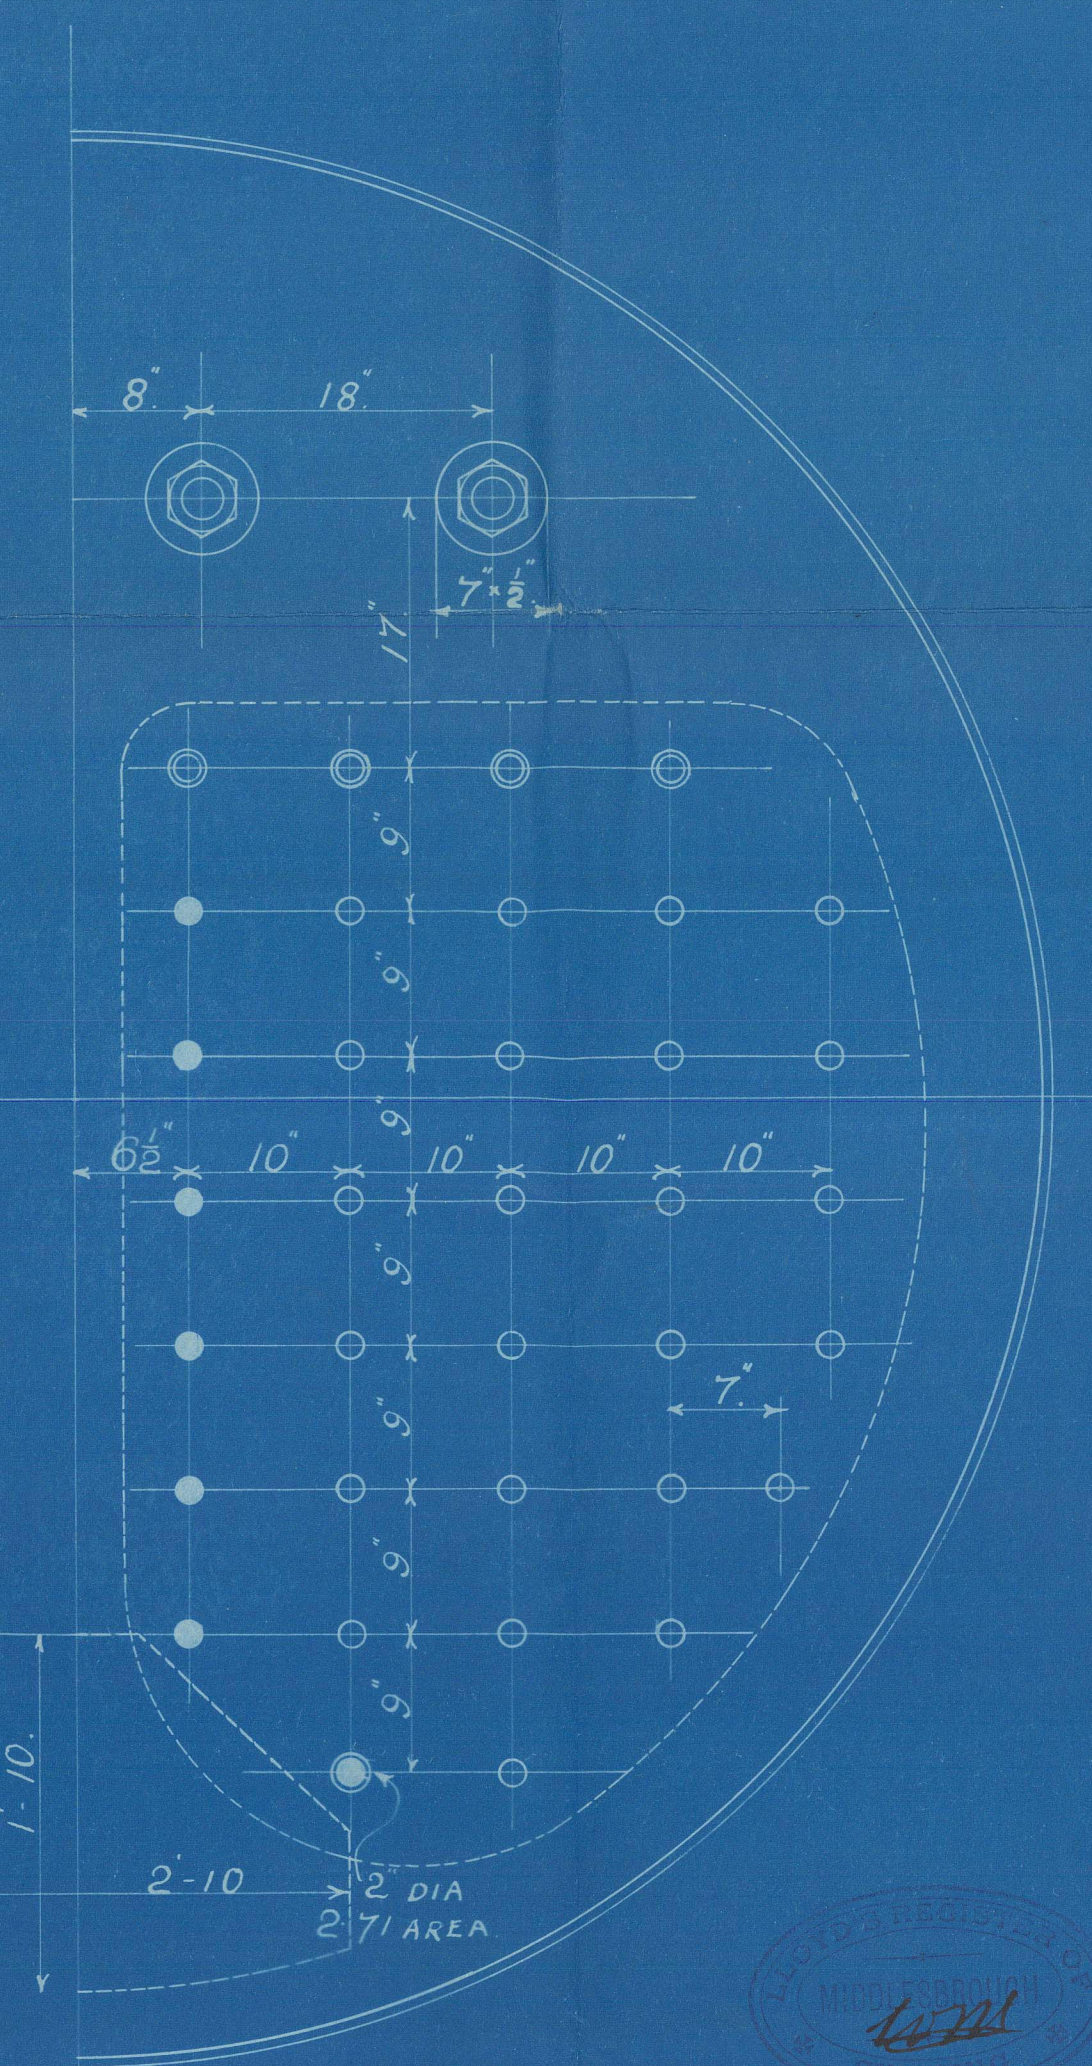

15.10.12
L.H.H.
15/10/12

HEATING SURFACE 863 sq. ft.
GRATE AREA 29 sq. ft.

14/10/12

Messrs Riley Bros Ltd
Boilers ~~4457~~
4458

for

Messrs Craig Taylor & Co
S. S. No. 157
" 159

Working Press 120 lbs



4457

No.	5088
LLOYD'S TEST	
240 lbs.	
7.6.13 - WM	
Rpt No 7969	

S. S.
"Atherstone"

4458

No.	5147
LLOYD'S TEST	
240 lbs.	
6.9.13 J.K.	

Md. Repoch.
No 8102.
S. S. Penistone

RETAIN



© 2021

Lloyd's Register
Foundation

W1321 - 0315