


DIMENSIONS

LENGTH B.P.	370'-0"
BREADTH MLD	51'-1"
DEPTH MLD	26'-6"
BREADTH EXT.	51'-4 1/2"

MIDSHIP SECTION

SCALE 1/2" = 1 FOOT
 IN. 10310
 CLASS 100 FT. LLOYDS

NUMERALS	
B+D	77'-58"
L (B+D)	2870.4
L TO MAIN DECK	13.95
D TO BRIDGE DECK	10.74
EQUIPMENT 2870.4	
POOP	52.1
SHELTER DK	288.9
HOUSES & CASING	(57.9 + 28.1) x 7 1/2 = 261
EQUIPMENT N°	3100

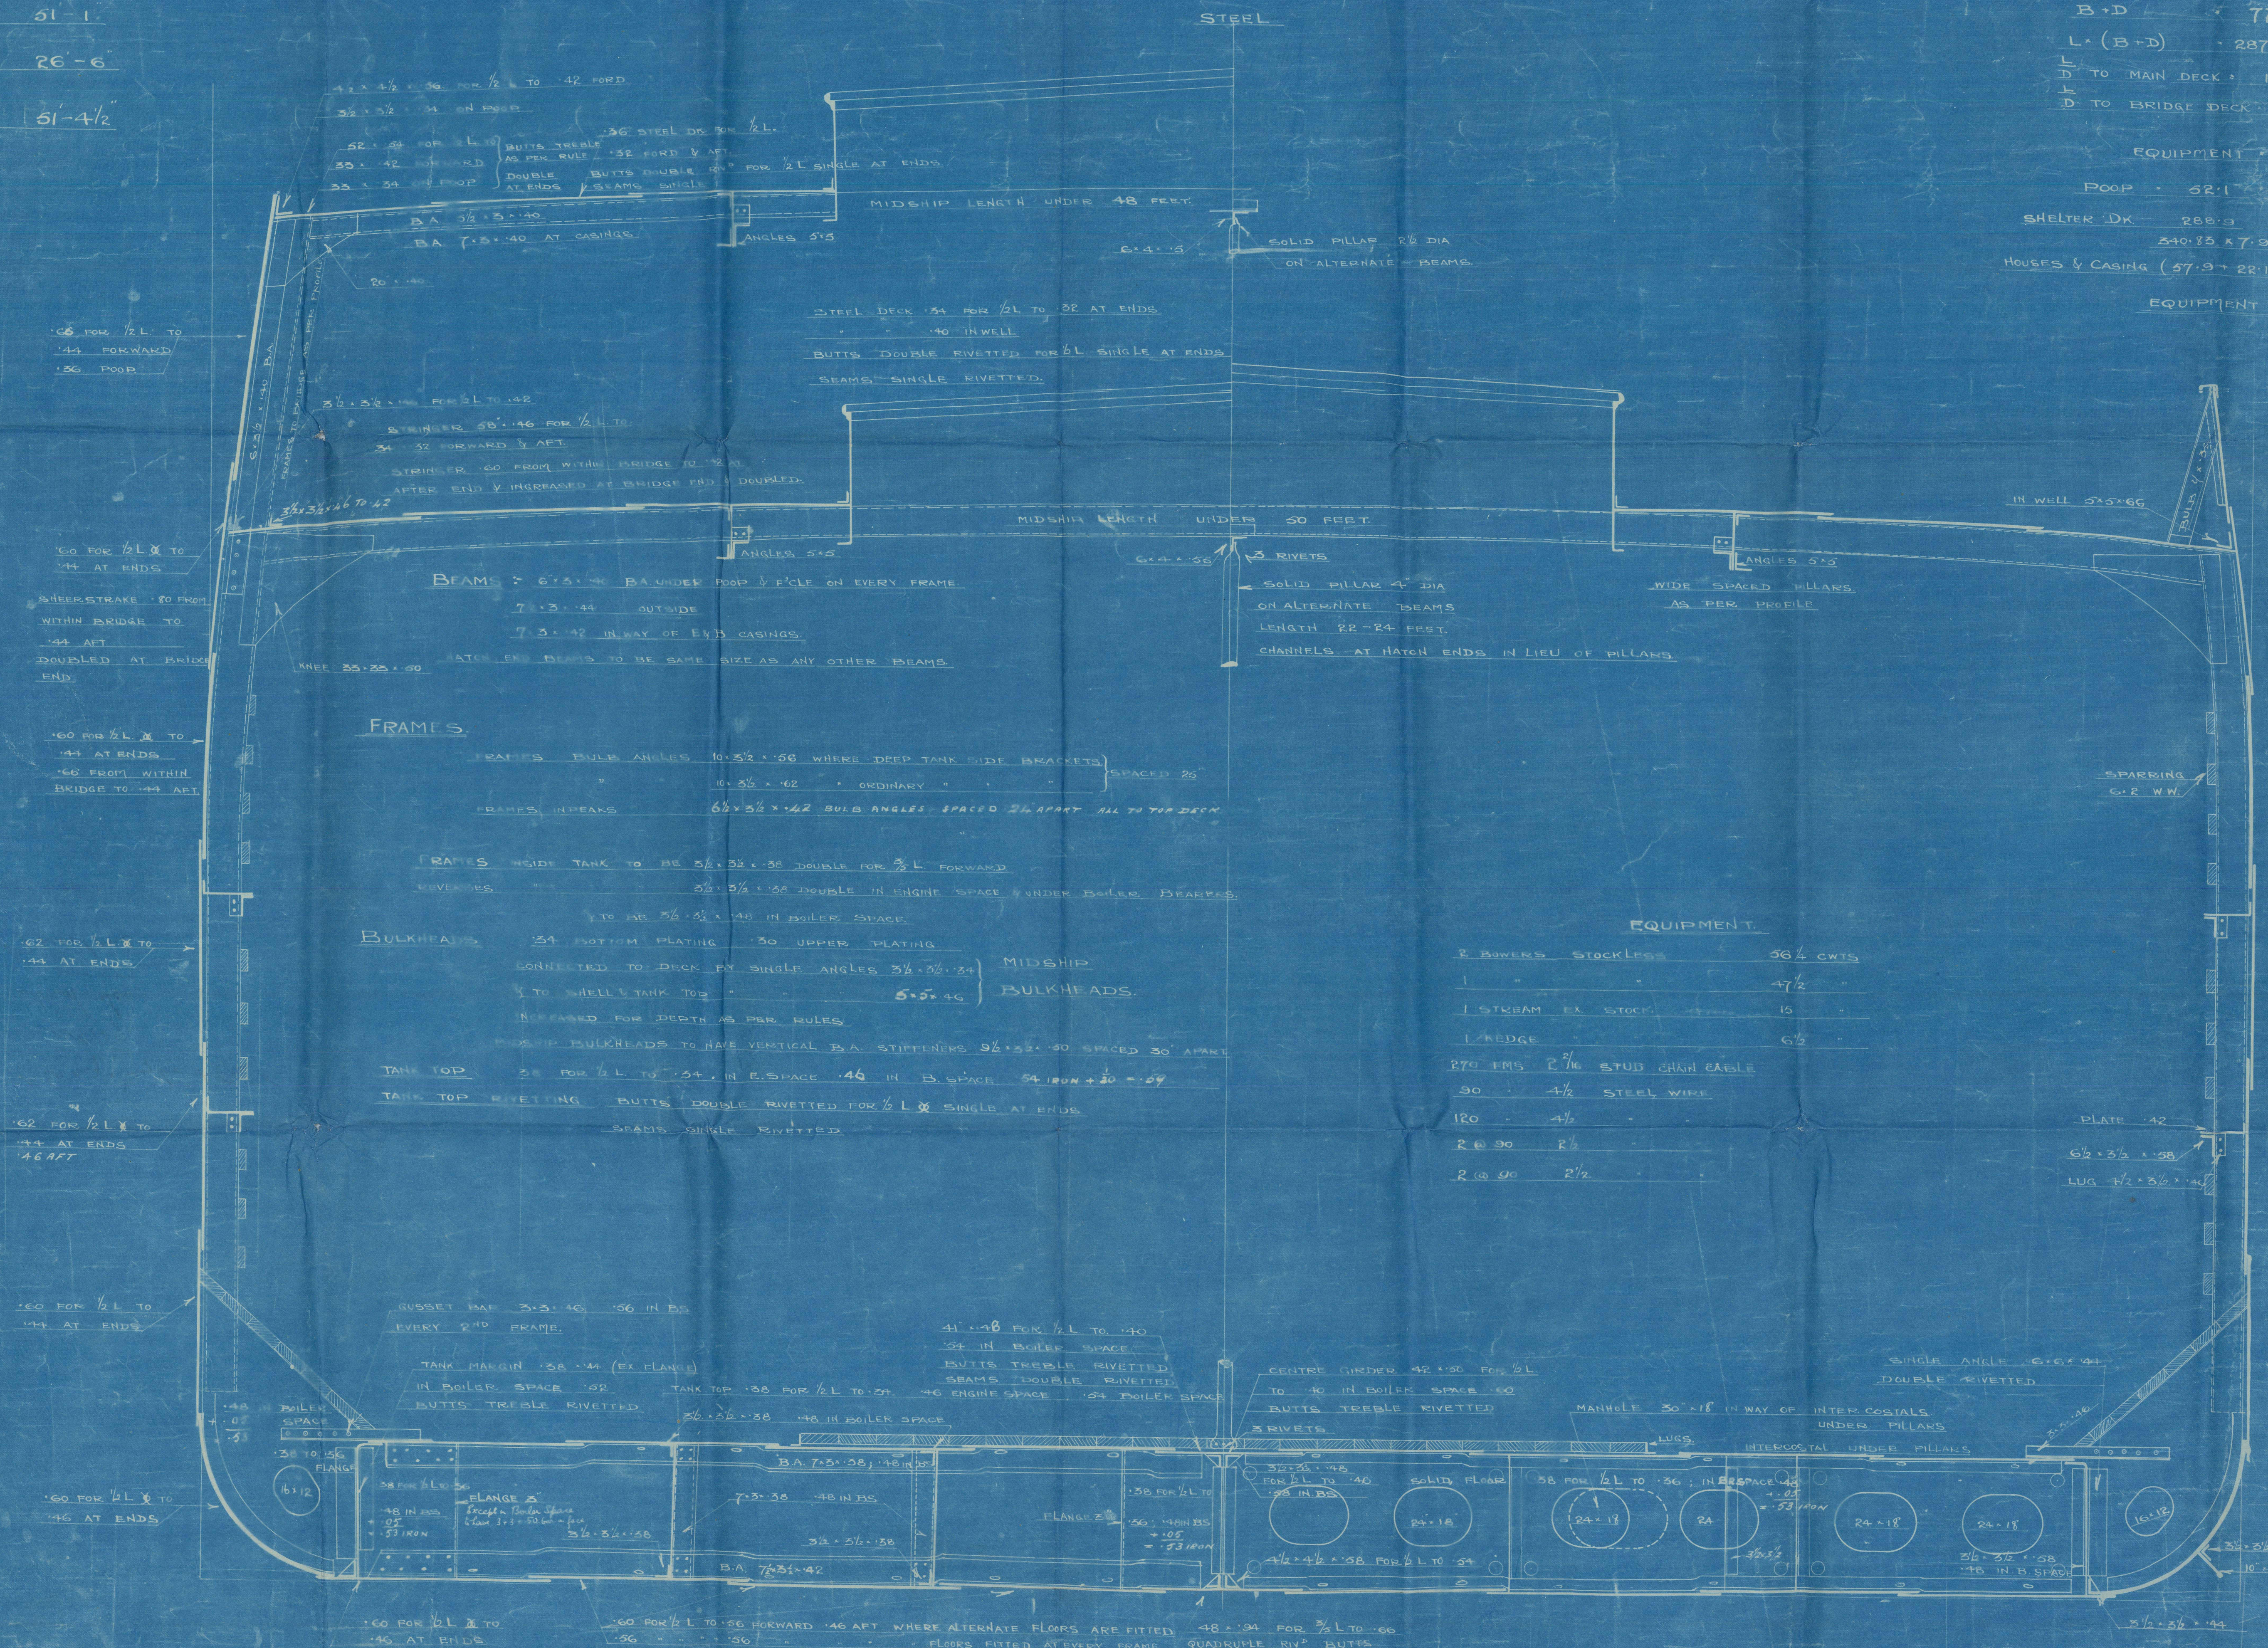

EQUIPMENT	
R BOWERS STOCKLESS	56 1/4 CWTs
1 " "	47 1/2 "
1 STREAM EX STOCK	15 "
1 RIDGE	6 1/2 "
270 FMS 2 1/16 STUB CHAIN CABLE	
30 1 1/2 STEEL WIRE	
120 4 1/2 "	
2 @ 30 2 1/2 "	
2 @ 90 2 1/2 "	

SHELL RIVETING OVERLAP BUTTS THROUGHOUT FROM KEEL TO UPPER SHEERSTRAKE TO BE QUADRUPLE RIVETTED FOR 1/2 L. TREBLE AT ENDS EXCEPT POOR SIDE WHICH IS TO BE DOUBLE.



Messrs. Craig Taylor & Co. &
W. 1857.

Mid. Sec.

S. R. Hurstone

Mdb. Report. 8051.

RETAIN



© 2021

Lloyd's Register
Foundation

W1321-0318