
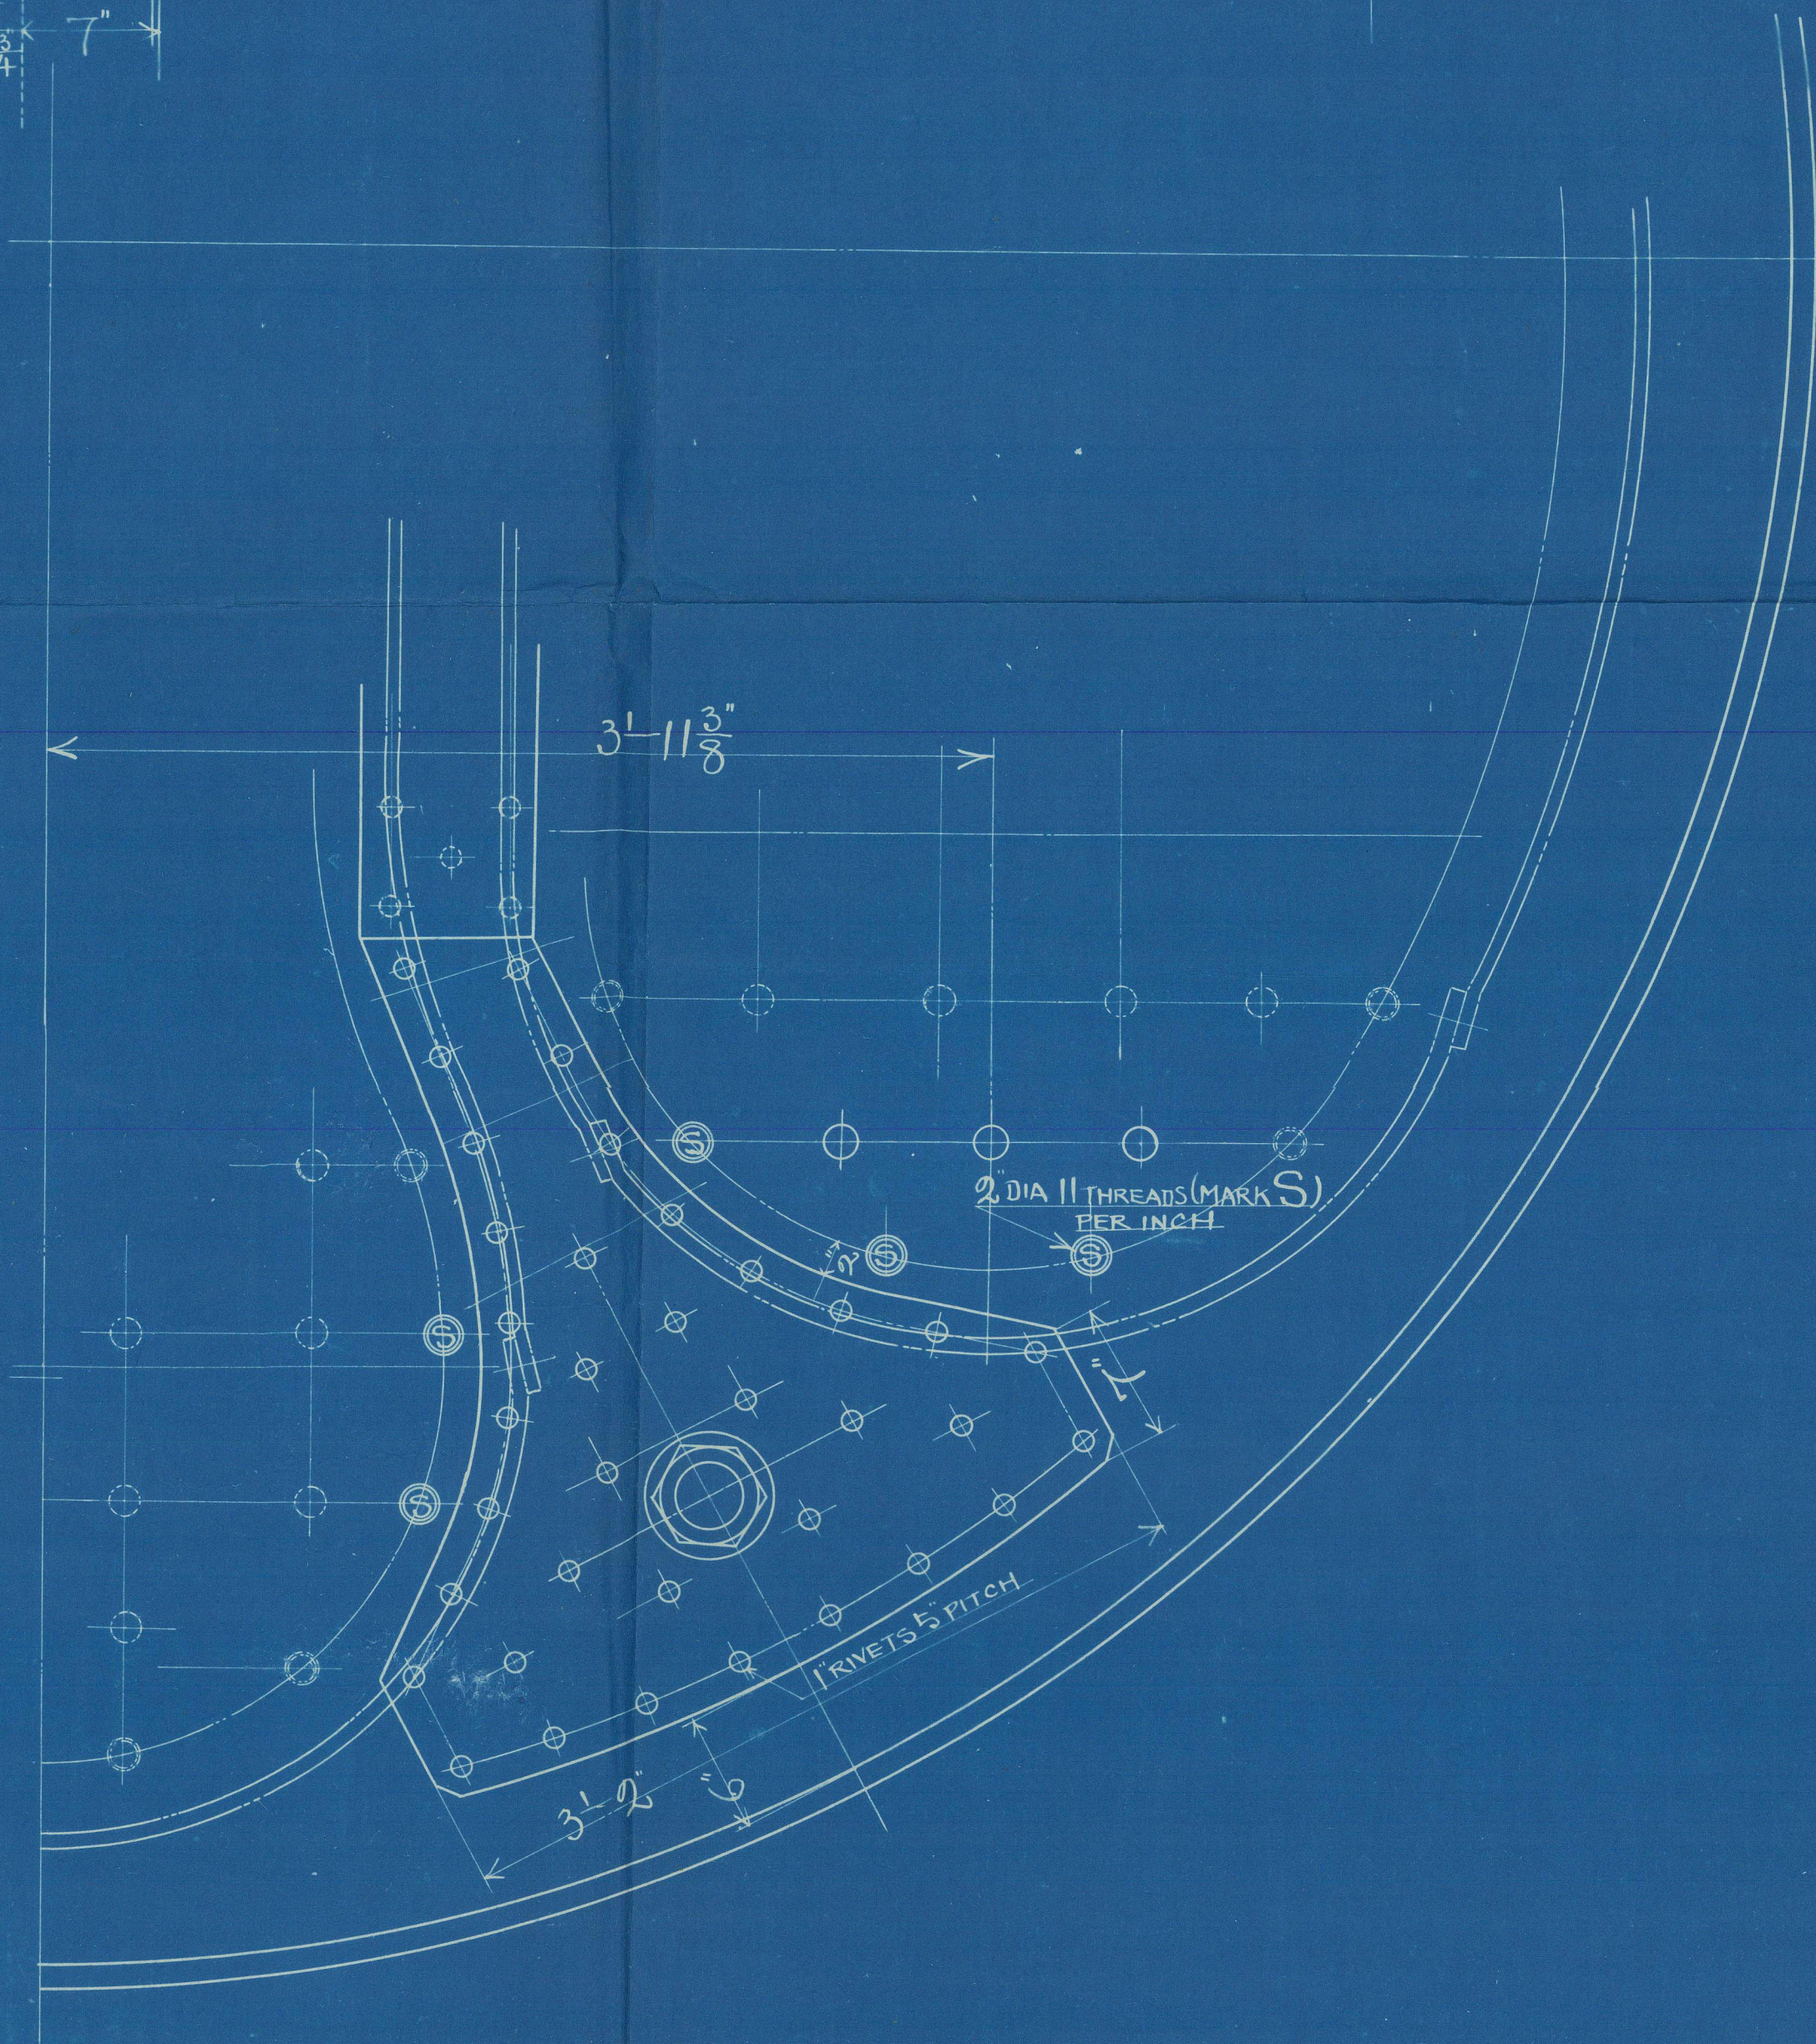


5800-7791M

STEEL BOILER FOR BUILDERS NO 371

ALTERNATION

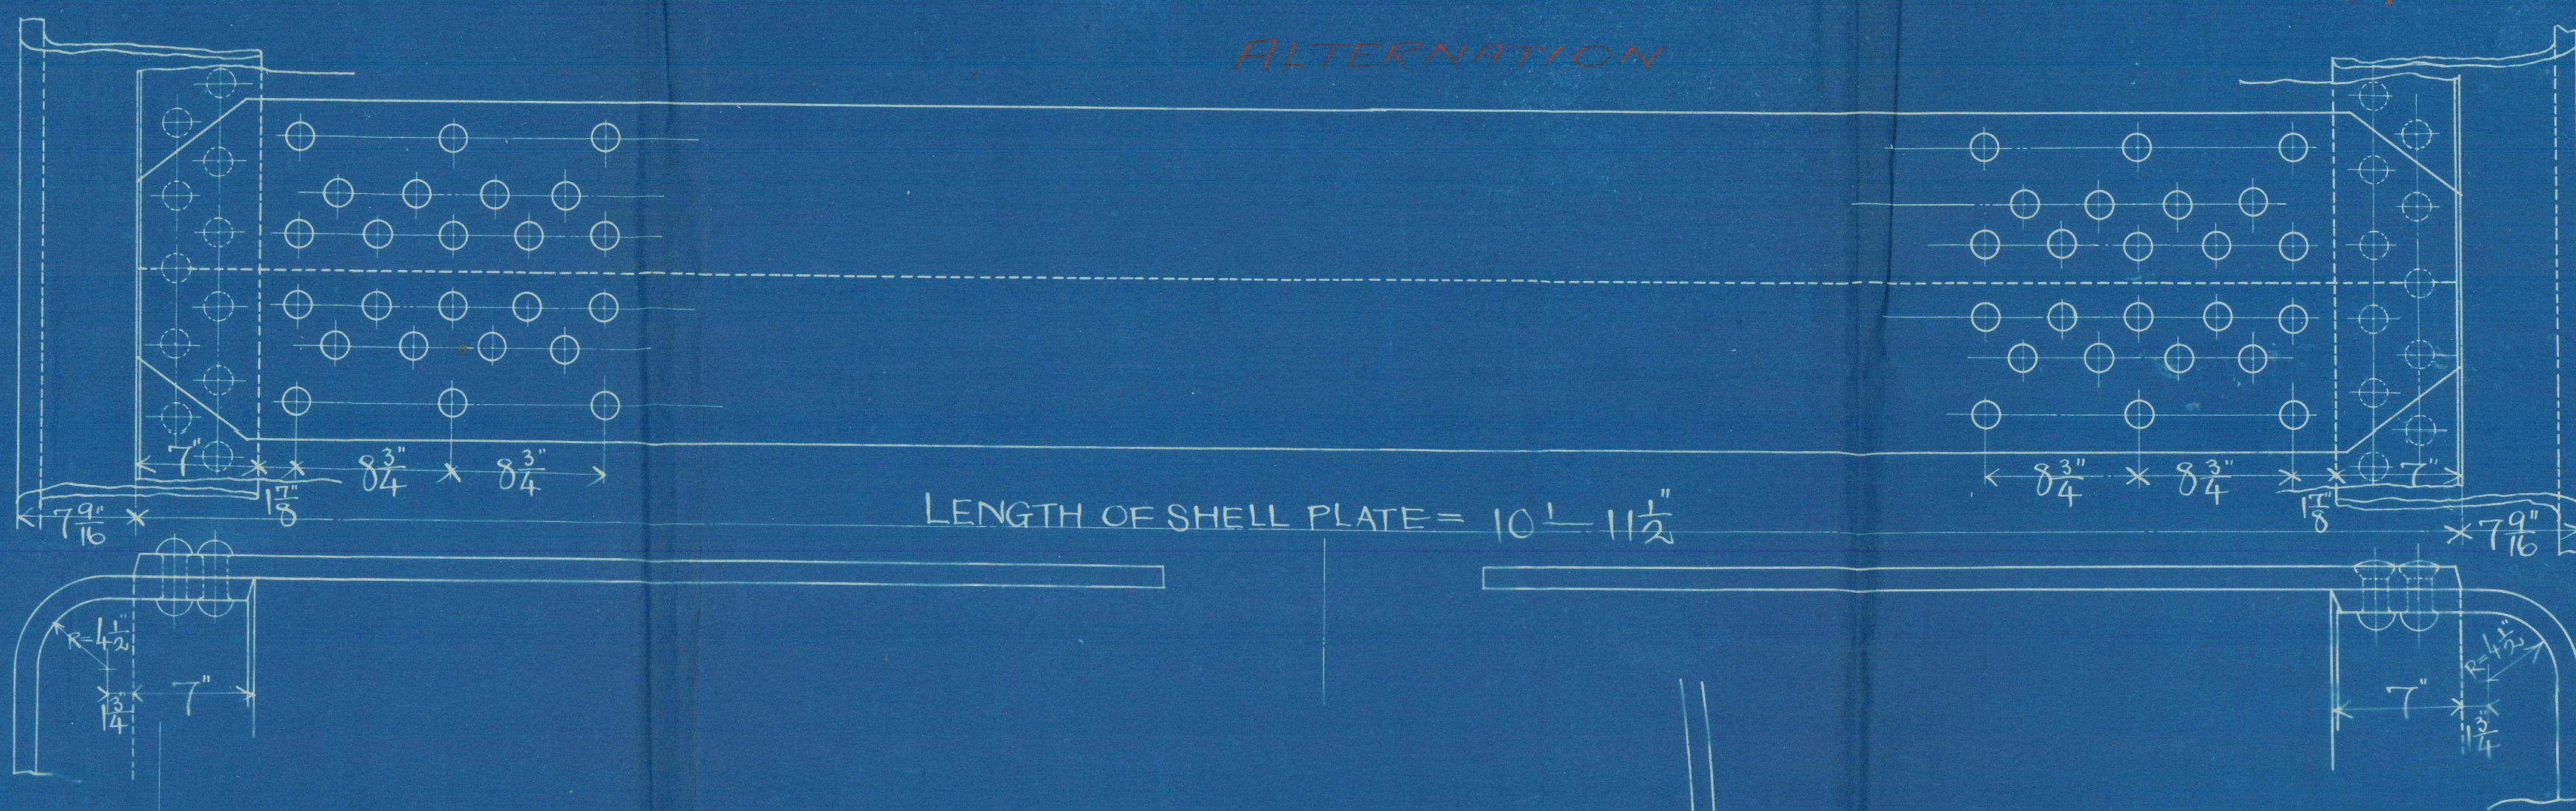

實線之ヶ所ヲ訂正ス

full line show correct parts

KAWASAKI DOCK YARD Co. Ltd.	
First Date for	21/04/1920
By	
Checked by	
Inspected by	
Approved by	
Drawn by	371
Doc.	41745

川崎
部長
係長
主任
製圖

Alteration in Porter's Shell

"
S.S. Stark's Marine"

Kobe 1601

DET A 111

DET A 111



© 2021

Lloyd's Register
Foundation

W1322-0085