

26.1.14


MIDSHIP SECTION STEEL SCREW TRAWLERS

N^{os} 598 & 599

DIMENSIONS 136'-8" B.P. x 23'-3" EXT. 13'-0" MLD.
SCALE 1/2" INCH.

TO CLASS 100 A.I. STEAM TRAWLER
DECK PLATED OVER IN WAY OF MACHINERY
CASING AS PREVIOUSLY APPROVED.

PLAN No. 3833
FOR ENCLOSURE TO
Messrs Lloyd's Surveyors
Hall FROM
COCHRANE & SONS, LTD.
SHIPBUILDERS, SELBY.
DATE 19/1/14

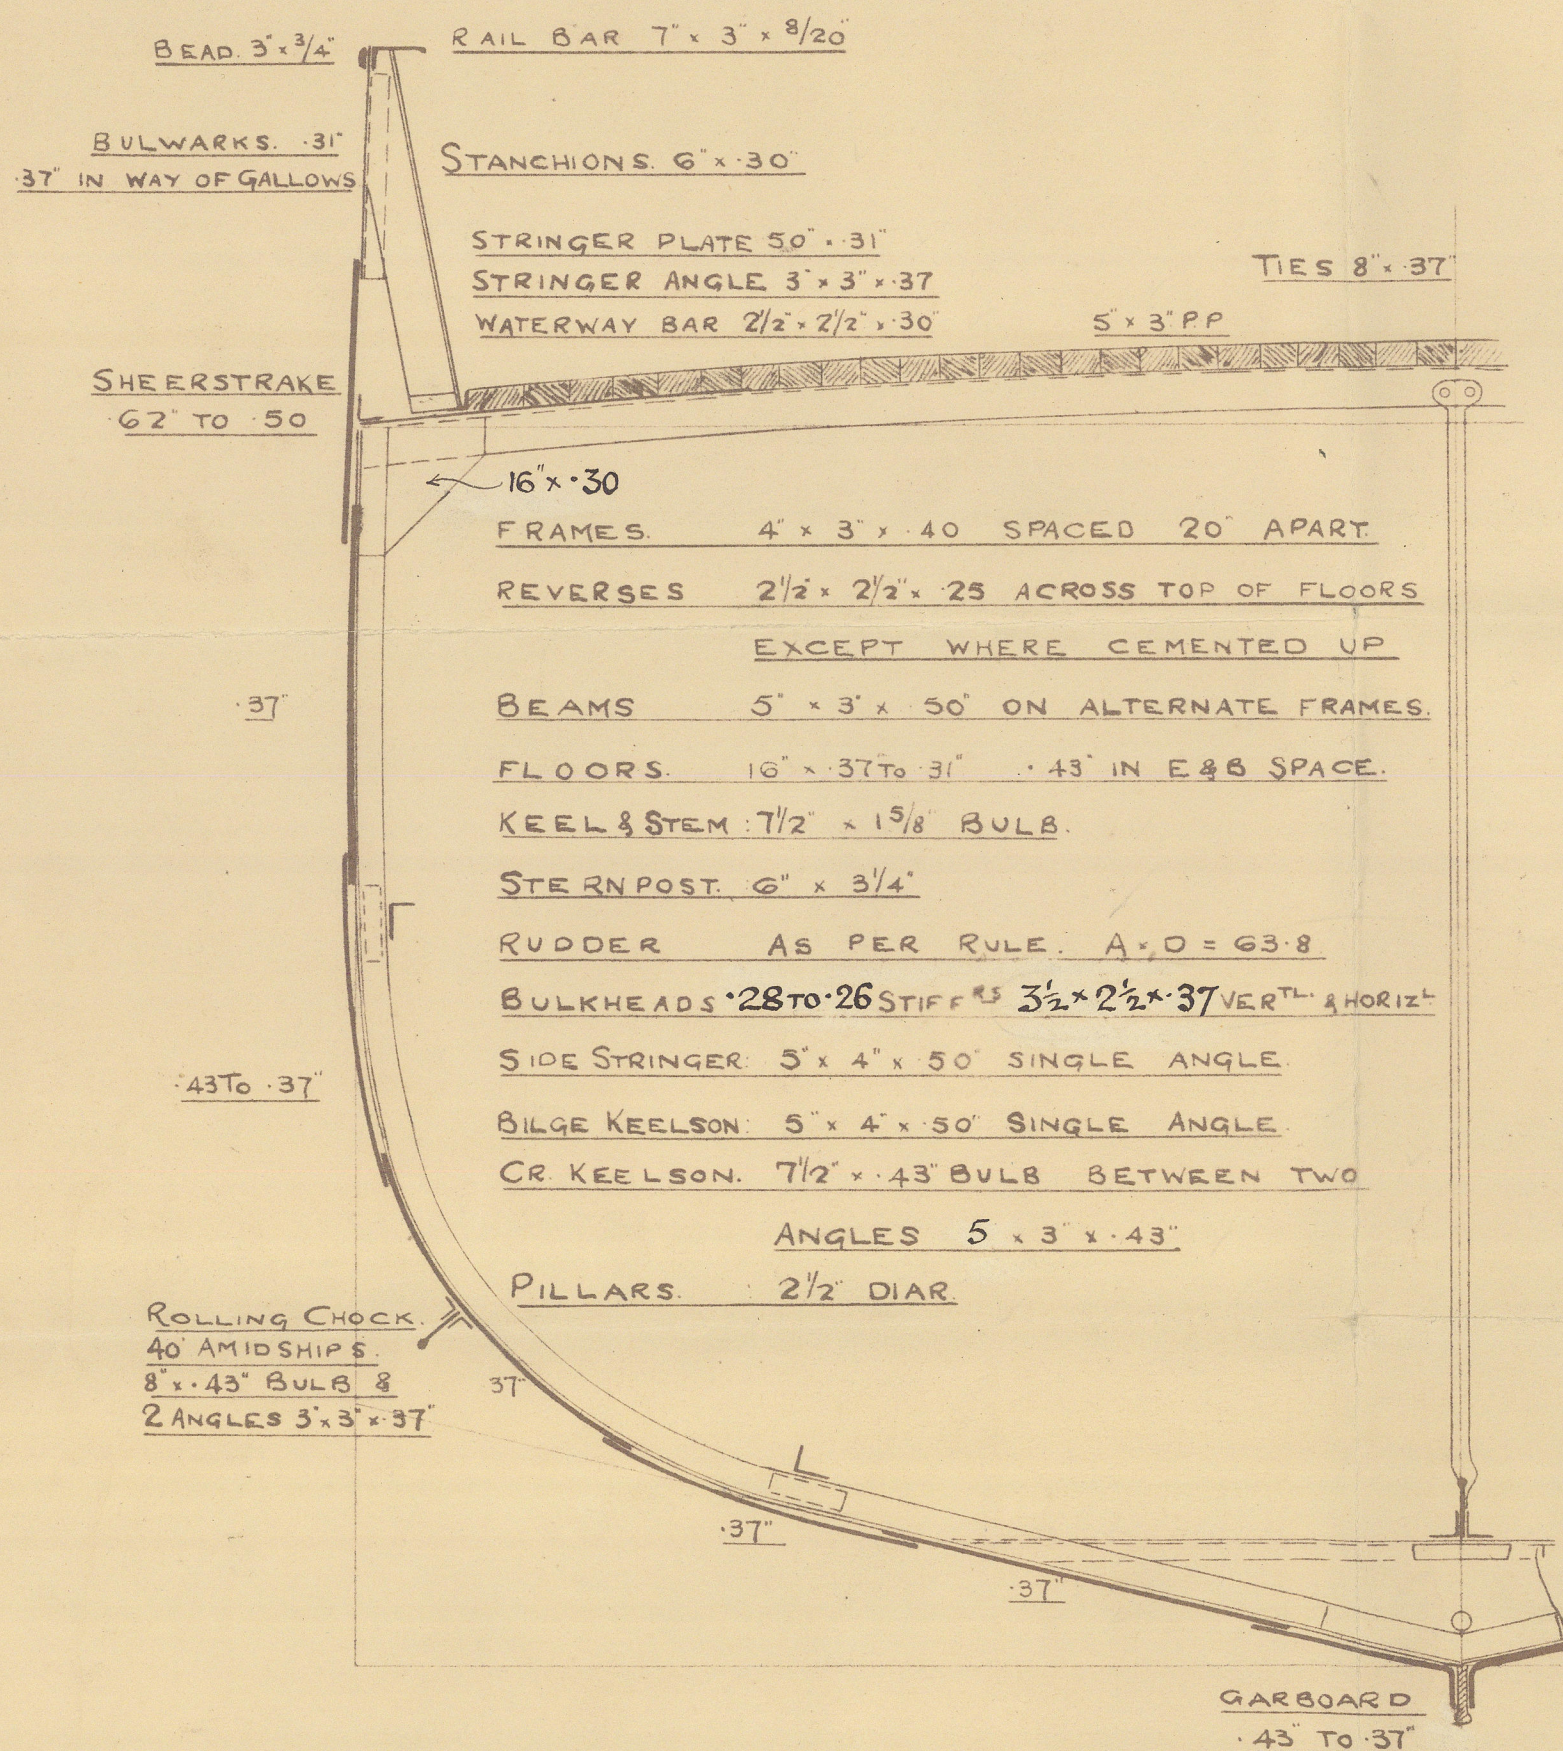

NUMERALS.

B + D 36.12
L x (B + D) 4936.15

PROPORTIONS.

L 10.51
D 5.91
B

EQUIPMENT.

1 ANCHOR 6 CWTs EX STOCK
1 " 5 1/2 " " "
1 " 3 " " "
120 FATHOMS 1/16" STUDLINK CABLE
60 " 6" HAWSER
60 " 5" WARP

RIVETING.

BUTTS OF SHELL PLATING OVERLAPPED AND
DOUBLE RIVETED EXCEPT GARBOARD & SHEERSTRAKE
WHICH ARE TO BE STRAPPED & DOUBLE RIVETED.
LANDINGS DOUBLE RIVETED
BULWARKS STRAPPED & SINGLE RIVETED.

afw
23-1-14

Cf.
26.1.14

Midship Section

Cochrane & Sons Ltd

- No 598 + 599 -

Dimensions

136.66 x 23.12 x 13.0

Duplicates of No 585 + 586

1/2 Admiral Braddock

Hull Report No. 24⁵⁴~~45~~4



1/3 Lord Minto
Hull Rpt No. 27585



Transferred to

Doctor Lee

Dis Bay 189



© 2021

Lloyd's Register
Foundation

W1325-0110



W1325-0110



© 2021

Lloyd's Register
Foundation