

26.1.14



PROFILE & DECK PLAN

Nos. 598 & 599

SCALE 1/4 INCH

DIMS 136'-8" x 23'-3" EXT x 13'-0" MLD

PLAN No. 3834
FOR ENCLOSURE TO
Messrs Lloyd's Surveyors
Hull
FROM
COCHRANE & CO. LTD.
SHIPBUILDERS, GLEBE,
DATE 19/1/14

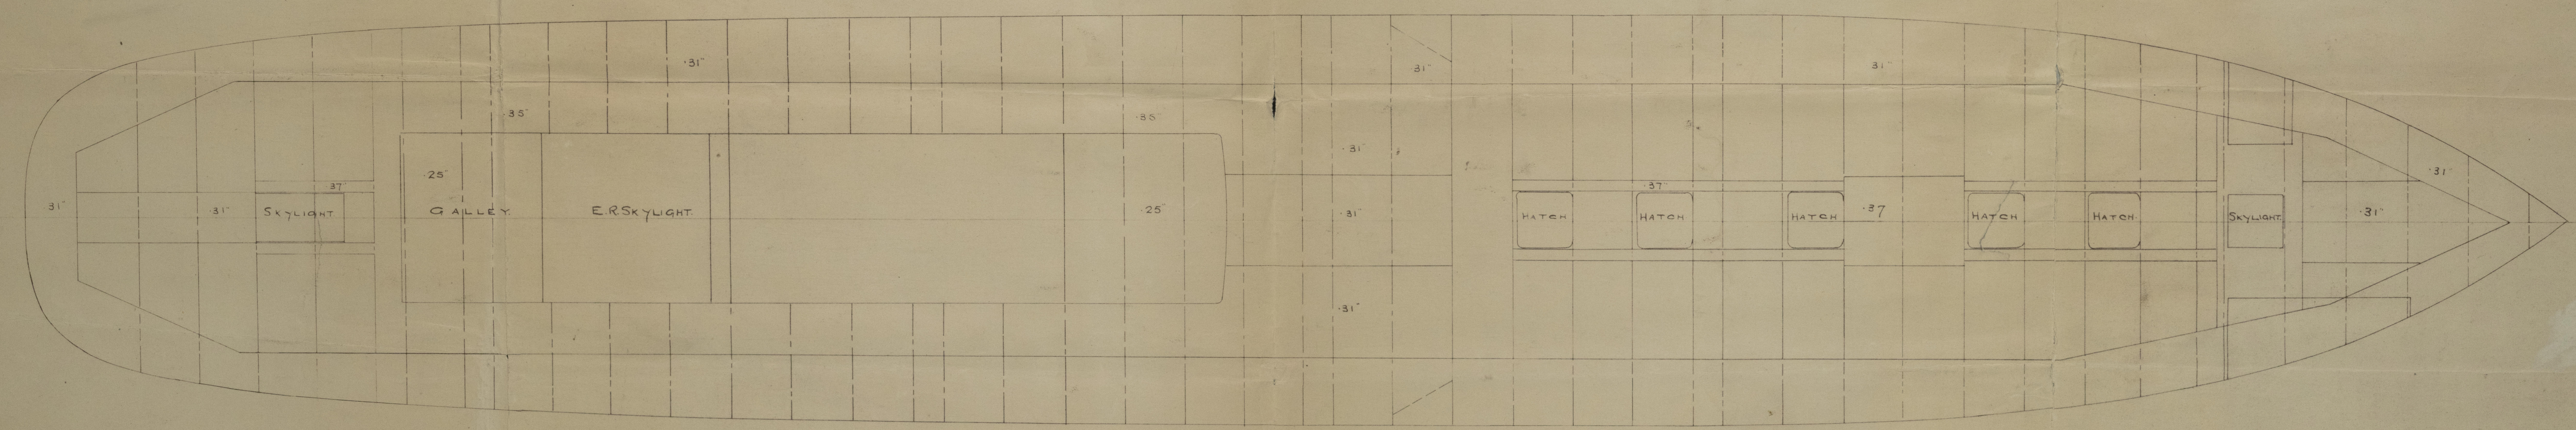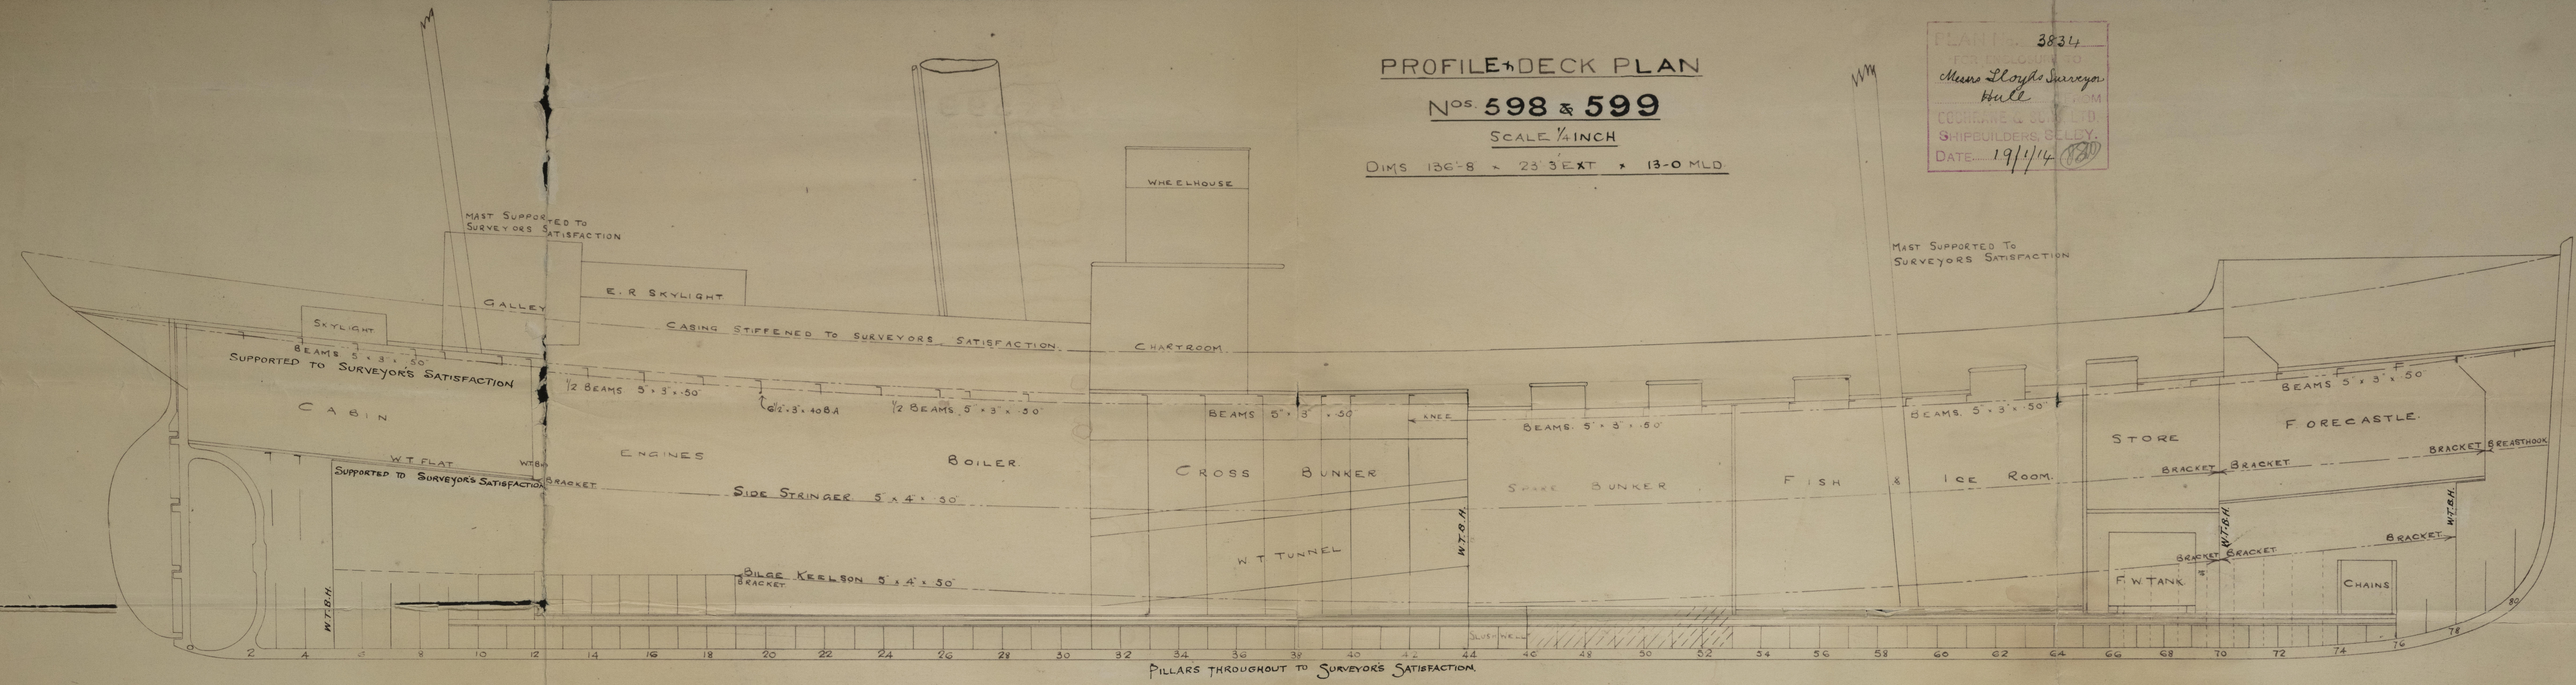

C.F.
26.1.14

Profile & Deck Plan

Cochrane & Sons Ltd.

- No. 598 + 599 -

Dimensions.

136.66 x 23.12 x 13-0

Duplicates of Nos 585 and 586.

By Admiral Braddock

Hull Report No. 27⁵⁴~~57~~

Transferred to
Doctor Lee
Dis Bay 189




By Lord Minto
Hull Rpt No. 27585




© 2021

Lloyd's Register
Foundation

W1325 + 0111

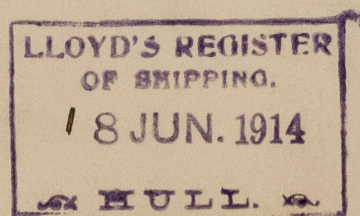

W1325-011

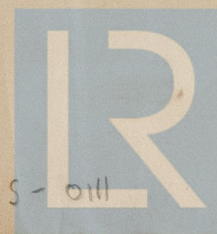

© 2021

Lloyd's Register
Foundation

LLOYD'S REGISTER
OF SHIPPING
23 JAN. 14
HULL



© 2021

Lloyd's Register
Foundation