

11.7.13


MIDSHIP SECTION STEEL SCREW TRAWLERS

Nos 585-586

DIMENSIONS: 136'-8" B.P. x 23'-3" EXT. 13'-0" MLD.
SCALE 1/2 INCH.

TO CLASS 100 A.I. STEAM TRAWLER.
DECK PLATED OVER IN WAY OF MACHINERY
CASING AS PREVIOUSLY APPROVED.

PLAN No. 4124
FOR ENCLOSURE TO
Messrs. Lloyd's Surveyors
Hull FROM
Messrs. G & SONS, LTD.
27/3/14

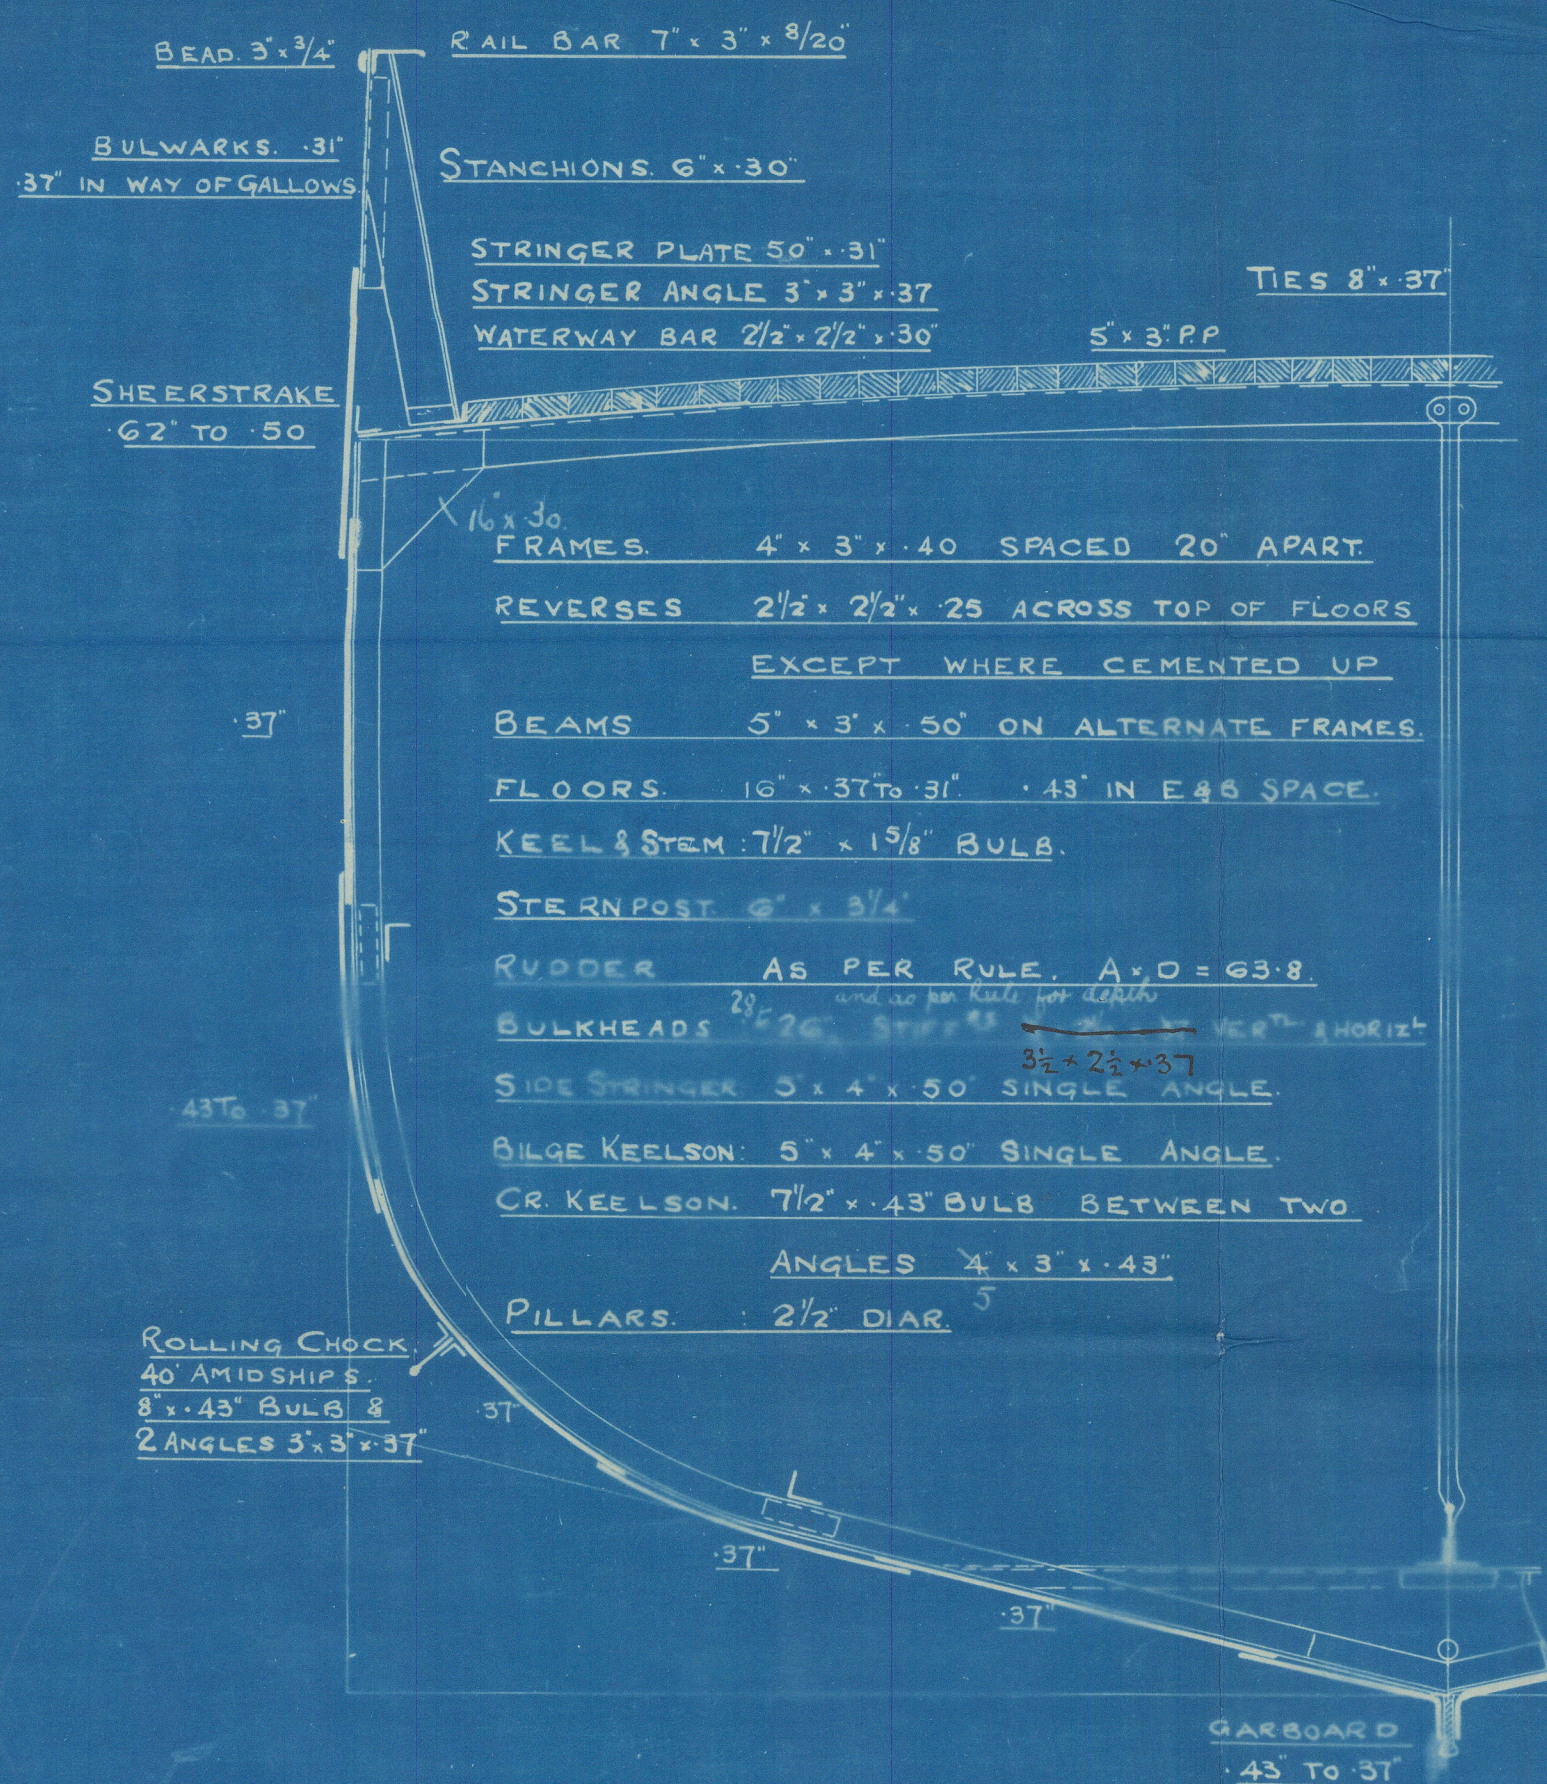

NUMERALS.

B + D ----- = 36.12
L x (B + D) ----- = 4936.15

PROPORTIONS.

L ----- 10.51
D -----
L ----- 5.91
B -----

EQUIPMENT.

1 ANCHOR ----- 6 CWTs EX STOCK
1 " ----- 5 1/2 " " "
1 " ----- 3 " " "
120 FATHOMS ----- 1 1/2" STUOLINK CABLE
60 " ----- 6" HAWSER.
60 " ----- 5" WARP.

RIVETING.

BUTTS OF SHELL PLATING OVERLAPPED AND DOUBLE RIVETED EXCEPT GARBOARD & SHEER STRAKE WHICH ARE TO BE STRAPPED & DOUBLE RIVETED.
LANDINGS DOUBLE RIVETED.
BULWARKS STRAPPED & SINGLE RIVETED.

Jw.
11.7.13


Cochrane & Sons. Ltd.

N^o 576, 580, 585 + ~~586~~

^{Duplicate}
Midship Section

s/s Doctor Lee

Hull Rpt No. 27373

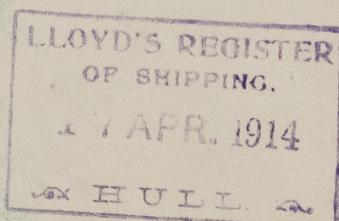

© 2021

Lloyd's Register
Foundation


W1325-0112