

from analysis
of the 2 blocks in the
I

Cochrane & Sons. Ltd.


~~Nos 576-580.~~ 585 ~~586~~

Duplicate
Profile & Decks

% Doctor Lee
Hull Rpt No. 27373.

RETAIN

RETAIN

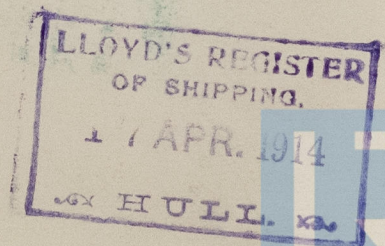

Page 1 of 4

© 2021

Lloyd's Register
Foundation

W1325-0113