

No. 412.

# PROFILE & DECK PLAN.


Dimensions :- 60'-0" x 18'-0" x 9'-3" Mid.

Scale : 1/4" = 1 ft.



To class A + at LLOYDS for Canal Service.

## NOTE.

The scantlings & Details of Construction noted hereon are Submitted on the understanding that they are the minimum which will be accepted for class. If not they are to be amended. Errors and Omissions excepted.

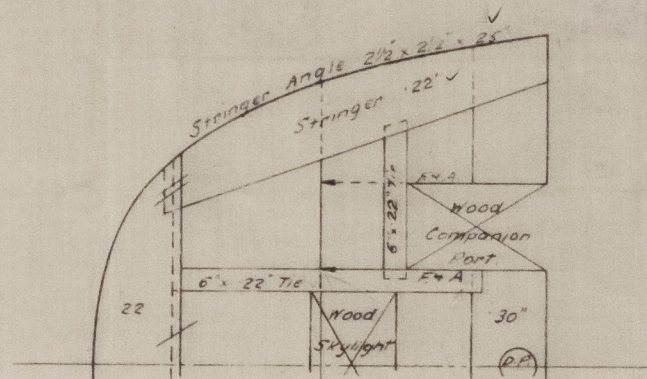

Poop Deck.

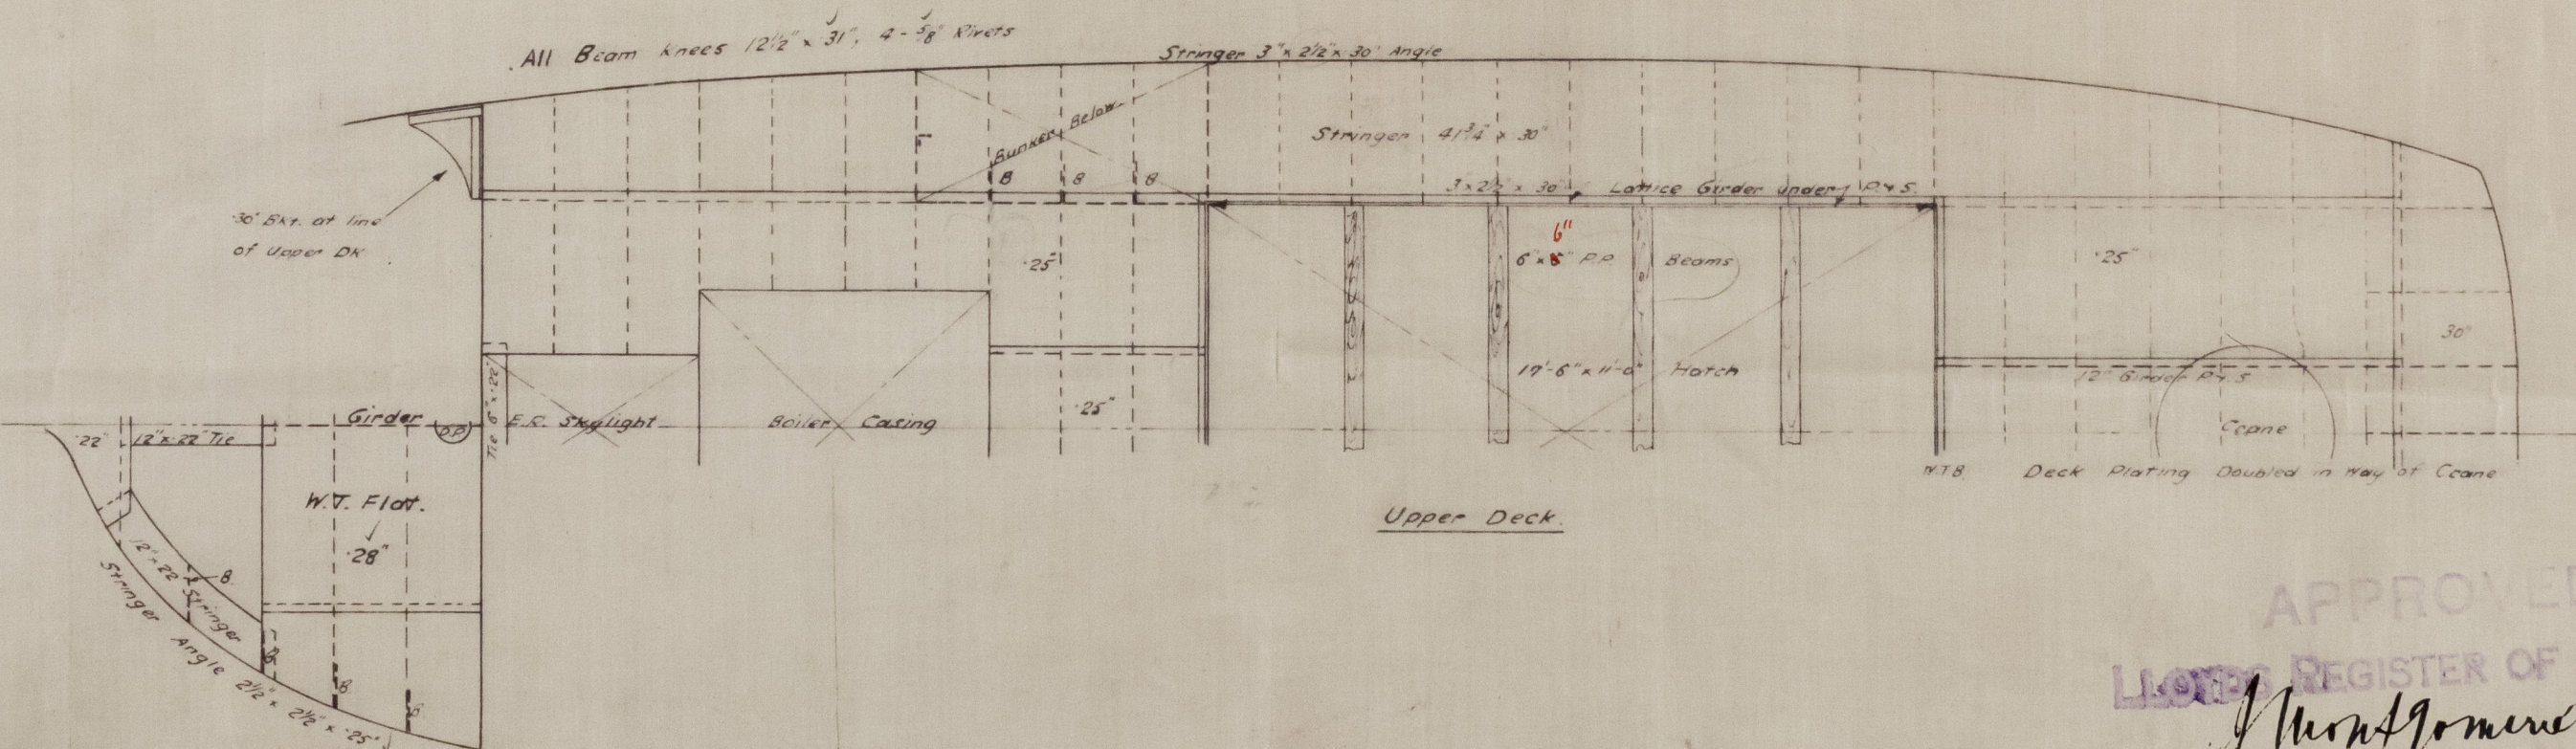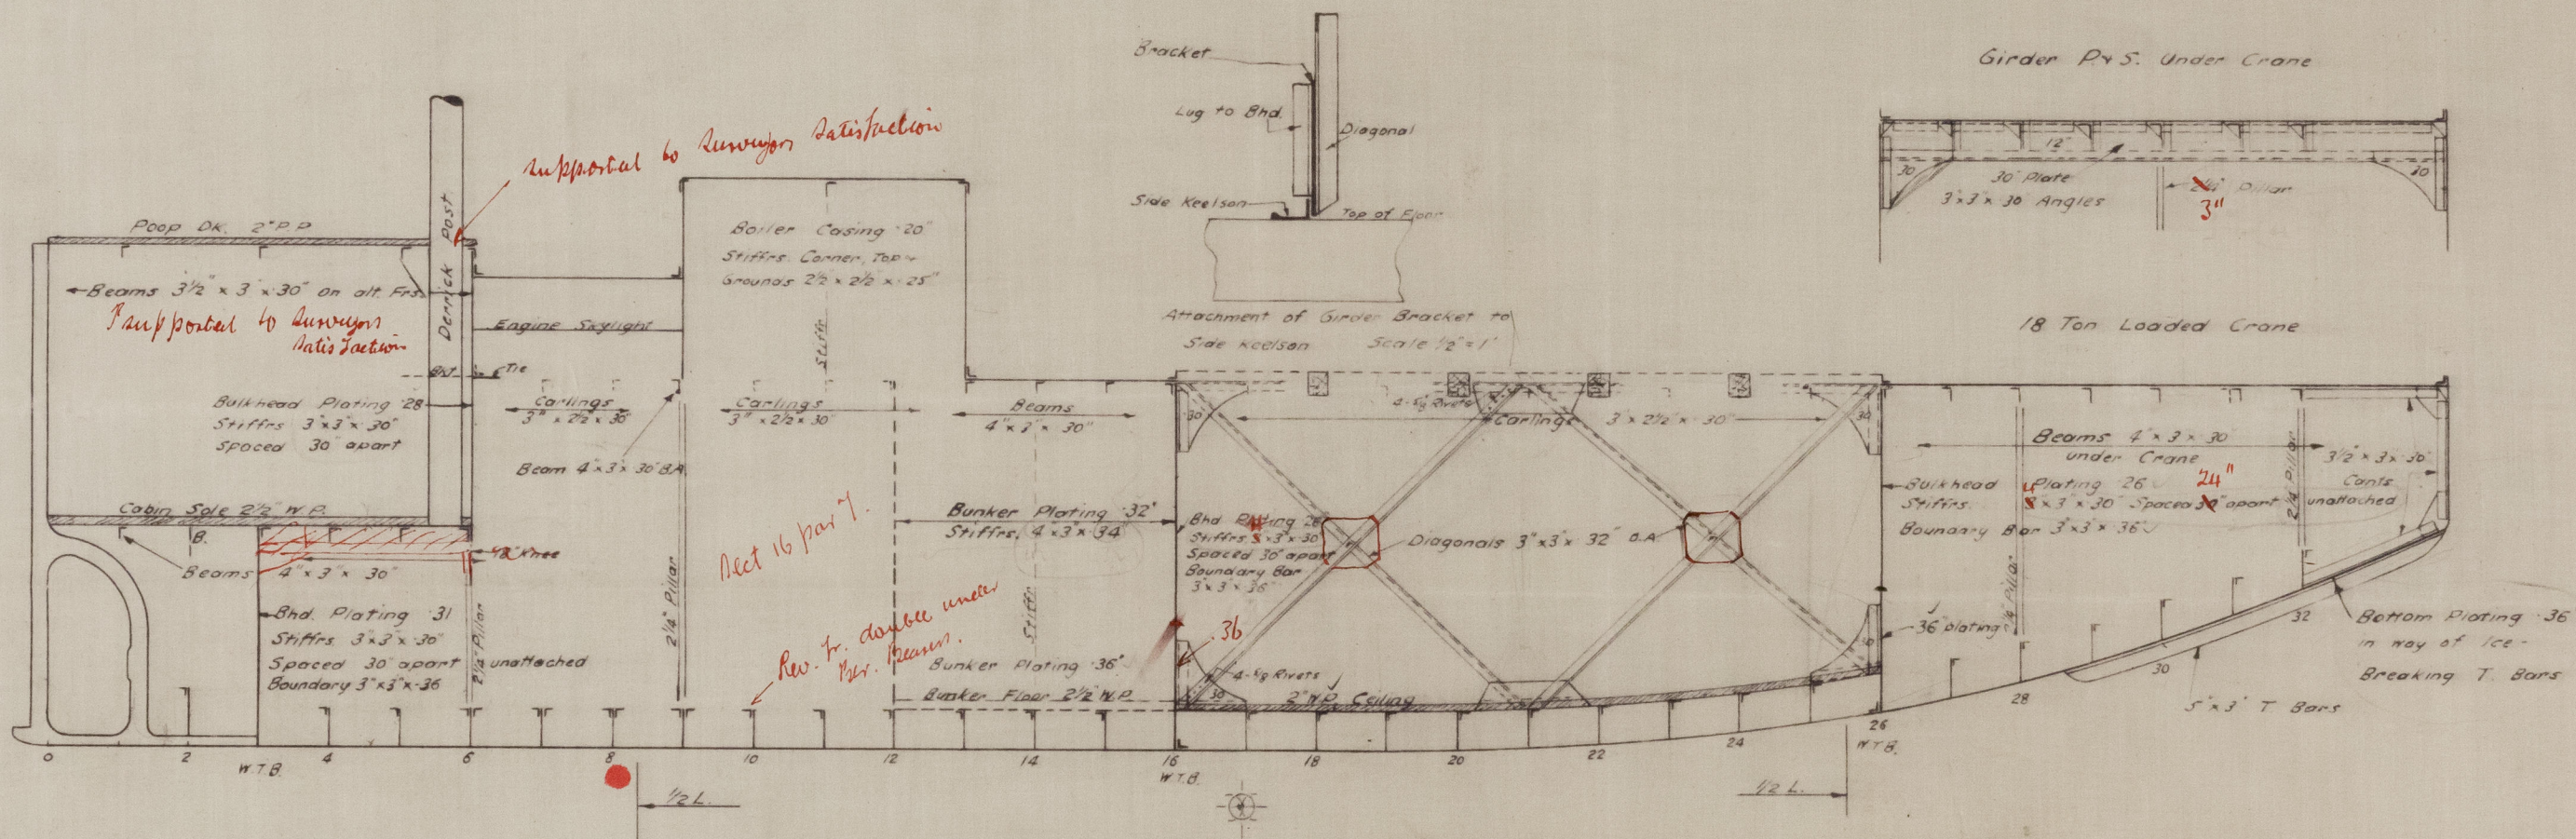

Upper Deck.

Cabin Sole.

Frames cut & braced in way of W.T. Flat.

APPROVED  
LLOYD'S REGISTER OF SHIPPING

*Montgomery*

1.2.26


© 2024



Lloyd's Register  
Foundation

W1325-0237



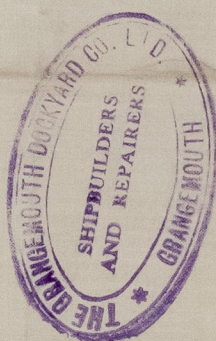

*Grangemouth Ship Co.*

*No. 412.*

*Profile & Deck Plan*

*"Glydeforth"*

GLASGOW REPORT No. 45760

W1325-0237



© 2021

Lloyd's Register  
Foundation