




№ 452

SHAFT
ARRANGEMENT

SCALE 1 : 96

DR. № S-1

完成圖

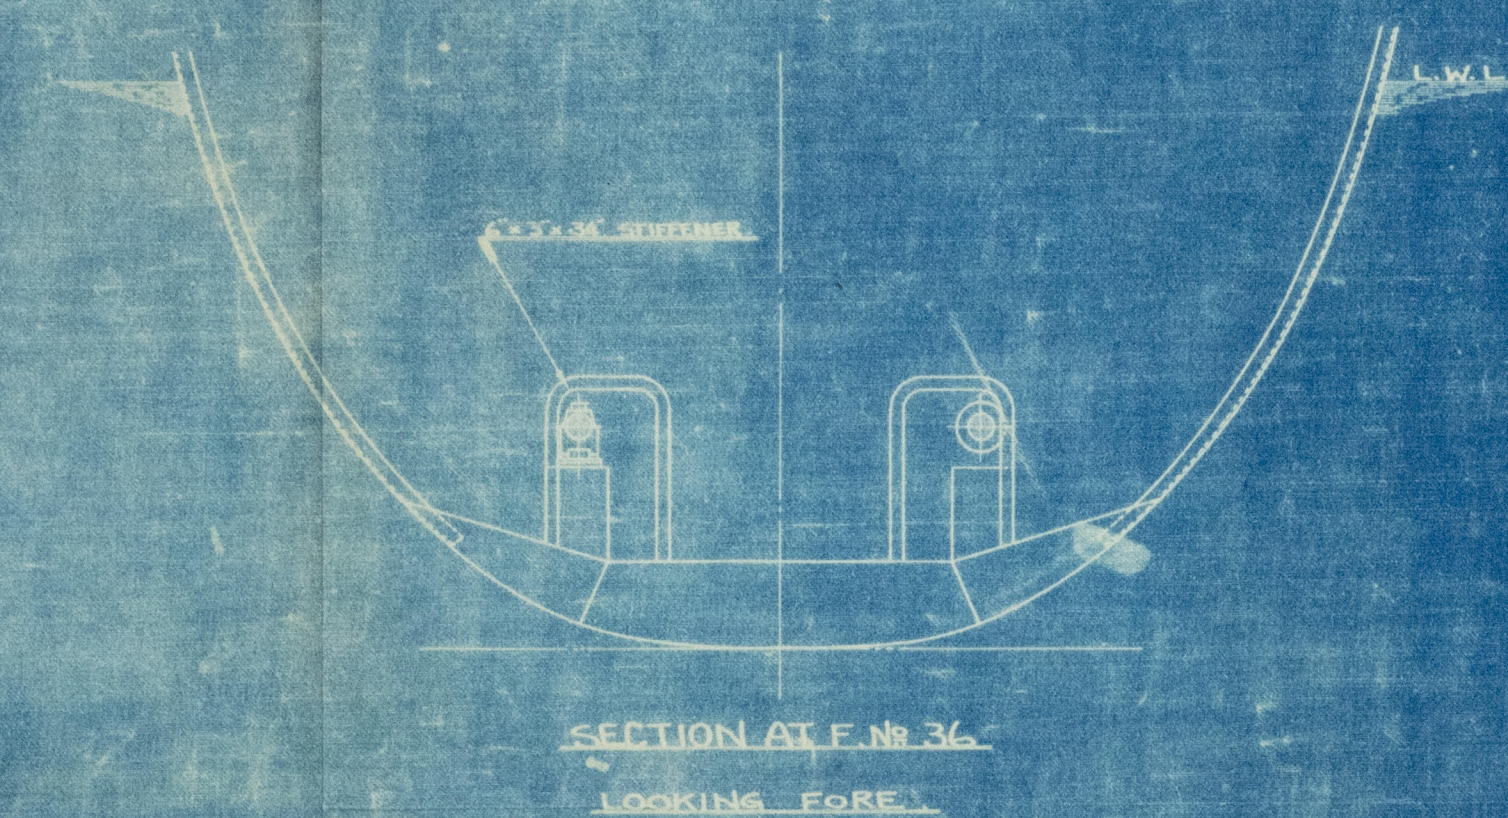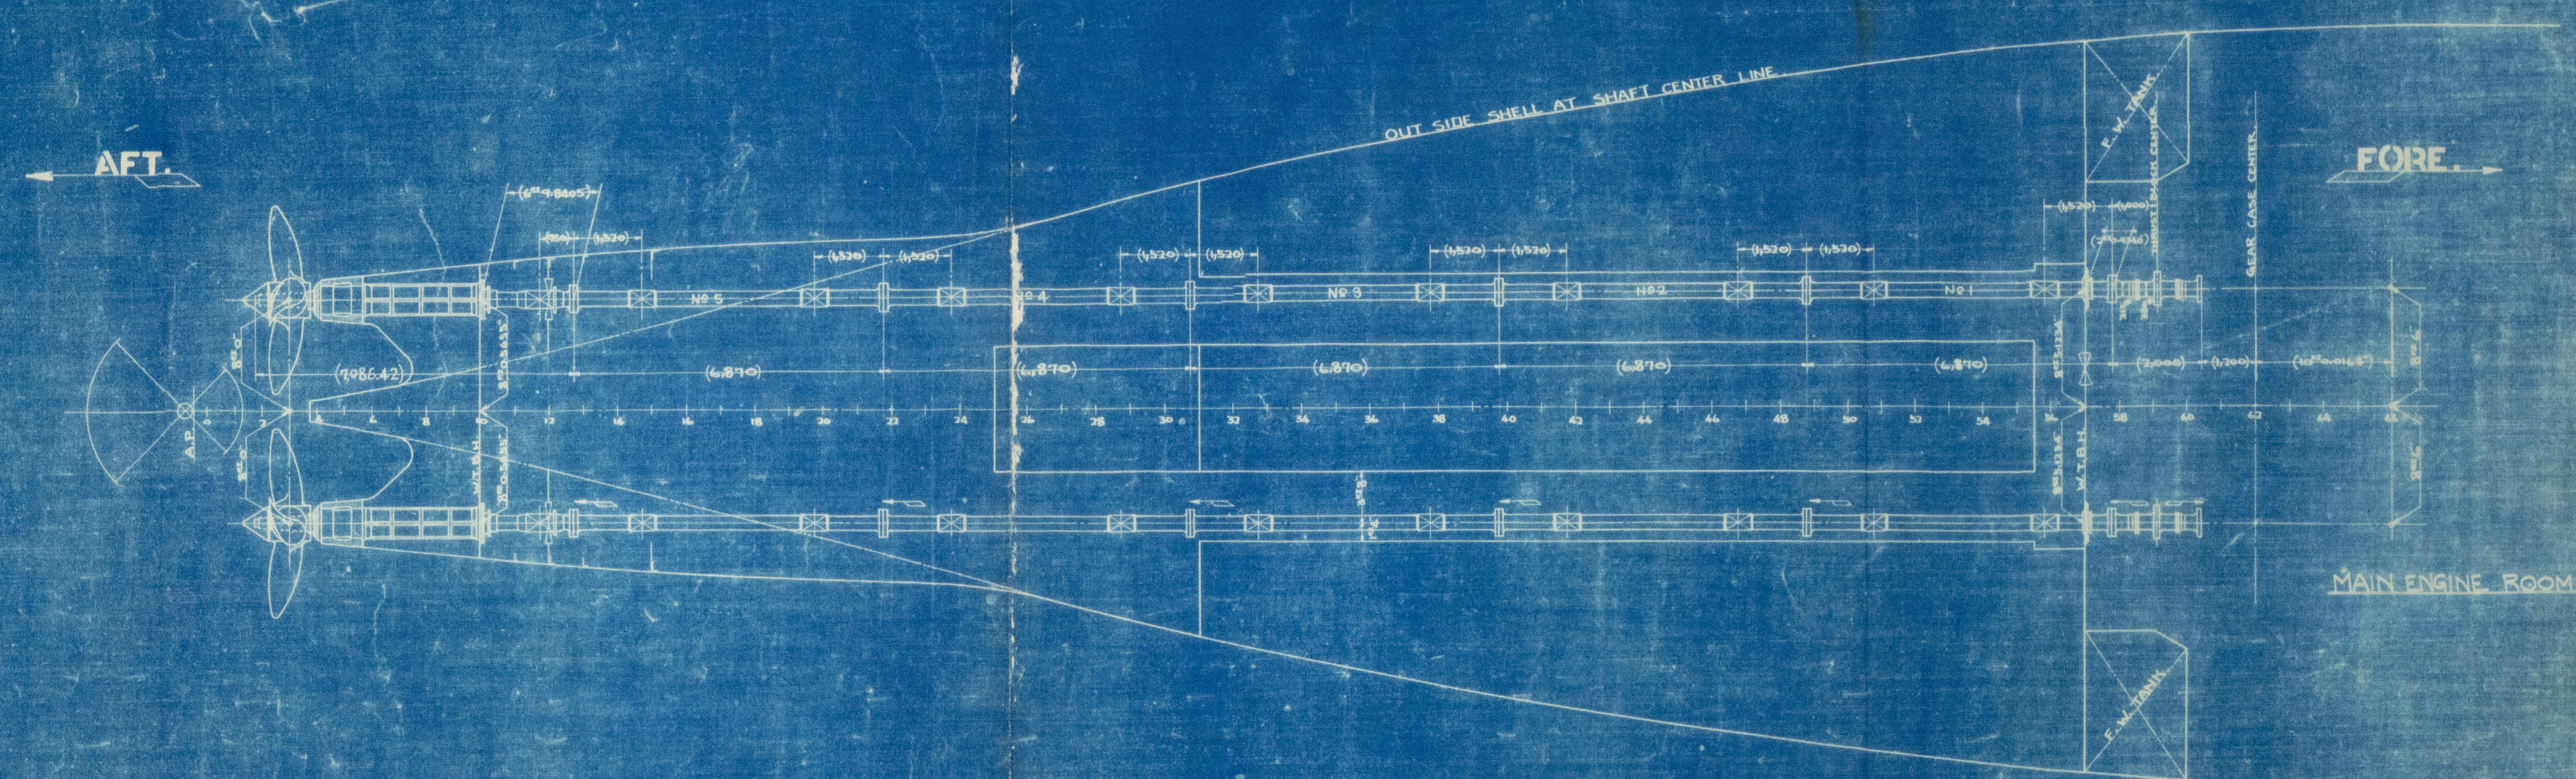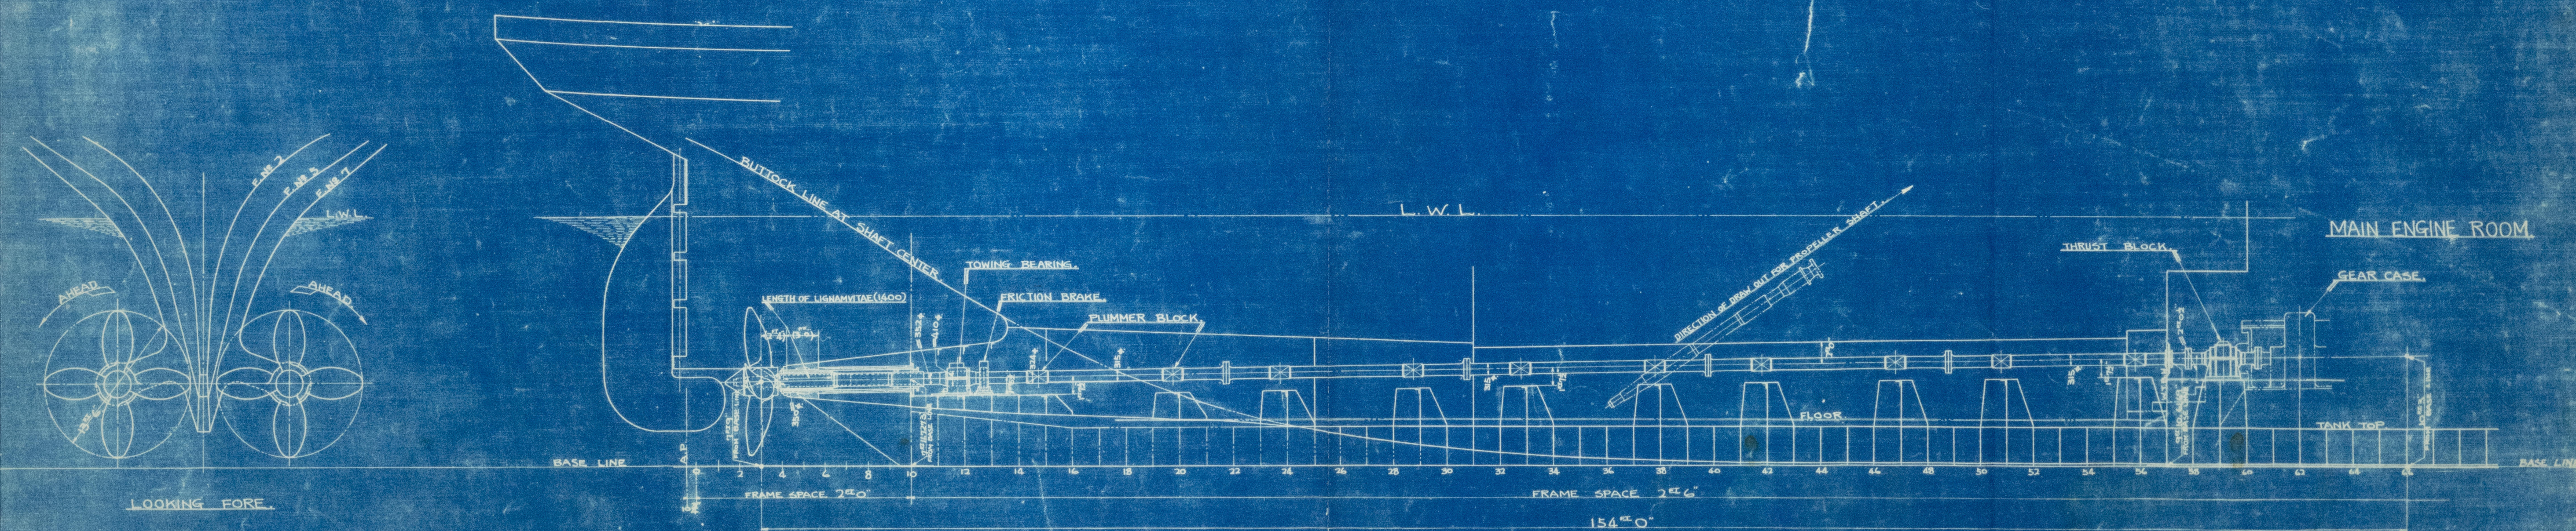

VERTICAL RAKE OF SHAFT = 0.1948052' PER FOOT.
 HORIZONTAL RAKE OF SHAFT = 0.0389610' PER FOOT.
 FULL RAKE OF SHAFT = 0.1986631' PER FOOT.
 REAL OVER ALL LENGTH ON SHAFT CENTER LINE BETWEEN CENTER
 OF PROPELLER AND F. № 66 = 1848.7533' OR = 154' 0.2533"
 RATIO OF SHAFT LENGTH DIVIDED BY BASE LENGTH = 1.00013703.

Nº 452

SHAFT
ARRANGEMENT

SCALE 1 : 96

DR. Nº S-1

完成圖



W1327-0029

© 2021

Lloyd's Register
Foundation