

Nº 903 S.S. SEKKOW MARU

MIDSHIP SECTION


SCALE $\frac{1}{2}$ IN. TO ONE FT.

LENGTH	B. P.	305'-0"
BREADTH	MLD.	43'-9"
DEPTH	MLD.	27'-3"

LLOYD'S NUMERALS.

BREADTH	43.75	
DEPTH	27.25	
LENGTH	71.00	1ST. NUMBER
	305.00	
	21655.00	2ND NUMBER

L/D TO UPPER DECK	11.20
L/D TO BRIDGE DECK	8.90

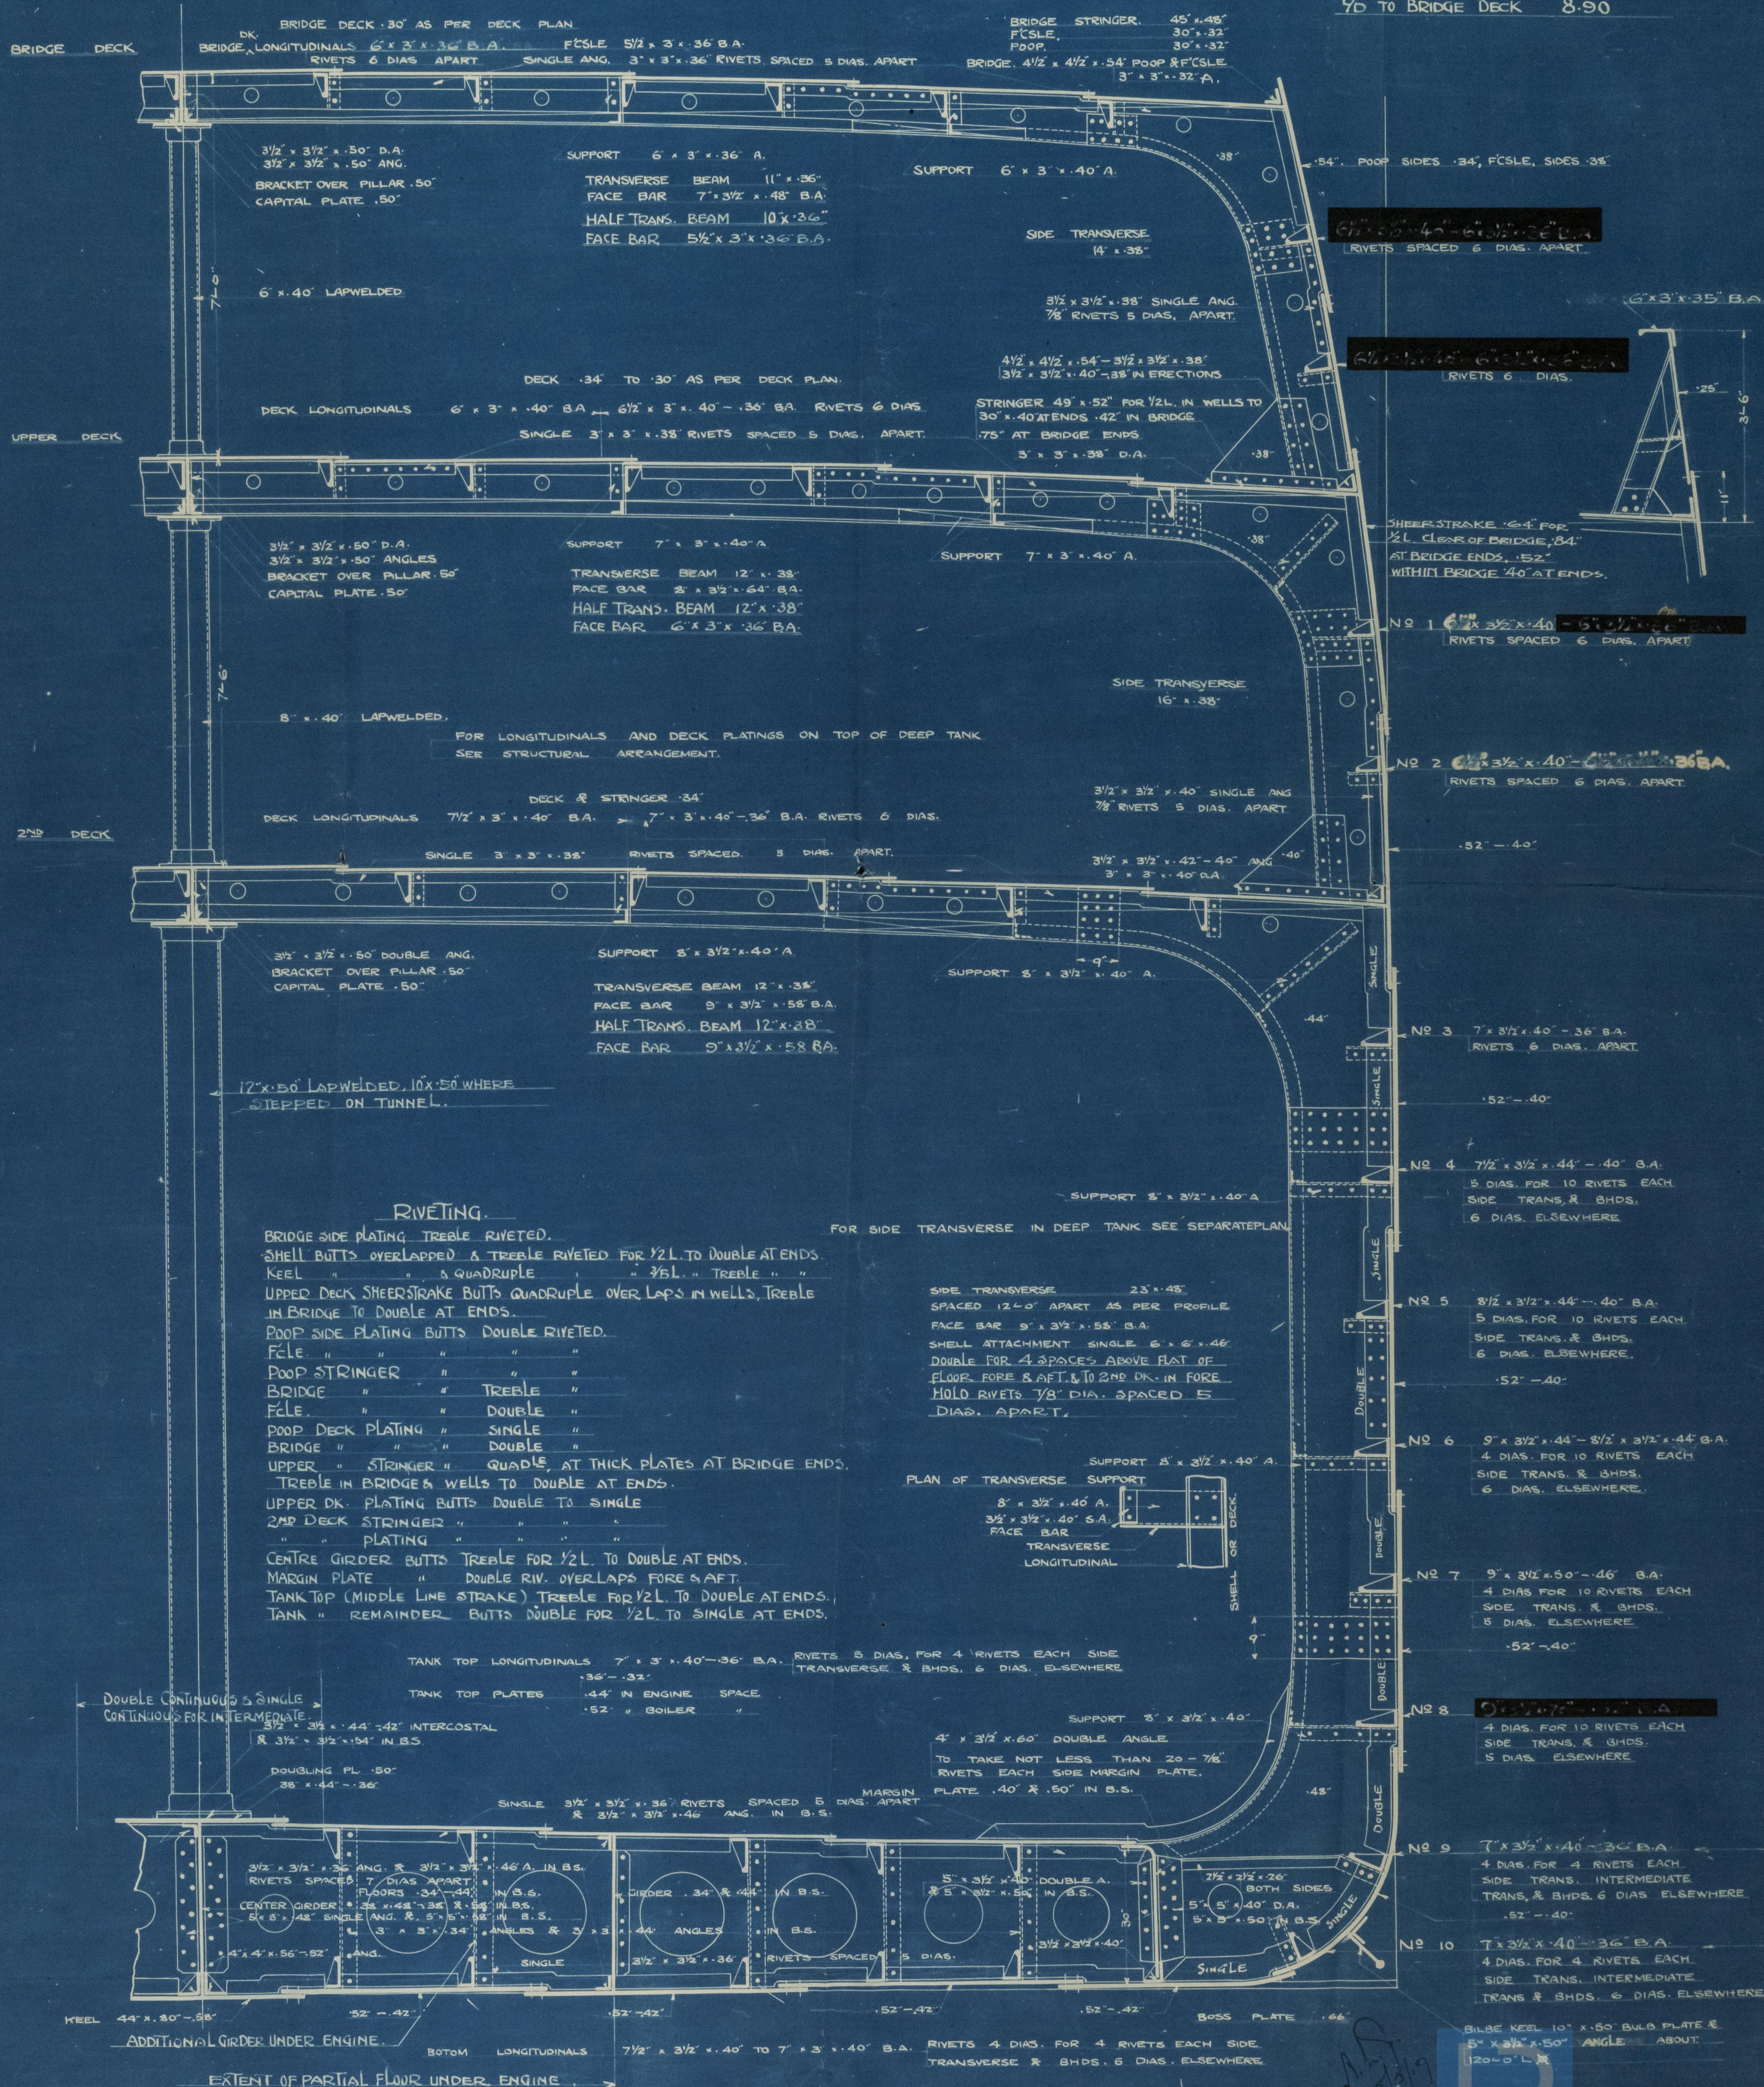

S/S^r Sek Kow Marn

O. I. Wks. No 903 73

Robt Rpt No 2024

Midship Section



© 2021

Lloyd's Register
Foundation

W1327-0134