

BEAM ARRANGEMENT

PILLARING THROUGHOUT TO SURVEYORS SATISFACTION.


SCALE 1/4" = 1 FT.

N^o 144 & 6.

DATE SUBMITTED AUG. 29th 1912.

APPROVED

COOK WELTON & GENHELLIO
SHIP BUILDERS
BEVERLEY

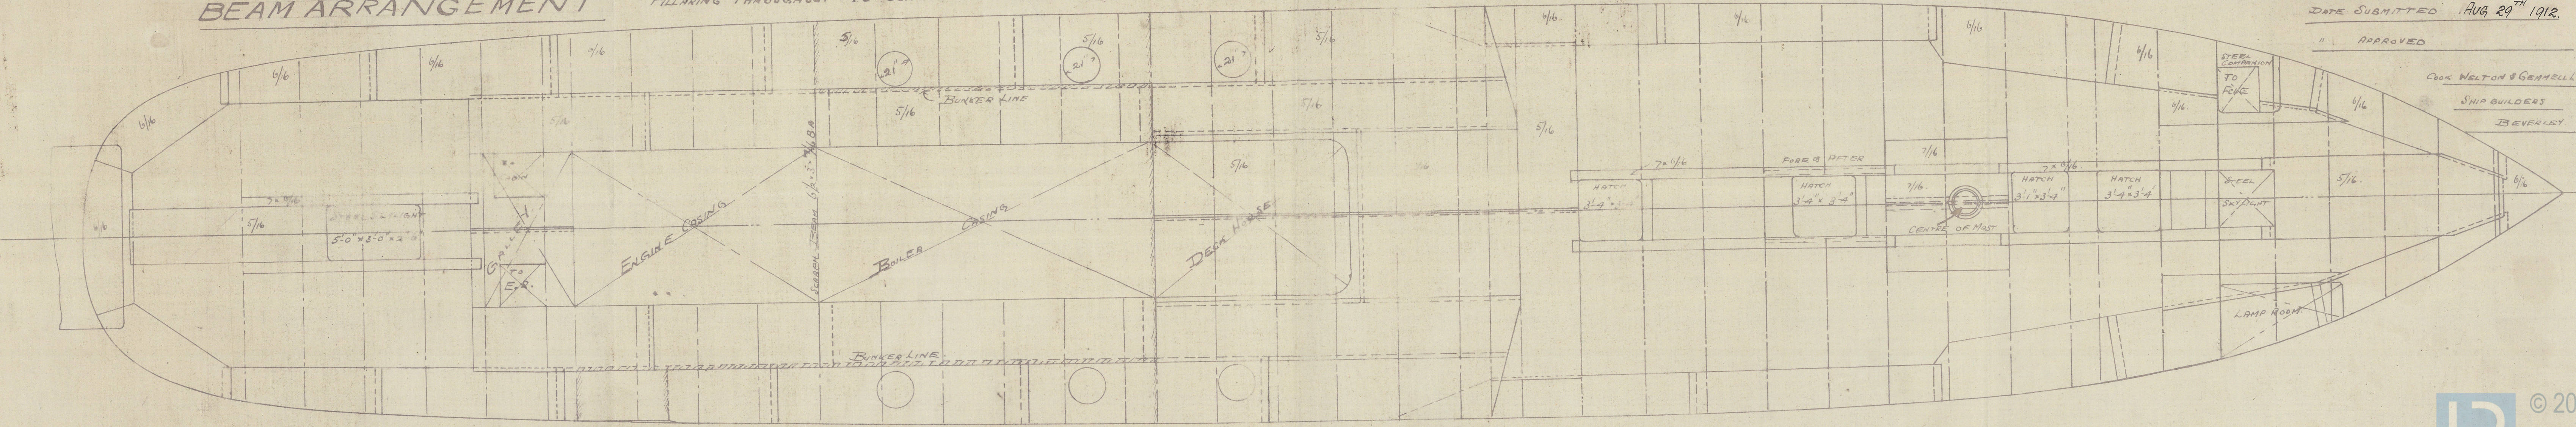

Cook, Welton & Gemmelle
No. 146

Copy of
Profile & Deck

s/s Sargon
Hull Rpt No. 26389

W1327-0151



© 2021

Lloyd's Register
Foundation