



Longitudinal Section.


5 5 10 95.

Scale 1/8" inch = 1 foot.

Note: If any scantling, strengthening etc., which we have herein submitted be in excess of your minimum requirements, kindly amend same.


Plating: Steel 66 feet long
18" x 30" at partners
14" x 25" heel
15" x 25" rounds
12" x 25" head
Lappings 3"
Lapped both str. & 24 below partners
doubled for 12 feet at partners and 1' 6" at heel.

Deck 25 steel and 24 p.s.
7 1/2" x 8" x 1/2" A
beams
under 45 in. 6 1/2" x 5" x 1/2" A
" 2" x 5" x 1/2" A

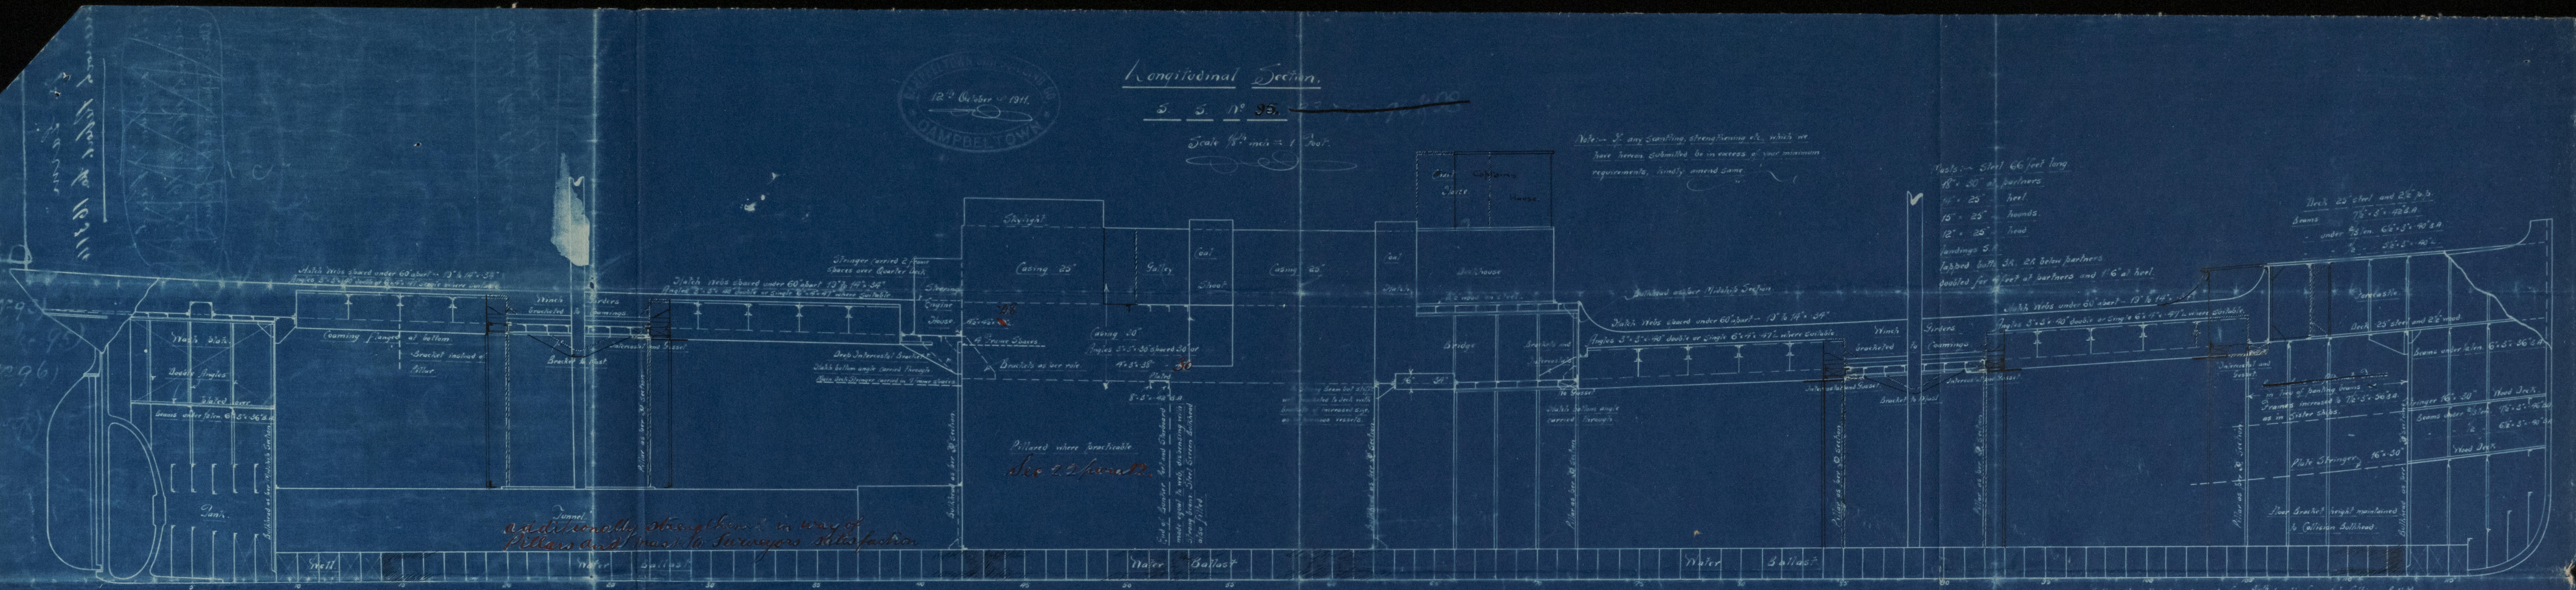

additionally strengthened in way of Pillars and near to forewings satisfaction

Pillars where braceable see 22 forward

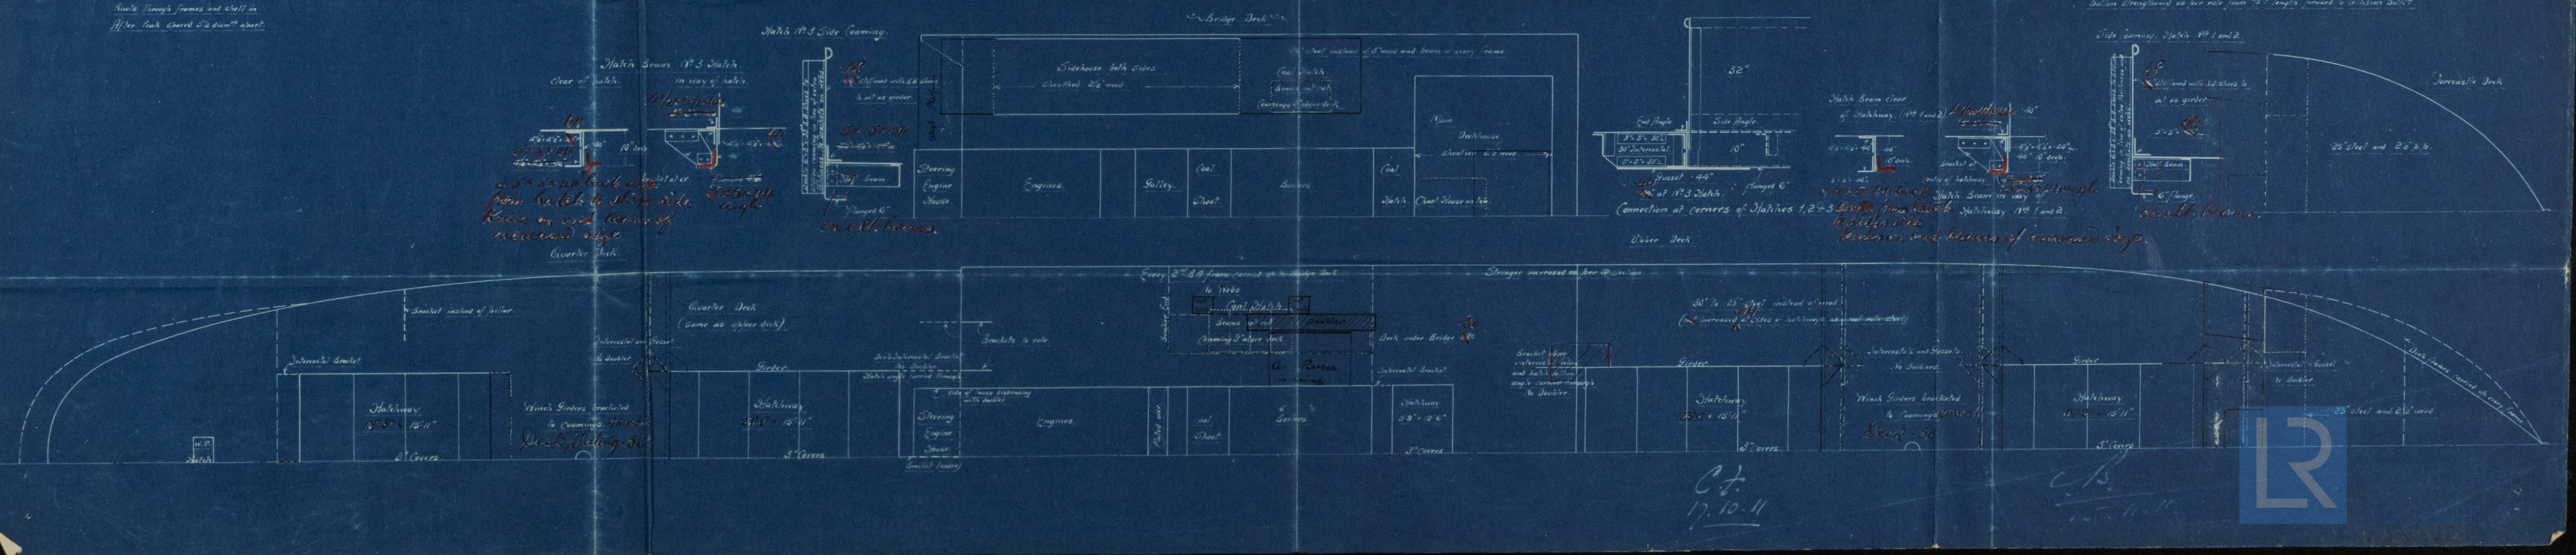

4 5" x 10" x 1/2" A
from hatch to ship side
keels on end beams of
increased size
Quarter Deck

on all beams

4 5" x 10" x 1/2" A
from hatch to
hull side
Keelson and beams of increased size

on all beams

Ct.
17.10.11

Ct.
17.10.11



Lloyd's Register
Foundation

S.S. no 95

~~Profile sheets~~

S.S. "Kamo" now "RYUWA MARU"

Glenock Report no.

16490

D. 186



© 2021

Lloyd's Register
Foundation

W1321-0252