

NO 317 S.S. PASSENGER & CARGO STEAMER. CONSTRUCTION PLAN.

SCALE 3/8" TO ONE FOOT


W.T. 8-14
original


NO 317

鋼材構造
其 一

APPROVED
NOV 11 1908

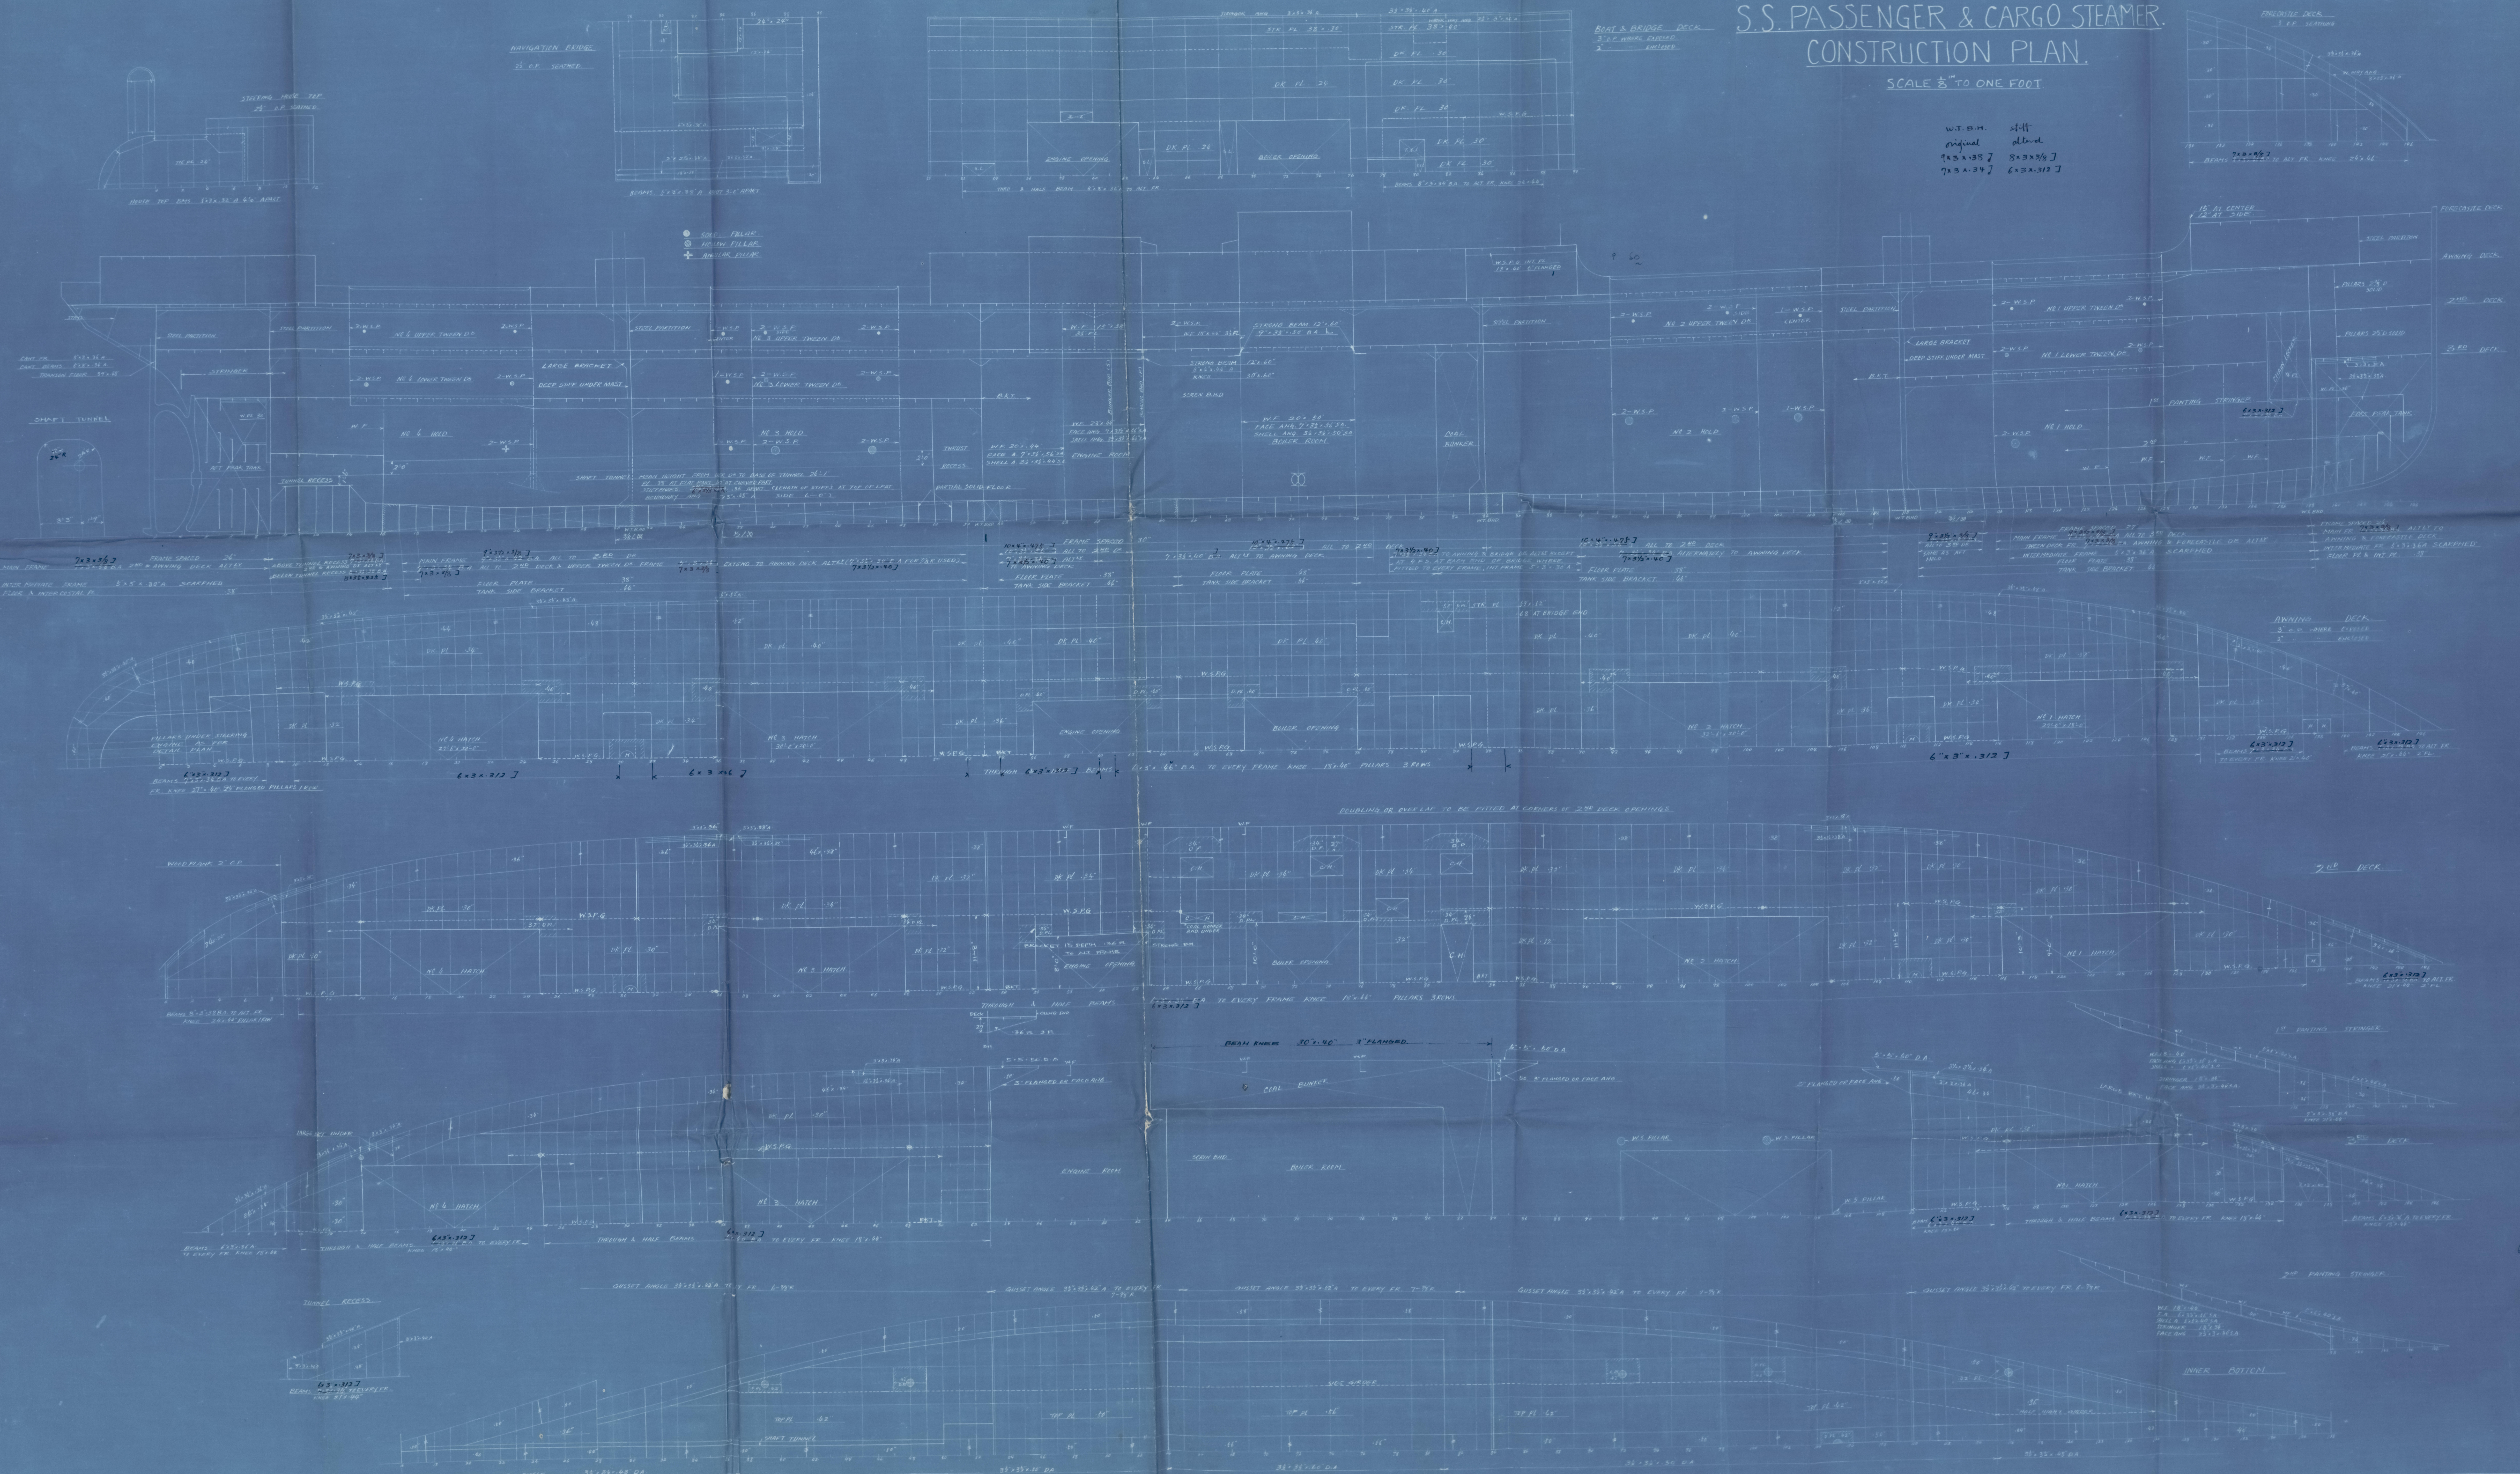

hmdm

✠ S.S. "TAKAO MARU" ✠
YKA. 3936.

Ship's Name or No. 3 1 7	
Name	<i>Revised</i> CONSTRUCTION PROFILE
of	& DECK PLANS.
Drawing	
Drawing No.	Sending No.

GEN. BOX NO 873



© 2021

Lloyd's Register
Foundation

N1323-0056