


# M.S. "CHOJO MARU".

## CONSTRUCTION PROFILE & DECK PLAN. (SHEET 1.)



### SCALE $\frac{1}{8}$ TO ONE FOOT.

FRAME SPACE 24' THROUGHOUT.

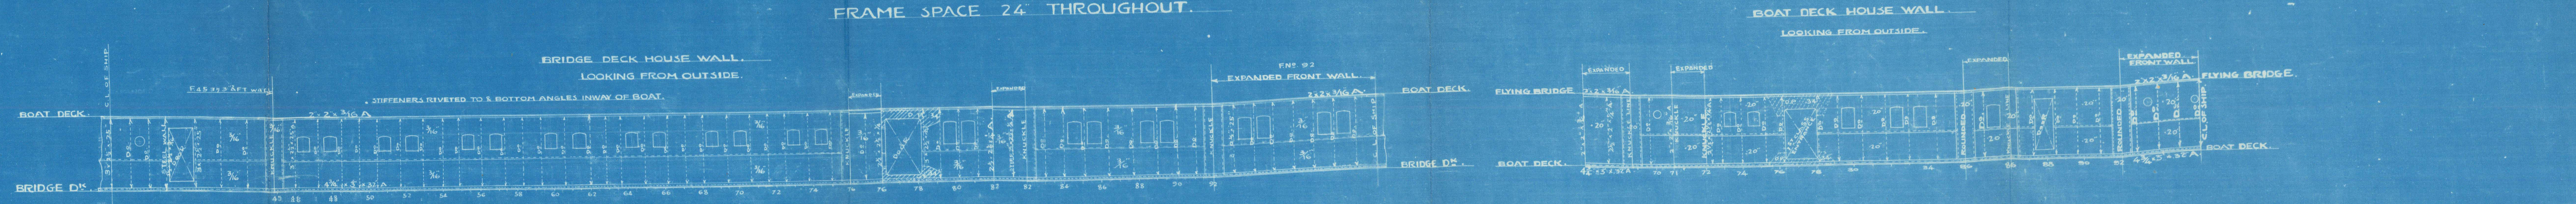

CENTRE OR SIDE	FRAME NO.	WIDELY SPACED PILLARS				LENGTH OF PILLAR	TUBULAR PILLAR
		S	B	H	N		
2ND DECK-UPPER	16	19.5	10.4	485	183	67.5'	6x4
	28-29	DERRICK POST.					
	45	24.5	22.75	484	279	525	8x4
	110	DERRICK POST.					
HOLD	16	15.5	13.8	1260	33.9	4.25	5x4
	28-29	29.0	24.8	1275	91.6	5.3	16x54
	45	24.5	22.75	1259	70.2	4.00	13x54
	95	25.0	22.75	1243	79.8	12.3	14x52
2ND DECK-LOWER	110	28.0	26.4	1275	91.4	12.8	16x56
	123	21.0	13.7	1246	35.8	13.6	10x48

CENTRE OR SIDE	FRAME NO.	UPPER DECK				GIRDER	FACE BAR & C.	REMARKS
		S	B	H	N			
2ND DECK	16	14.0	17.4	475	146.3	12'x40"	8'x3'x44' B.A.	HATCH
	16-28	24.0	14.6	5	505	12'x46"	12'x3/2'x32'x44' CH R.P. 7'x4.6	
	22-43	28.0	15.3	5	728	12'x46"	12'x3/2'x32'x44' CH R.P. 11'x7.5	HATCH
	45-52	14.0	22.75	4	1784	12'x40"	9'x3'x35' B.A.	

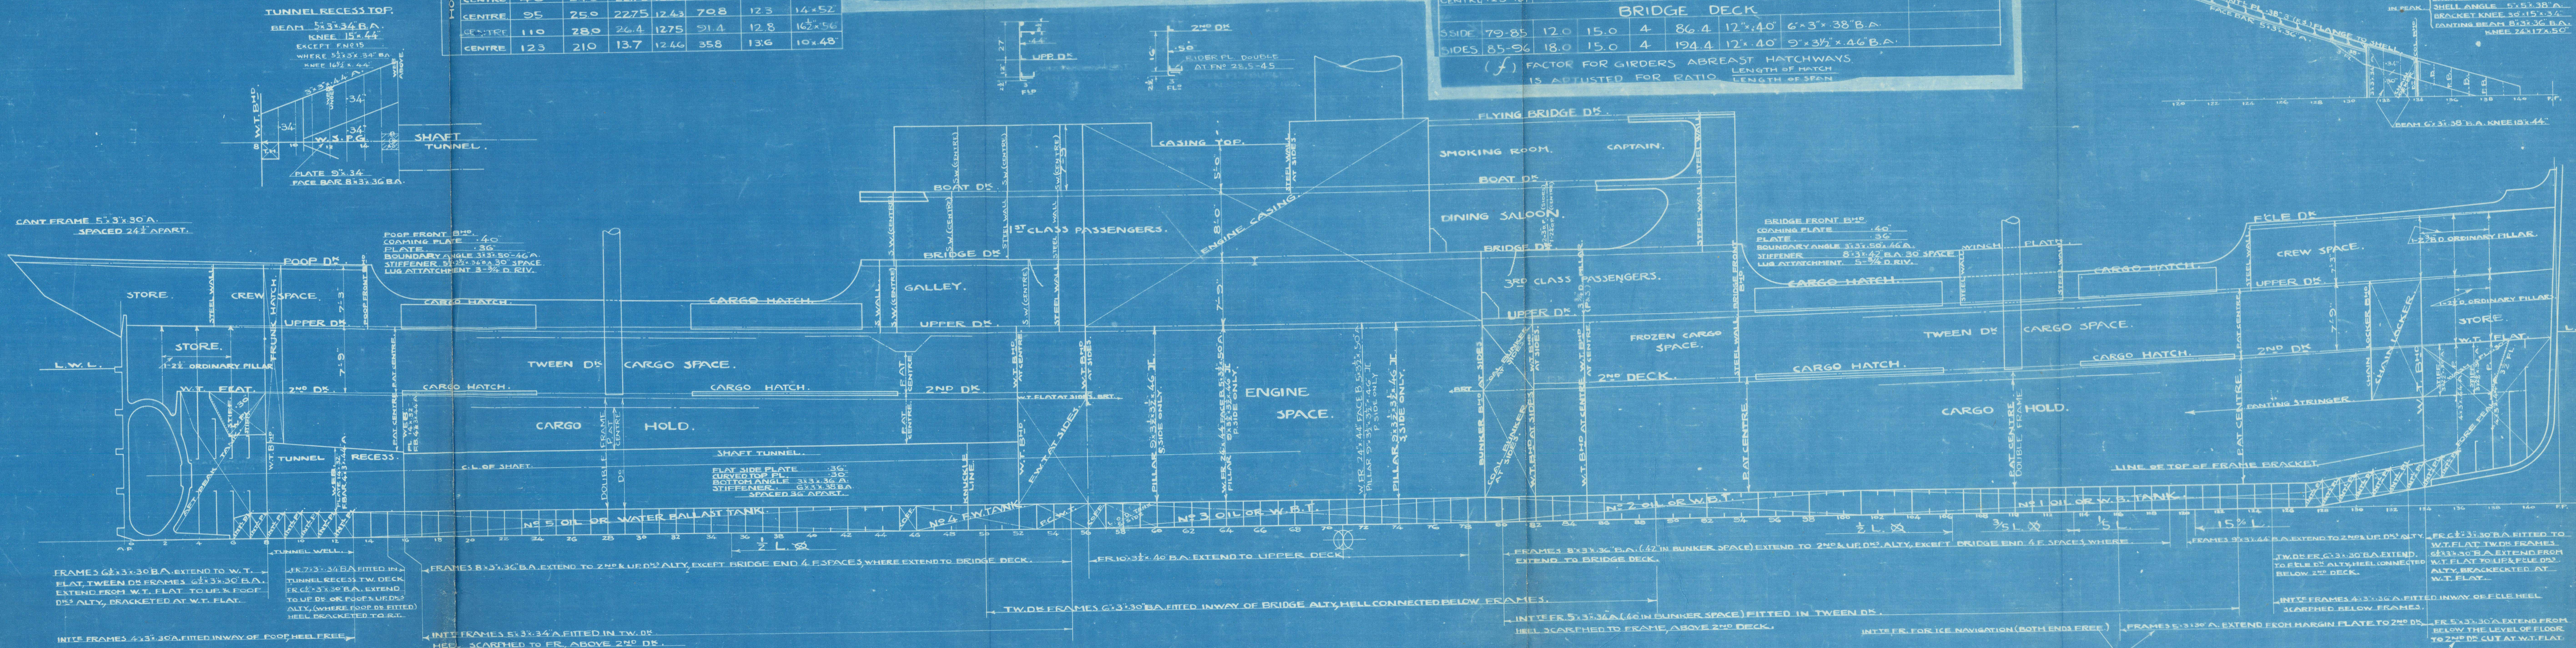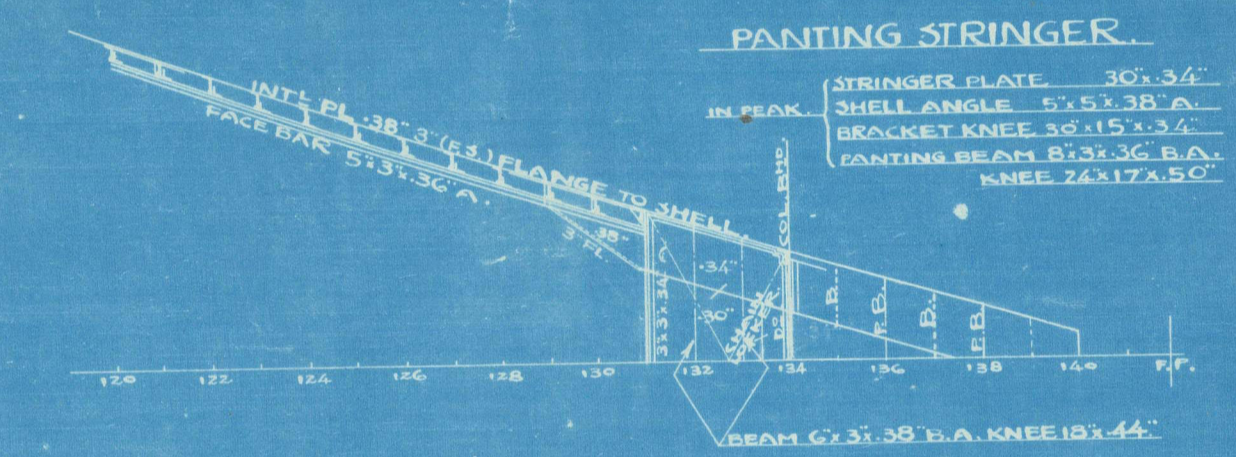

S.N. 424  
M.S. "CHOJO MARU"  
CONSTRUCTION PROFILE  
& DECK PLAN (SHEET 1.)  
(FINISHED PLAN)  
SCALE  $\frac{1}{8}$  = 1 FOOT.





© 2021

Lloyd's Register  
Foundation