

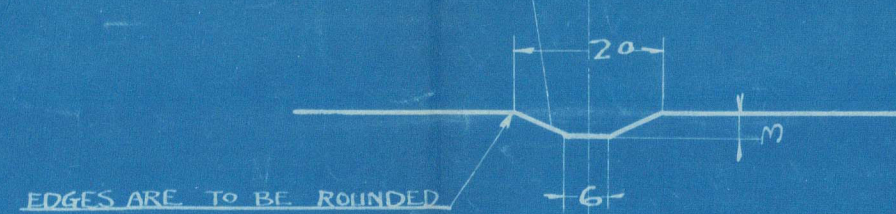
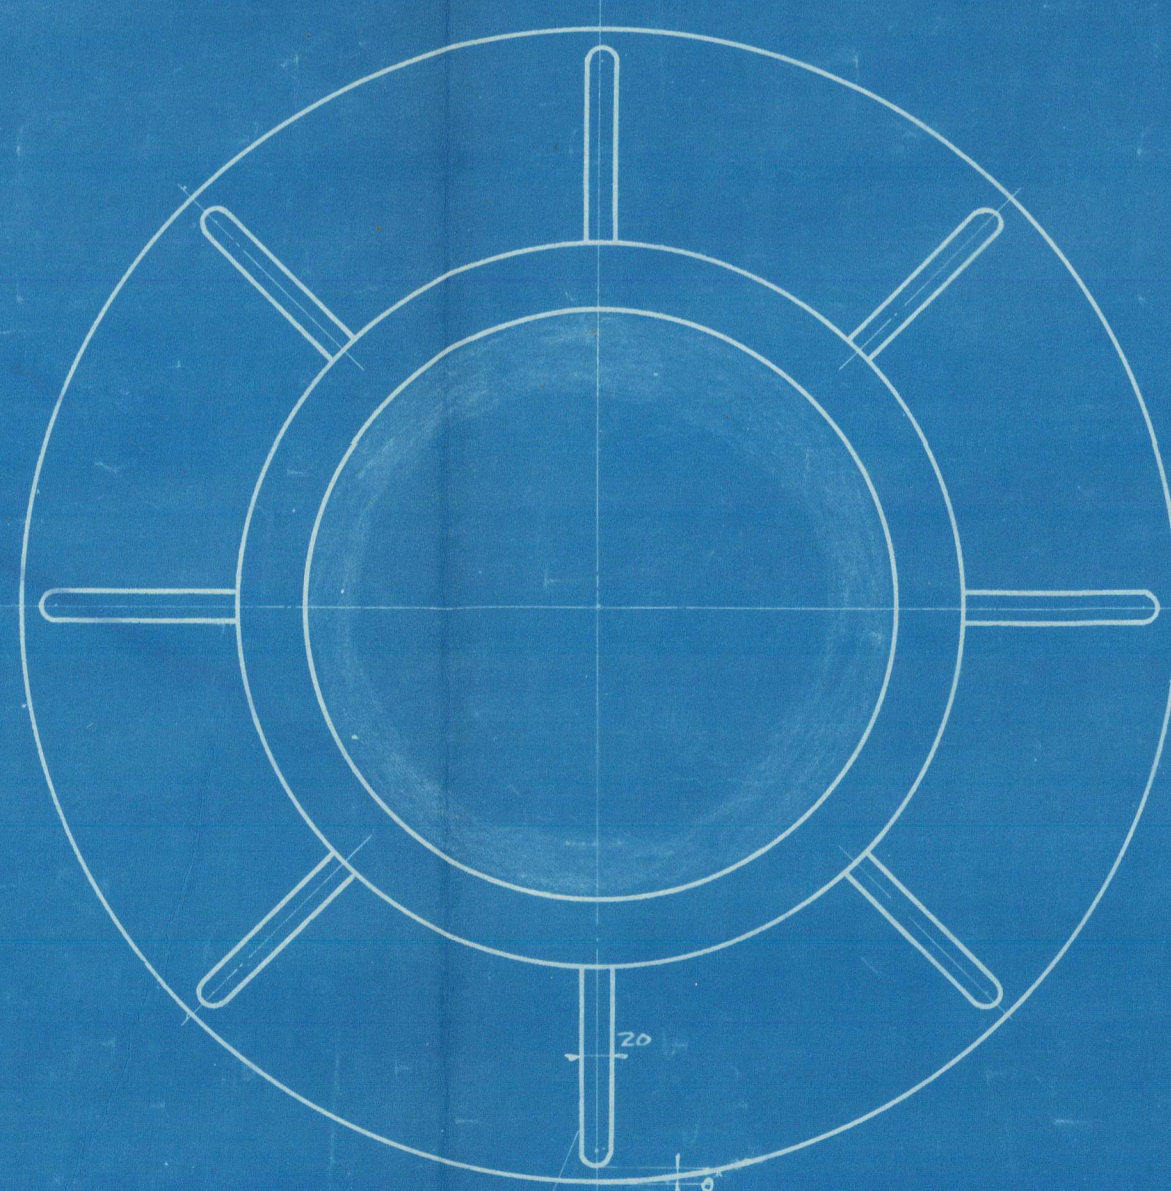


SECTION III-III

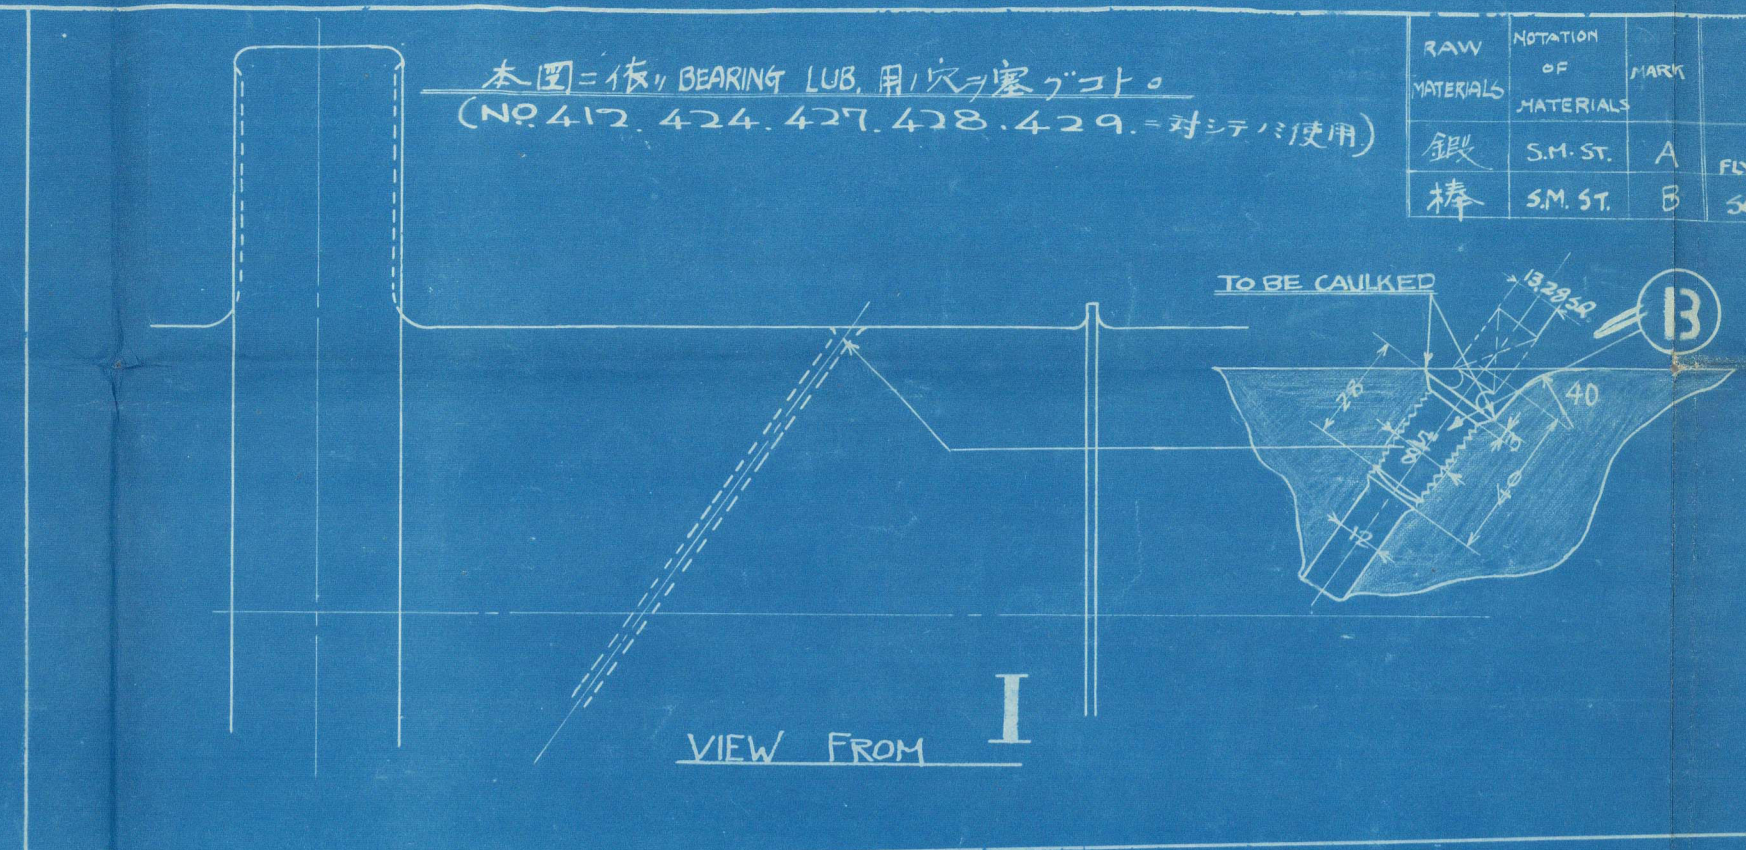

EDGES ARE TO BE ROUNDED

VIEW FROM II

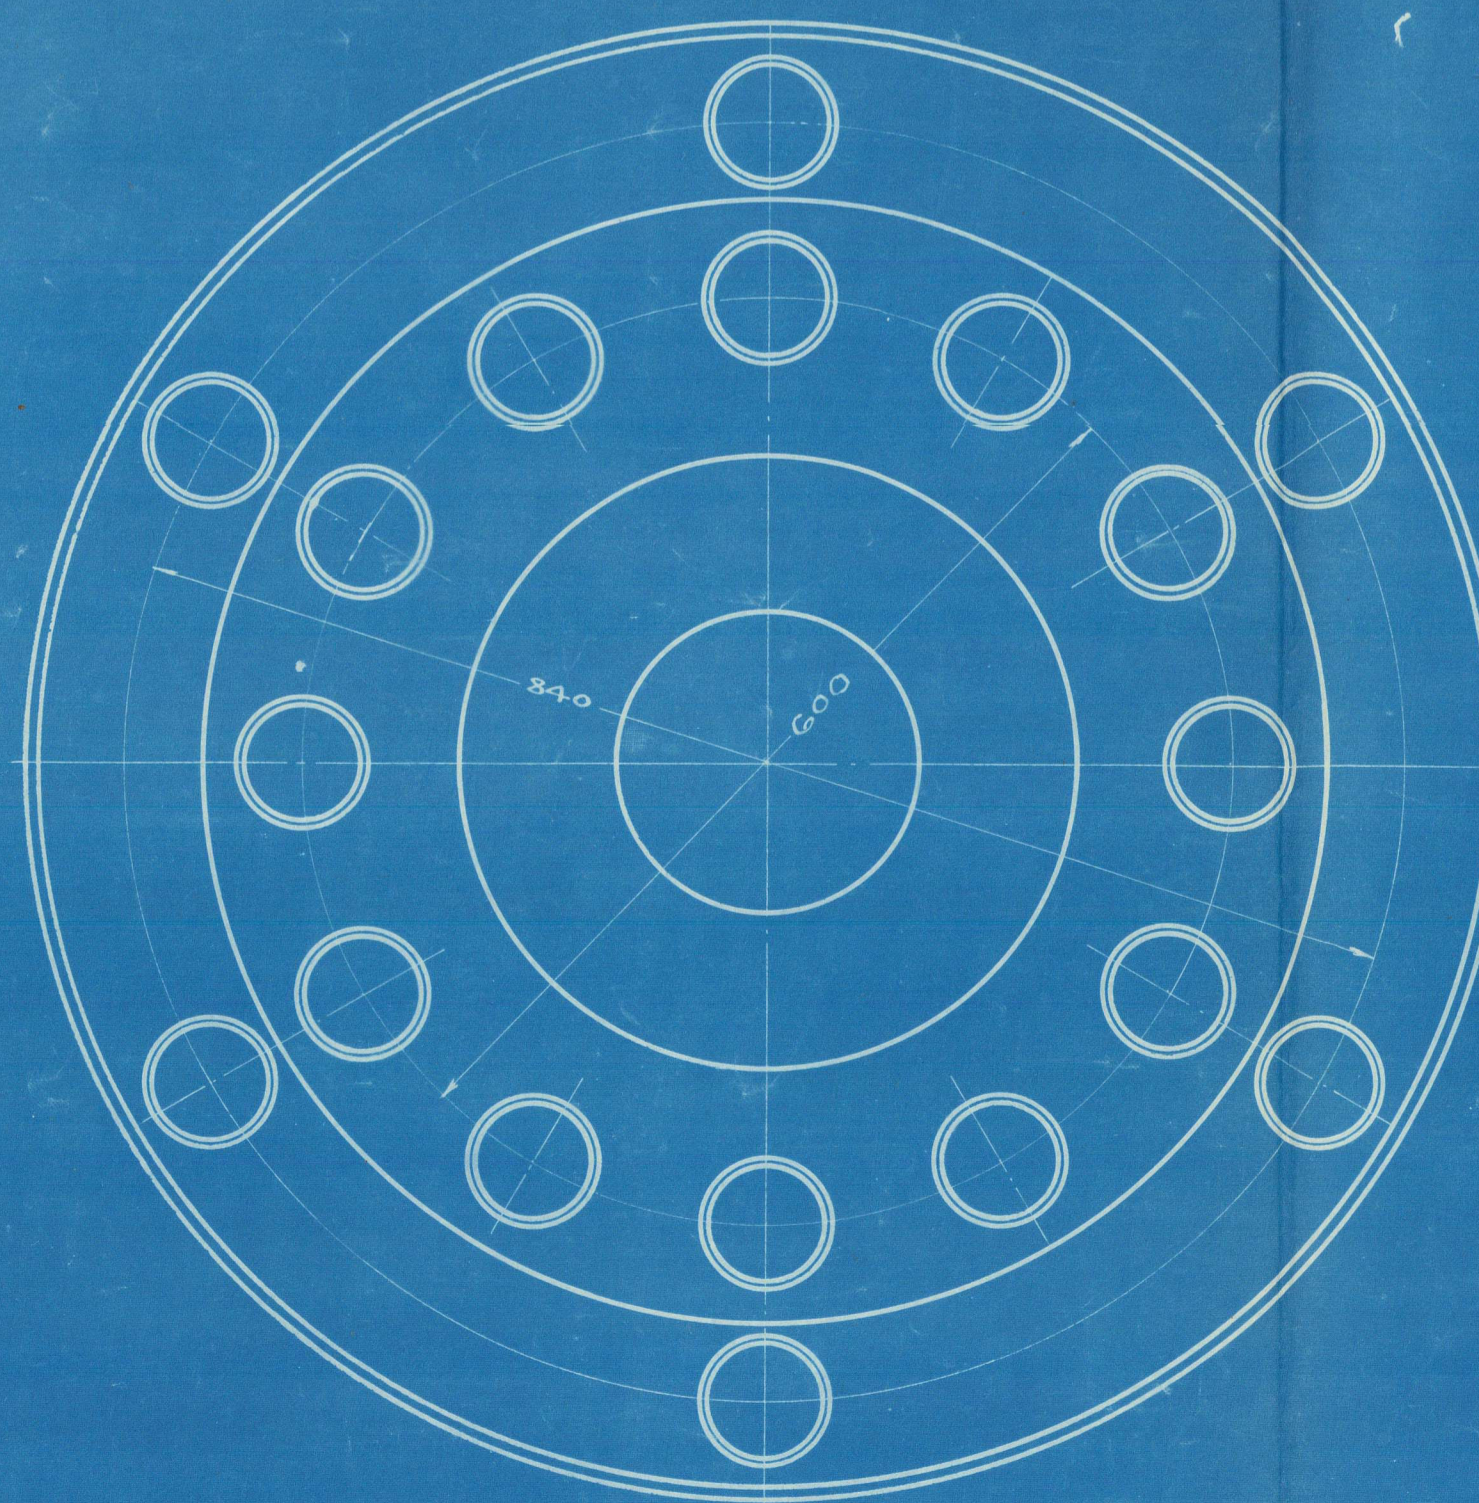

VIEW FROM I




注意  
一 中間軸連結スベキ接手ニ限リ COTTER DISC 用  
ノ RINGS ヲ 廢止セリ。又同螺釘 中間軸側  
ヲ 挿入ス。  
二 中間軸ト連結用ノ BOLT ハ 機内係ニシテ  
製作ノコト。

Copy of plan  
approved in Kobe  
June 23rd 1926


M. S. CHOJO-MARU

NO. 424

ITEM 2A

FLY WHEEL SHAFT  
WITH THRUST COLLAR

SCALE 1:1 & 1:5

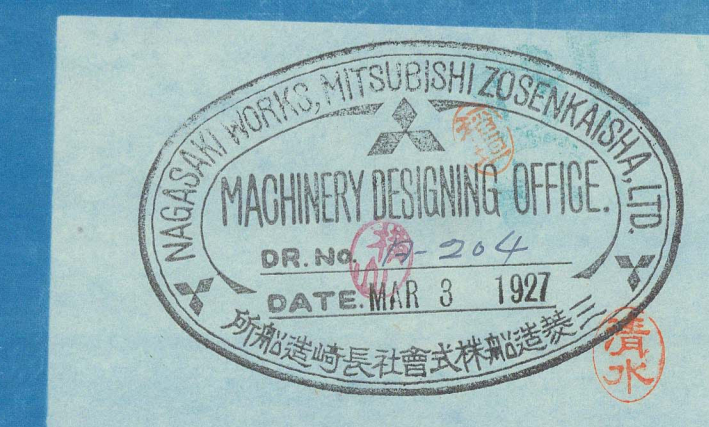


GST-60