
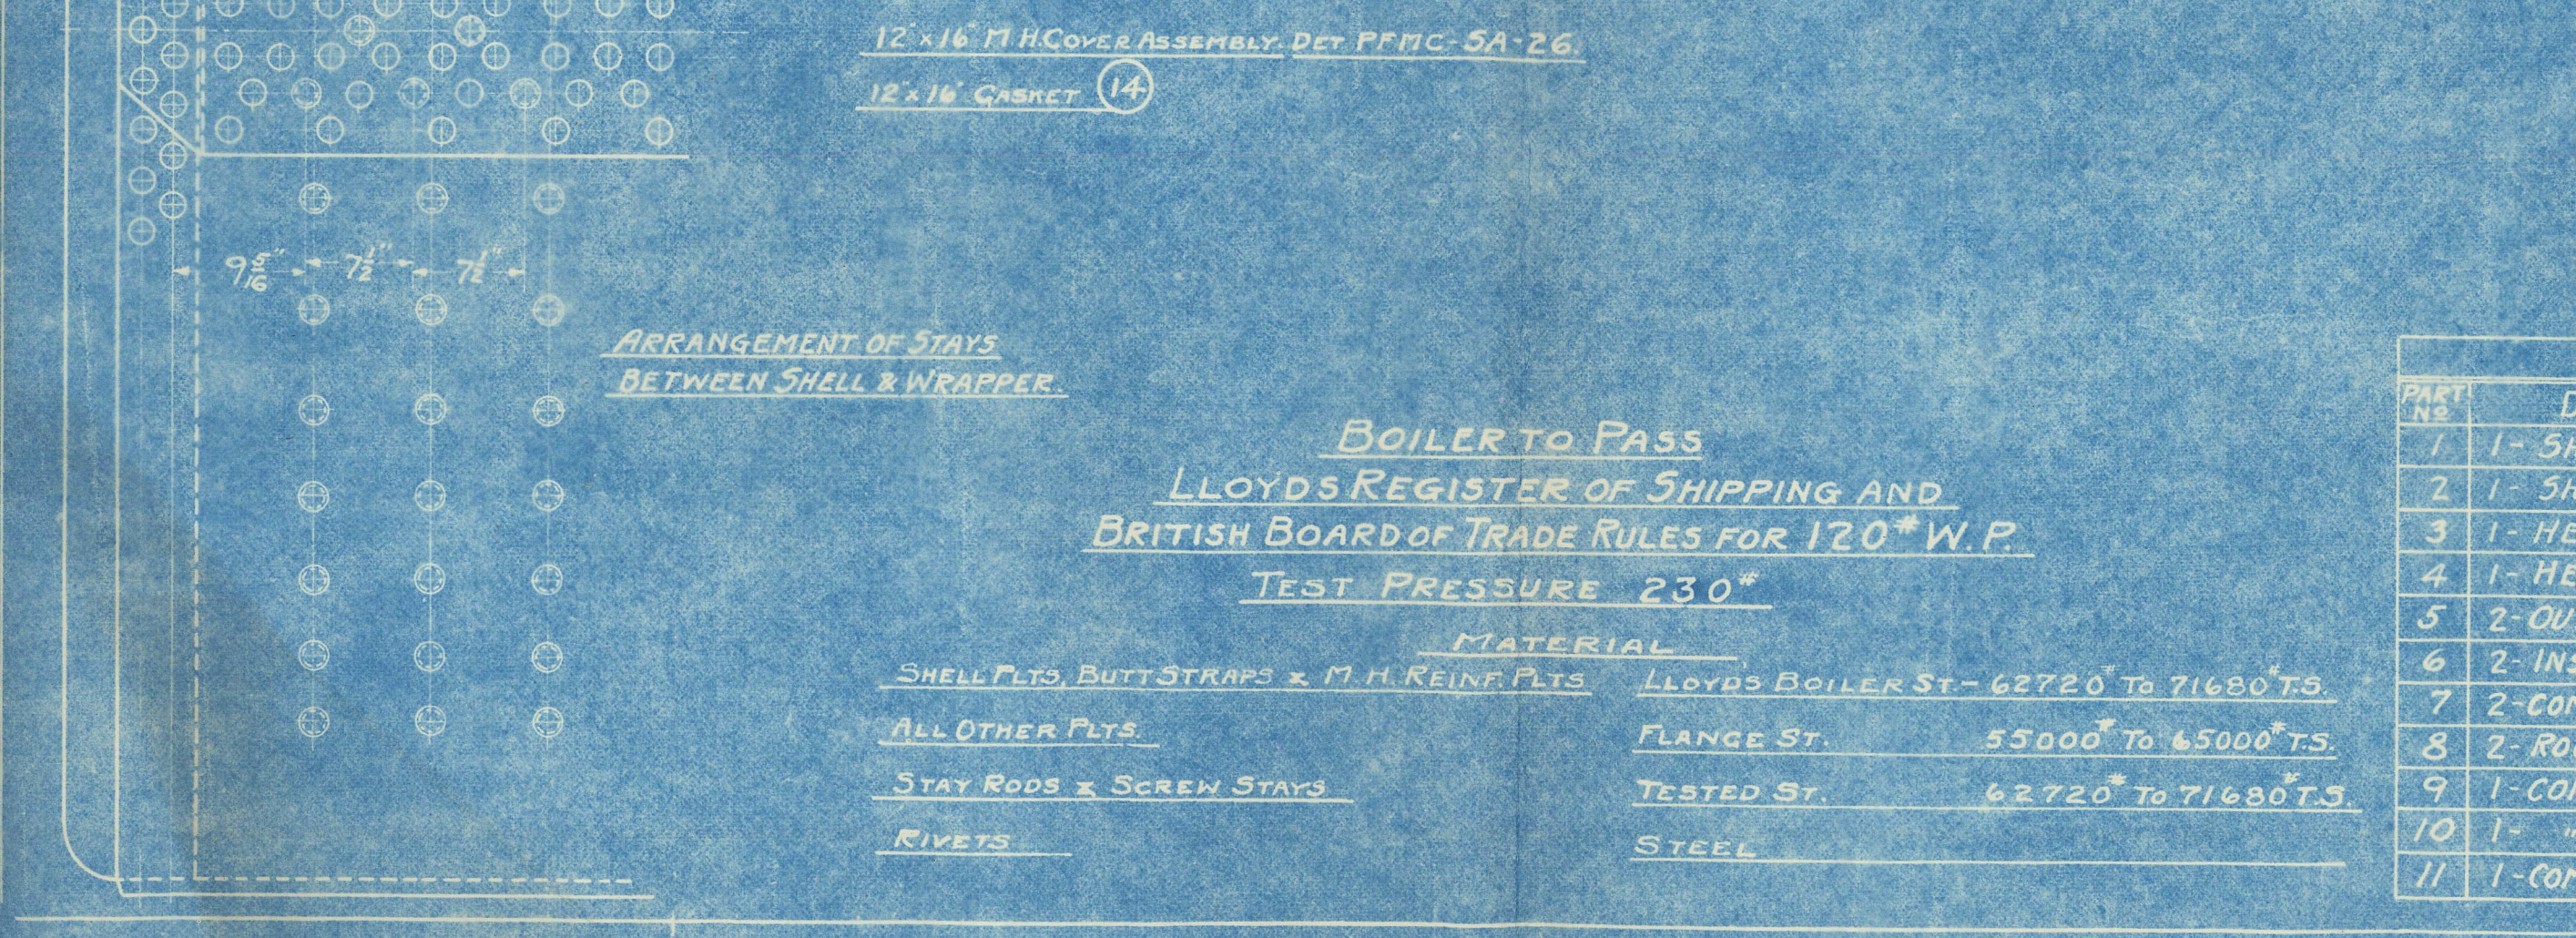


ITEM	LOYD'S RULES	W.P.	BRITISH BOARD OF TRADE RULES	W.P.
SHELL	22 x (11-2) x 84.166%	123	22 x (11-2) x 84.166%	124.5

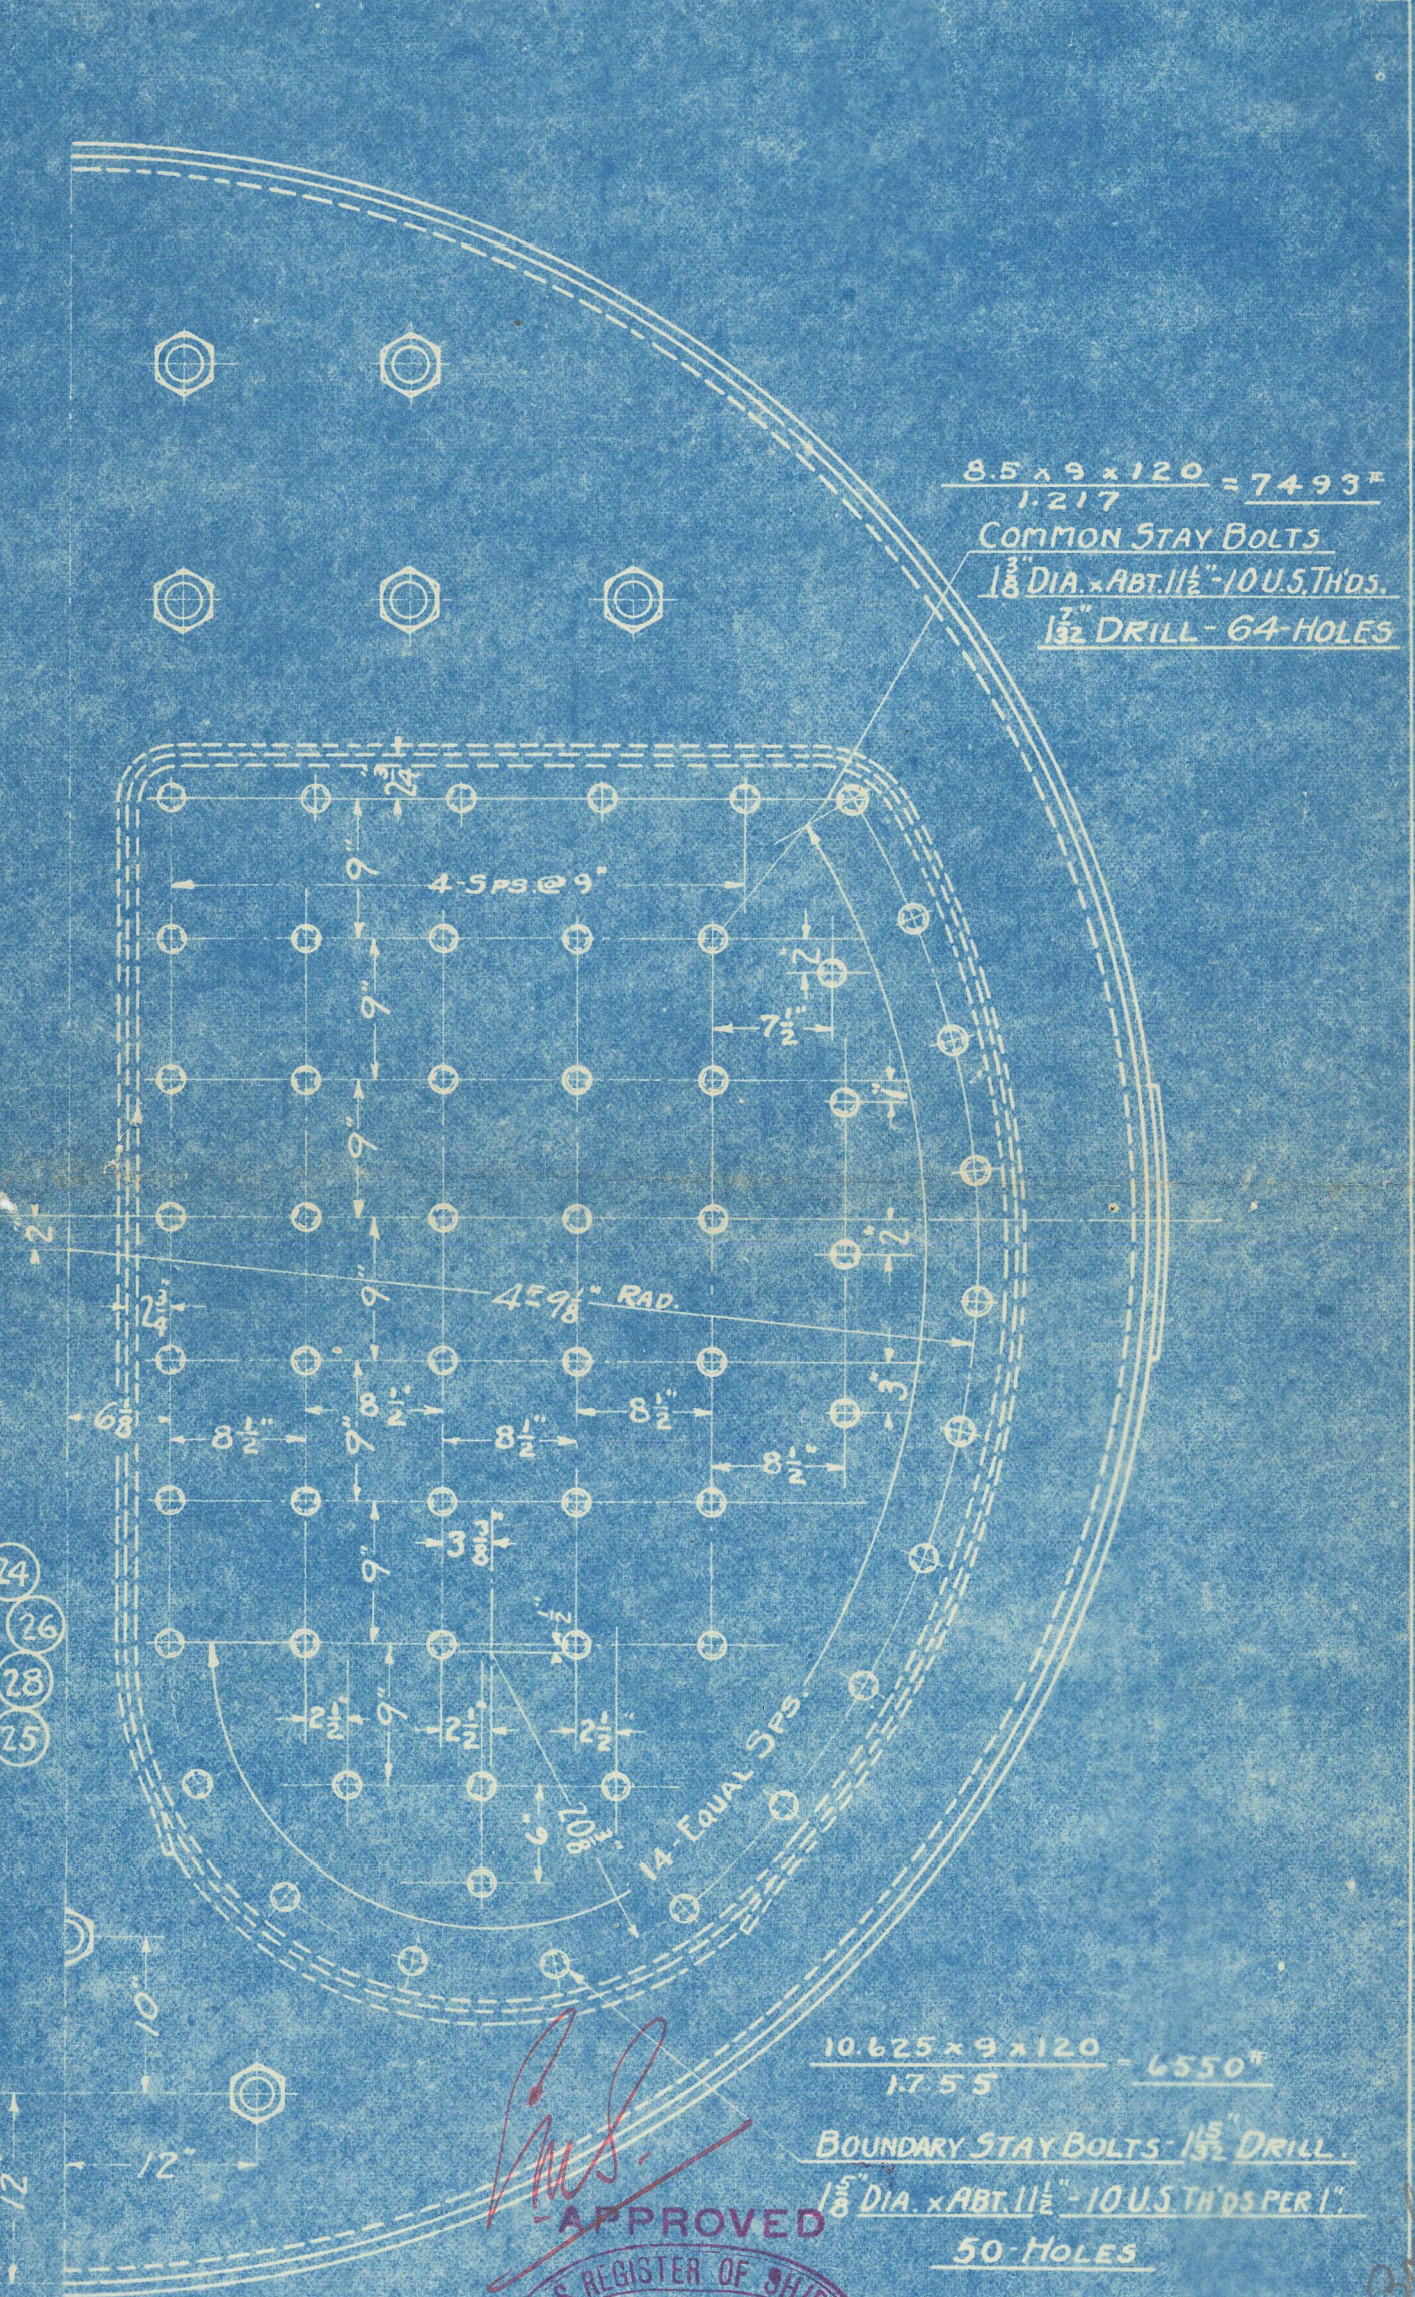

SECTION ON VERT. E

9' 9 1/2"

10' 0 1/2" SHELL

10' 7 1/2" OVERHEADS

PART NO.	DESIGNATION	SIZE	QTY	PART NO.	DESIGNATION	SIZE	QTY
1	1-SHELL	1/16 x 121 1/2 x 213 1/2	12	1	1-COMB. CH. FLAME SH. L.H.	3/8 x 64 x 89	17
2	1-SHELL	1/16 x 121 1/2 x 213 1/2	13	1	1-TANHOLE DOUBLER	1/16 x 28 1/2 x 32 1/2	18
3	1-HEAD (FRONT)	3/4 x 150 1/2 DIA.	14	2	2-MANHOLE GASKETS	12 x 16	19
4	1-HEAD (BACK)	3/4 x 150 1/2	15	148	2 1/4 O.DIA. TUBES	7/2 B.W.G. 7' 4 1/2 LG.	20

APPROVED

APR 10 1921

NEW YORK

GENL. NOTES

RIVET HOLES DRILLED 1/16" LARGER THAN RIVET IN PLATES THAT ARE FLAT WHEN FINISHED.

HOLES IN ROUNDABOUT SEAMS DRILLED 1/16" IN FLAT PLATE EXCEPT UNDER BUTT STRAPS.

HOLES UNDER BUTT STRAPS DRILLED FULL SIZE FROM BUTT STRAPS IN PLACE.

ALL STAY BOLTS TO HAVE 3/8" HOLE DRILLED IN EACH END OF BOLT. HOLE TO EXTEND 1/2" BEYOND SHEET SUPPORTED.

COAL BURNING HEATING SURFACE

TUBES 1011

COMB. CHBR. 168

FURNACES 93

TOTAL 1272

WILLAMETTE IRON AND STEEL WORKS

PORTLAND ENGINEERING DEPT. OREGON

DATE 10-2-20

BY J. B. HARRIS

APPROVED

PBS

G-52

Donkey Boiler

Southwestern S.B. Co's

Hulls Nos. 24, 25, 26

No. 24	s/s	"Scopas"	S.F. Apt. No.	3525
No. 25	"	"Silvanus"	" " "	3603
No. 26	"	"Semiramis"	" " "	3726

RETAI

RETAI



© 2021

Lloyd's Register
Foundation

W1329-0157