
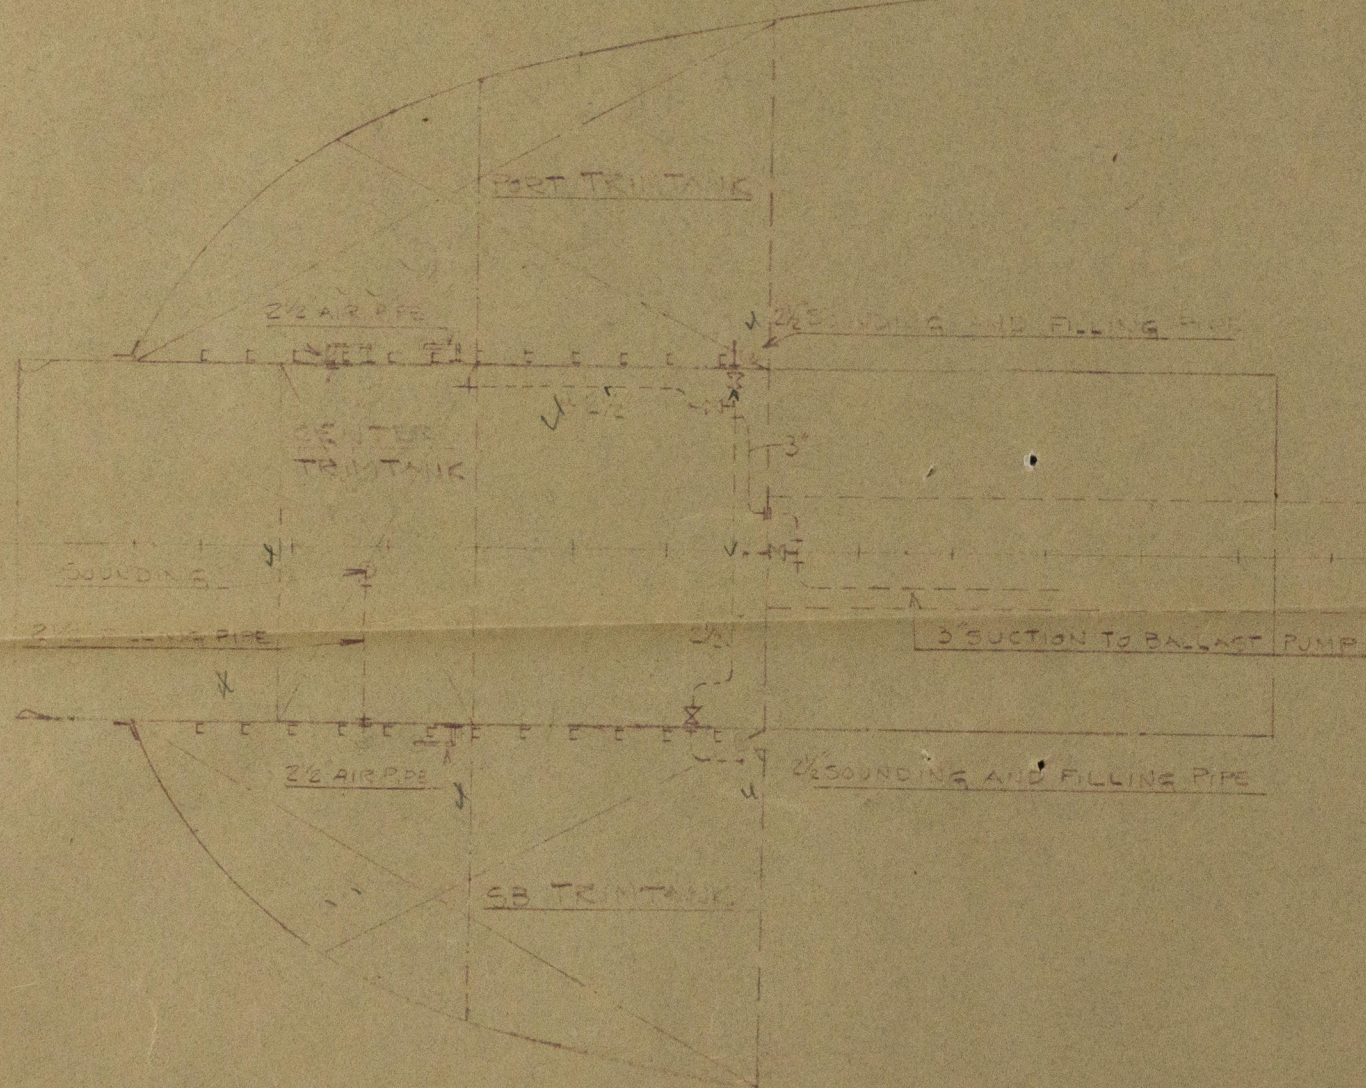
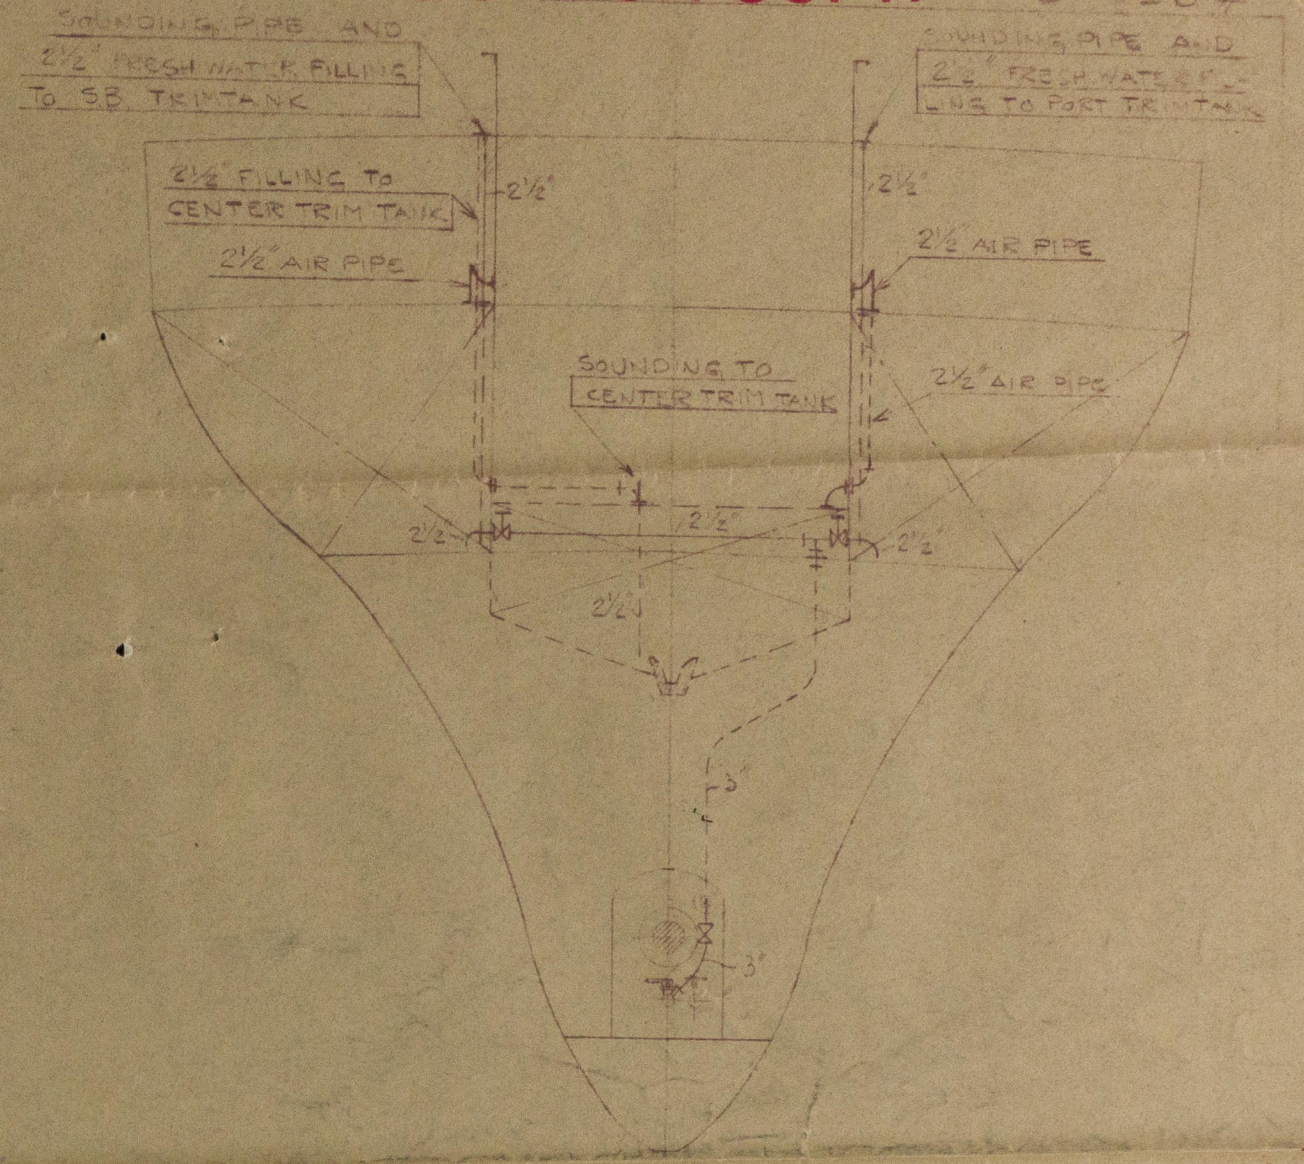


LONDON COPY.

20850 #

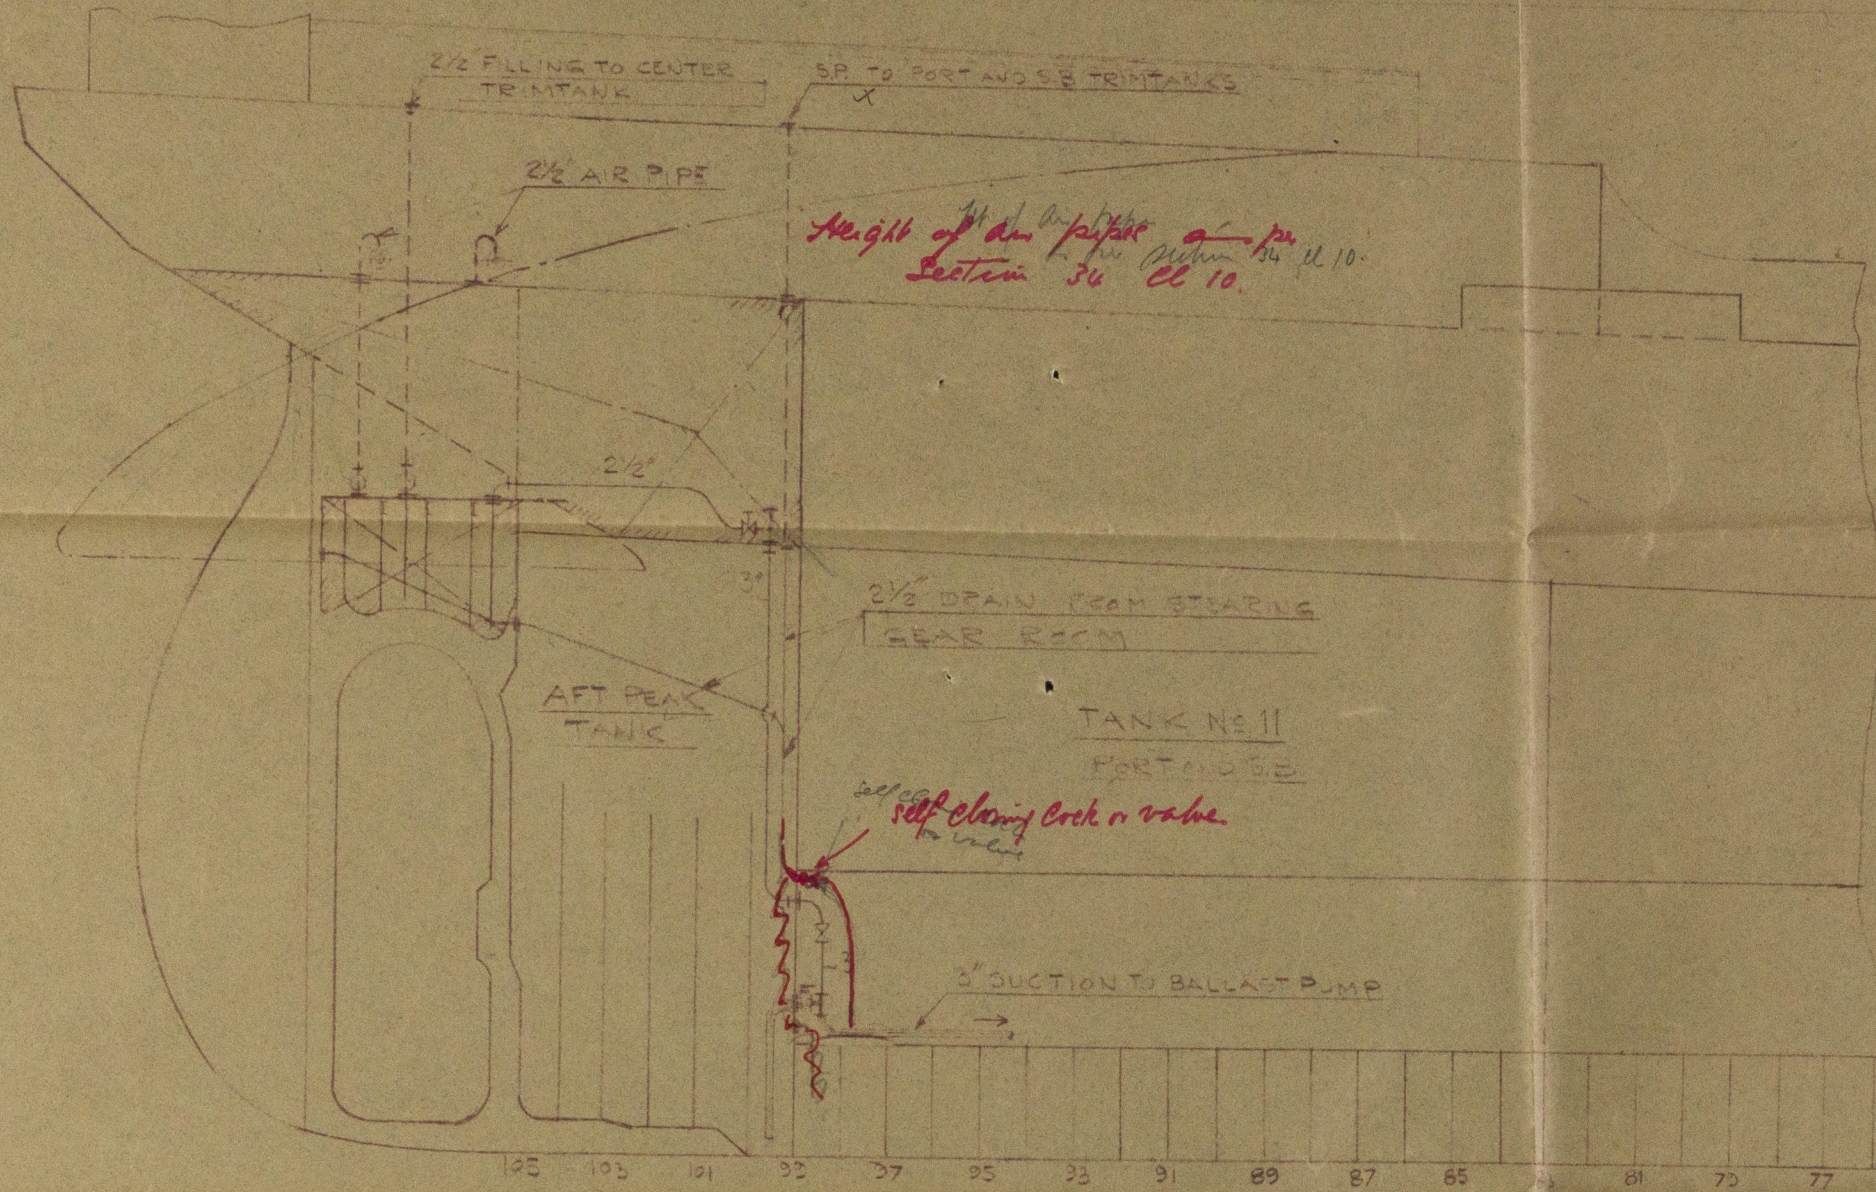

SECTION AT FRAME # 99  
LOOKING AFT.

Lot 10953.

Fraternitas

The remaining requirements of section 34  
of the rules 1938-6 to be complied with so  
far as they are applicable.




*10/1*  
*12/8/36*

A-B GÖTAVIKEN  
FL/K FRATERNITAS

PUMPING ARRANGEMENT  
FOR TRIM TANKS

DRAWN BY: *M. J.*  
TRACED BY:  
CHECKED BY:

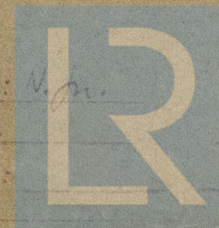

© 2020  
SCALE 1:100  
DATE 2012  
Lloyd's Register  
Foundation  
# 95302

W133-0134