


62846*

TO BE SUBMITTED FOR
APPROVAL LATER ON.

Holes in shell to be adequately compensated
Full particulars to be submitted

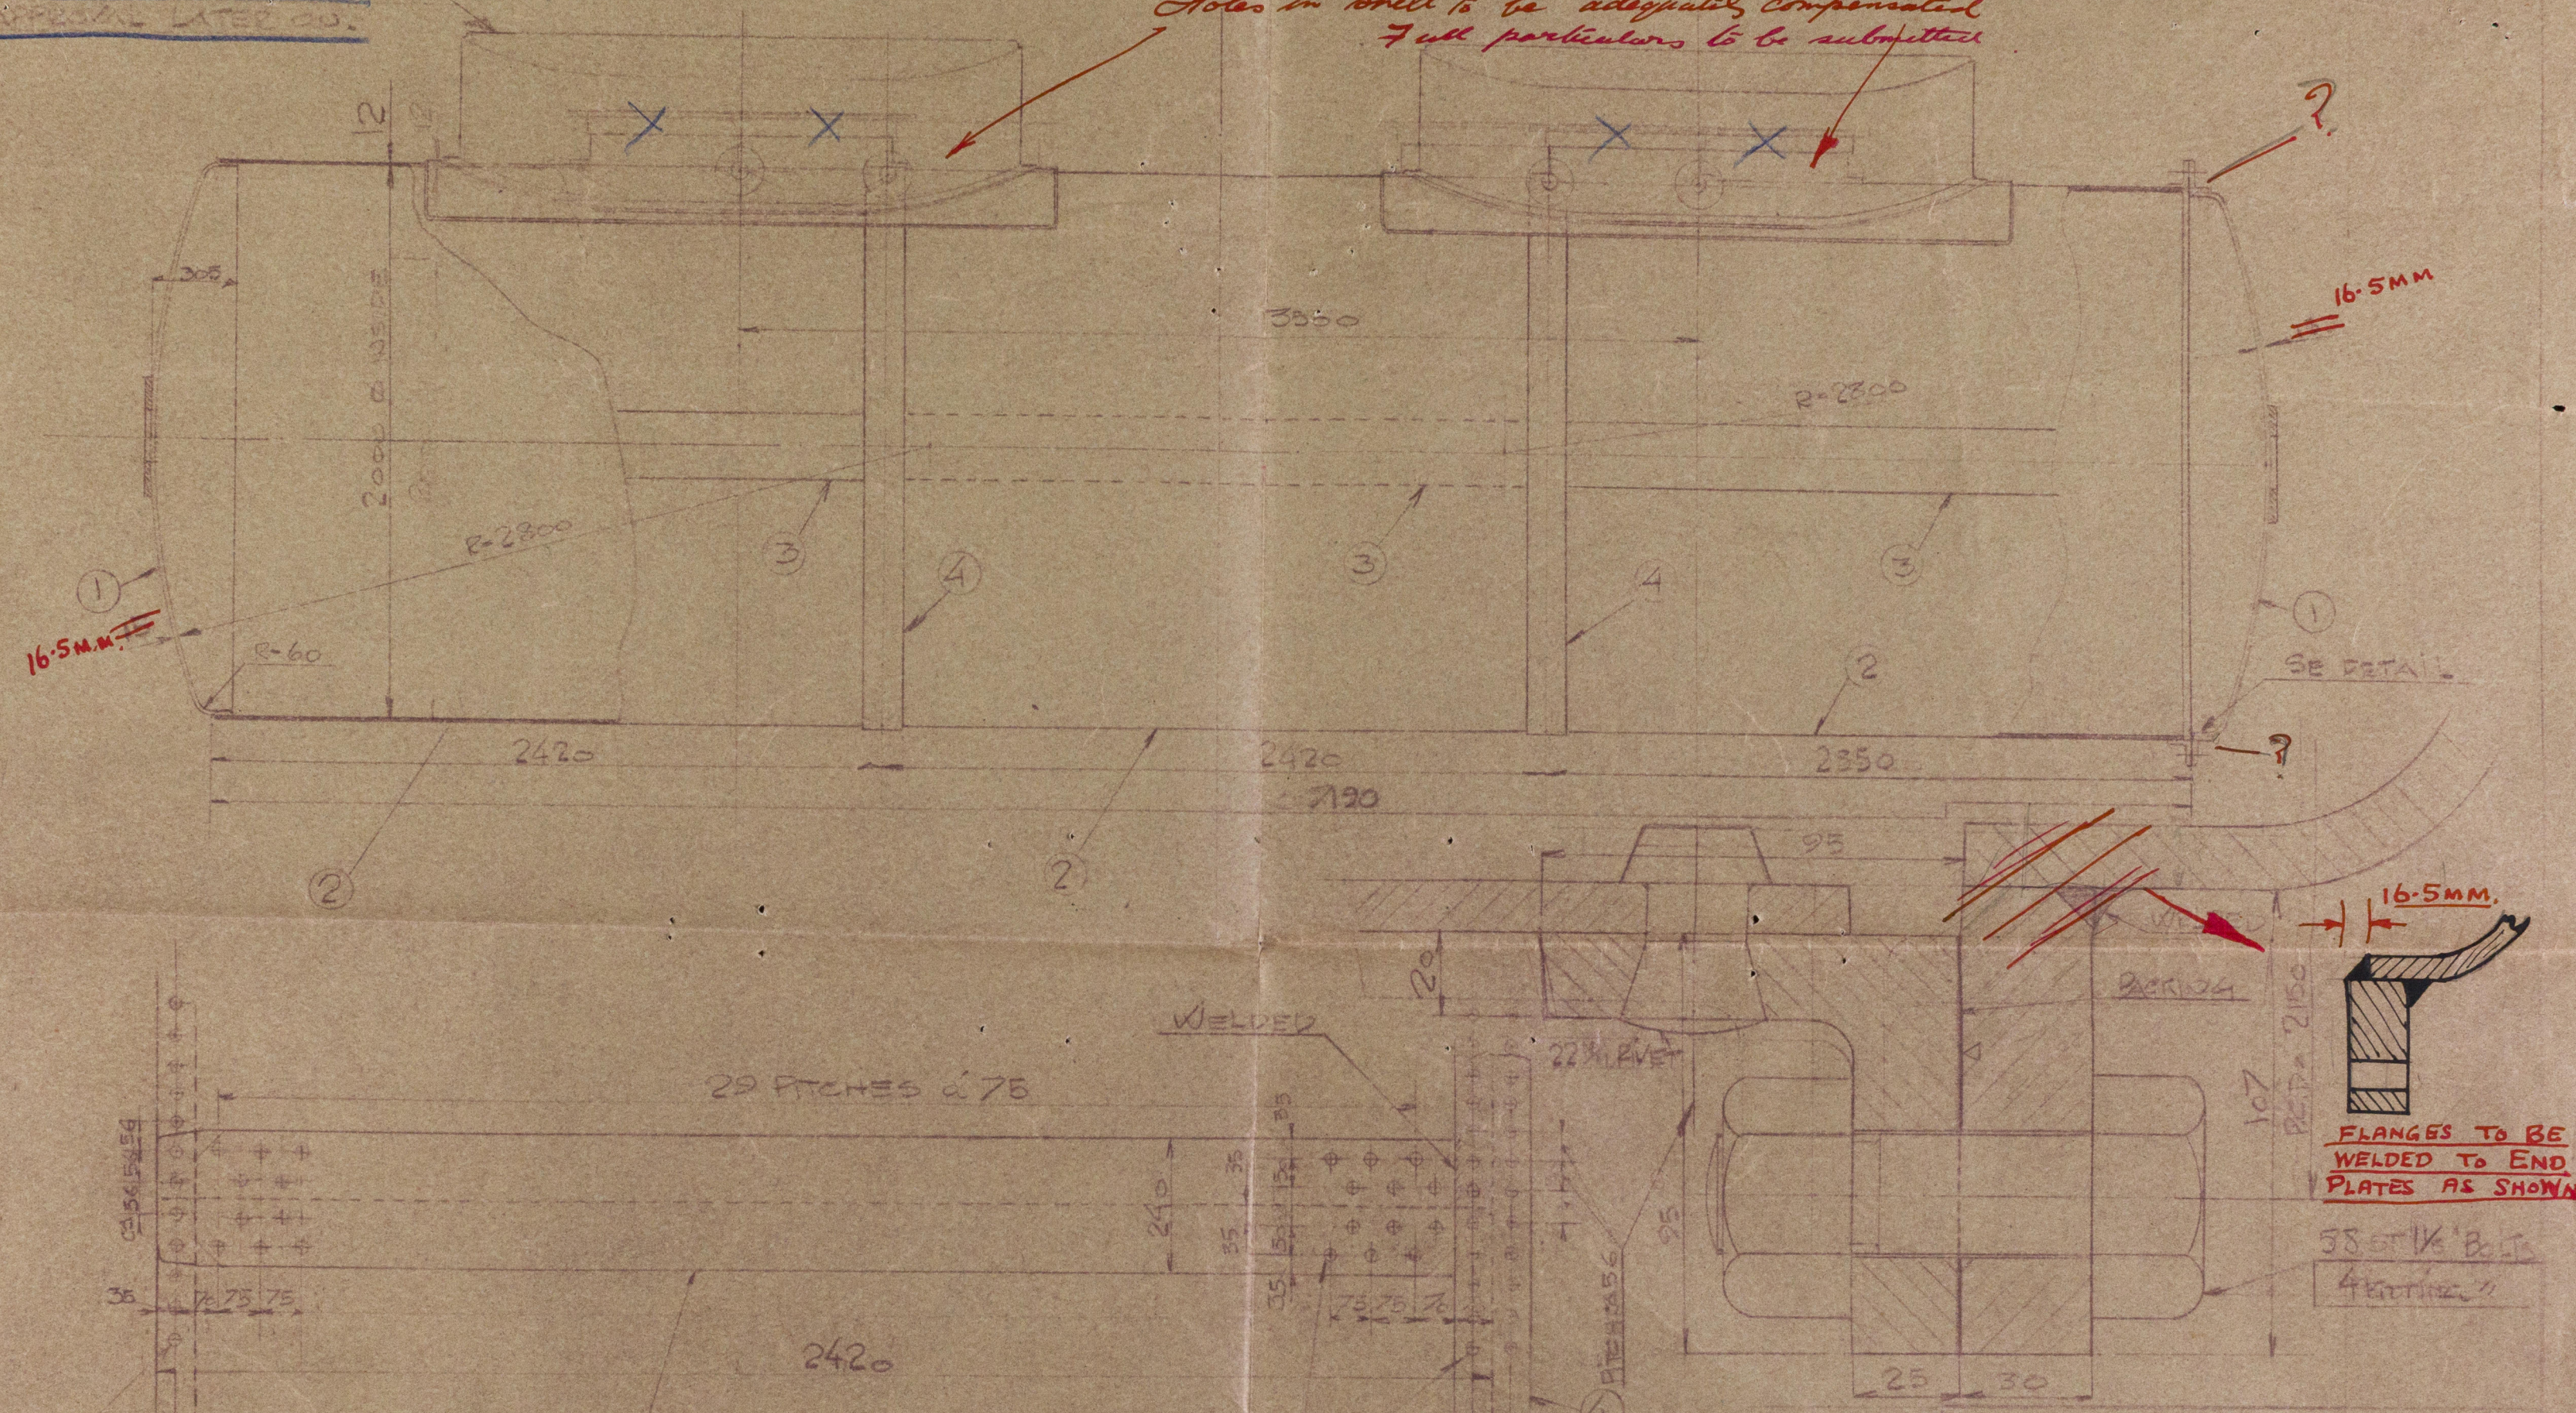

RIVET HOLE = 23MM
" " " " 22
PLATE% = 59
RIVET% = 30.8

BUTT STRAP 12MM

RIVET HOLE = 23MM
" " " " 22
PLATE% = 69
RIVET% = 76

NUMBER OF PLATES	PLATES	TENSILE STRENGTH kg/mm ²	ELONGATION %	WEIGHT kg
1	END PLATE	41-47	23	
2	SHELL PLATE	44-50	20%	
3	BUTT STRAP	" "	" "	
4	" "	" "	" "	
5	RIVETS	41-47	25%	

APPROVED FOR WORKING PRESSURE
PROPOSED (HYDRO TEST PRESSURE)



A-B-GOTAVEKED

HARTMAN EXTRACTOR
HARTMAN EXTRACTOR



DATE 13-7-36
Lloyd's Register Foundation

* 74679

W133-0152

Of Fraternitas

Lot 10953.

Extractor

W133-0152



© 2020

Lloyd's Register
Foundation