


M.T. gaskin.

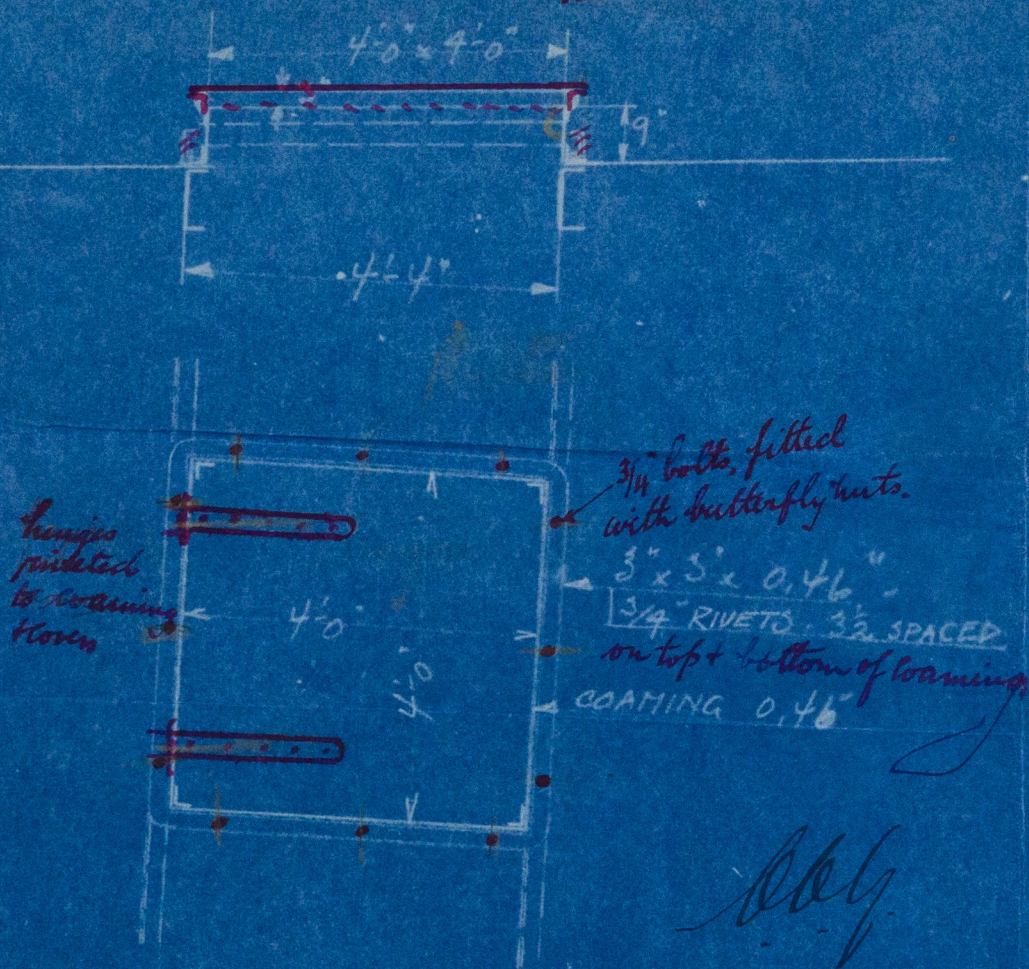

TRIMMING

COAL HATCH

Steel
Hatch Covers 46 in thickness
hinged and bolted & made watertight

W133-0246