




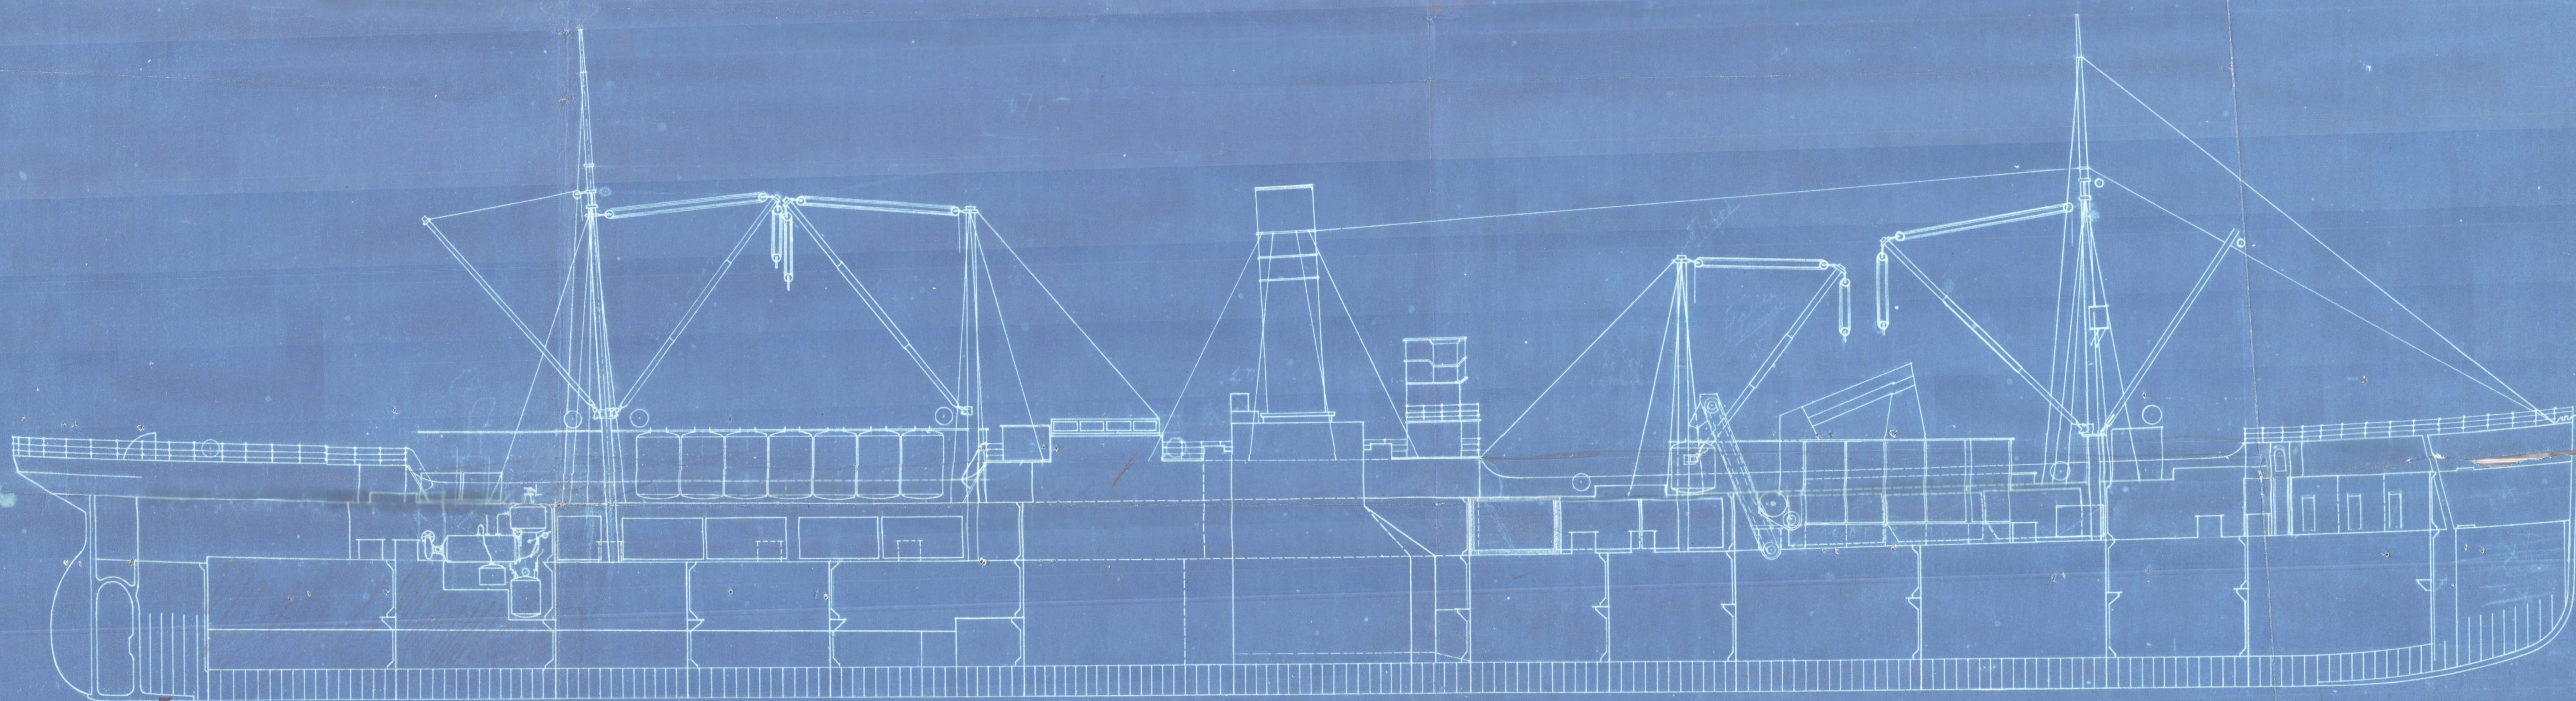

10-9-23

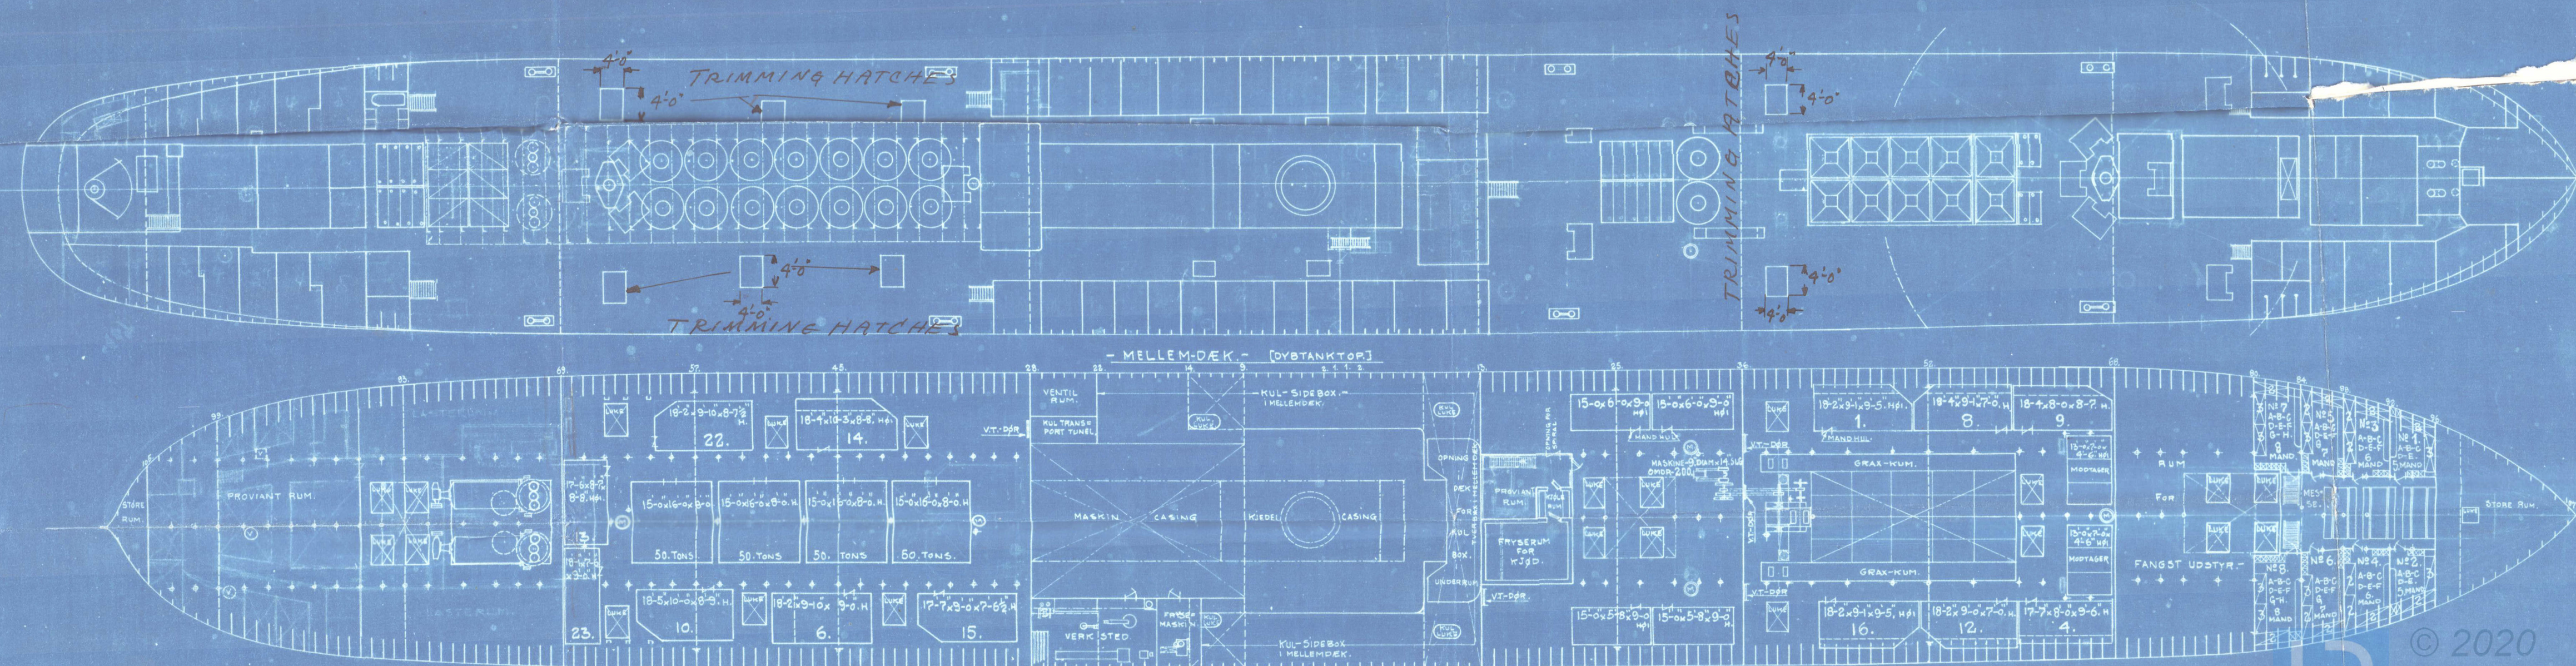

5/5 SIR JAMES CLARK ROSS, ex. MAHRONDA.

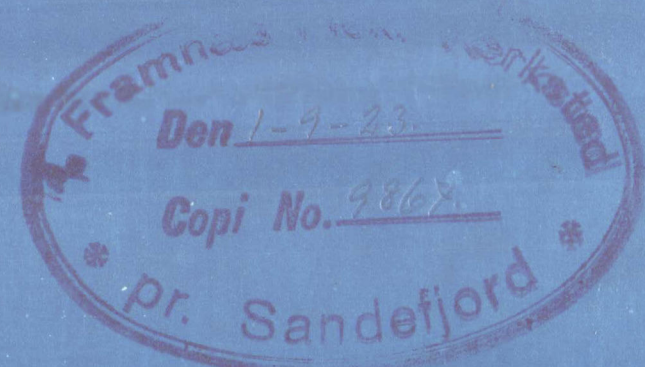

© 2020



Lloyd's Register  
Foundation

6.4.23.



5/5 S. V C ROSS

Mumming Hatches

APPROBERET

LILOYD<sup>3</sup> TEGNING

AV. LUKER PAA

ØVERSTE DEK



© 2020

Lloyd's Register  
Foundation

W133-0247