

MARINE ENGINES N° 1875.


MESSRS RICHARDSON, DUCK & CO^S S. S. N^o 669.

BOILERS. 3-OFF.

SCALE 1 INCH TO A FOOT.

220 LBS' W. P.

BOILERS FITTED WITH MESSRS J. HOWDEN'S SYSTEM OF FORCED DRAUGHT.

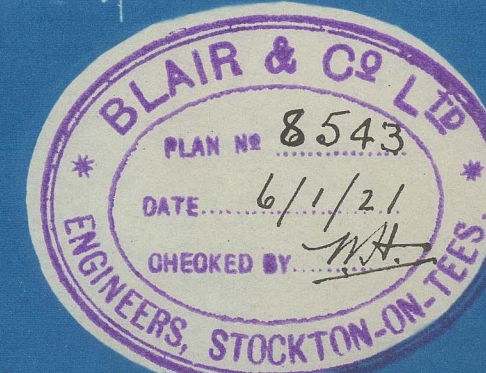

MESSRS. RICHARD
Steam space stays are $\frac{1}{4}$ " in excess
of Lloyds requirements.

From **BLAIR & Co., Ltd.,**

STOCKTON-ON-TEES.

FOR ENCLOSURE TO

Messrs Lloyds
Registry of Shipping
Middlesbro

0251 2/2

3 Main Boilers

Messrs Blair & Co's


By No. 1875-

for

Messrs Richardson Duck & Co's

S. S. No. 669

Working Press 220 lbs

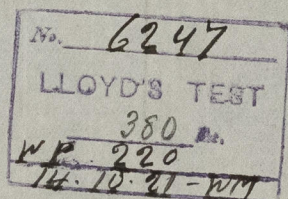

S. S. Illingworth

Middlesbrough Report to 11194



© 2021

Lloyd's Register
Foundation

W1330-0251 1/2

Lloyds

W1330 - 0251 1/2



© 2021

Lloyd's Register
Foundation