


NO 1095
GENERAL ARRANGEMENT SHEET II
 SCALE 1/8 IN. TO 1 FT.
 284'-6" x 45'-6" x 23'-0"

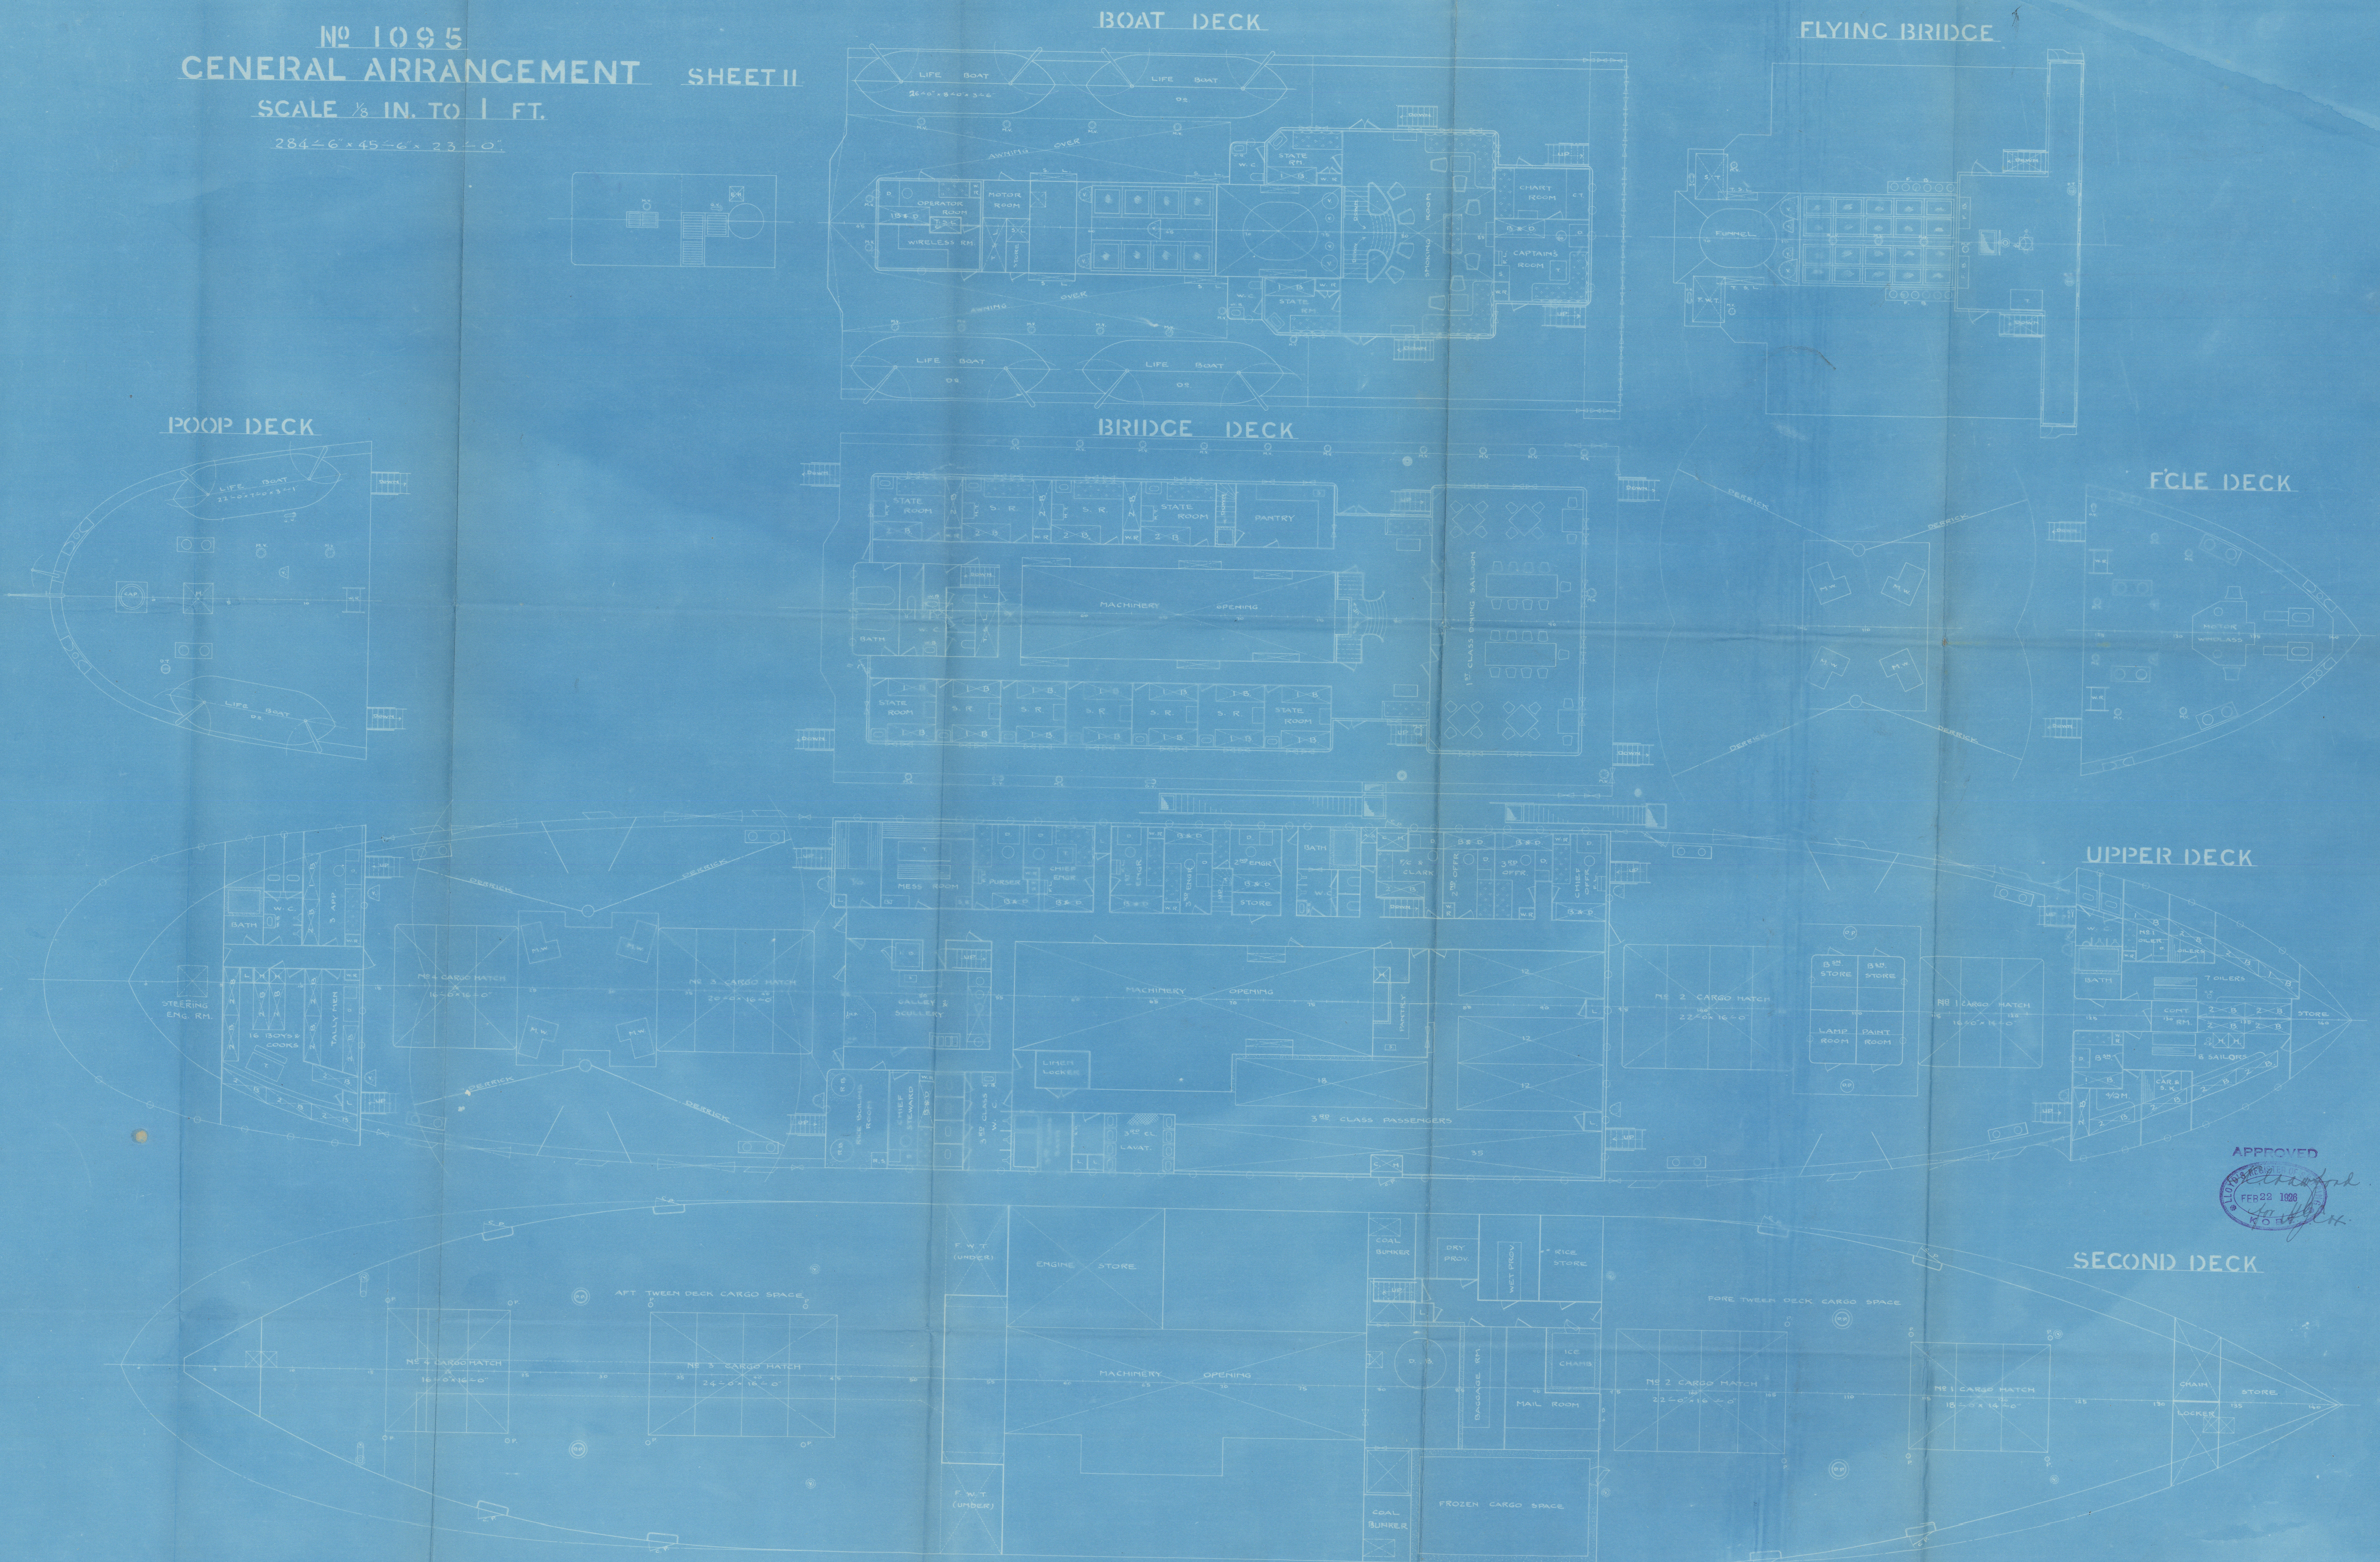

APPROVED
 FEB 22 1928
 [Signature]

W1331-0077

NO 1095

GENERAL
ARRANGEMENT
DECK

M.V. "CHOKO MARU"
KOBE. 5767.

GEN. BOX NO 861



© 2021

Lloyd's Register
Foundation

W1331-0077