


NO 1095.
MIDSHIP SECTION.
TO CLASS LLOYDS *100A1.
AND "TEISHINSHO" 1ST CLASS HEAVY DECKER.
SCALE 1/2 IN. TO ONE FT.

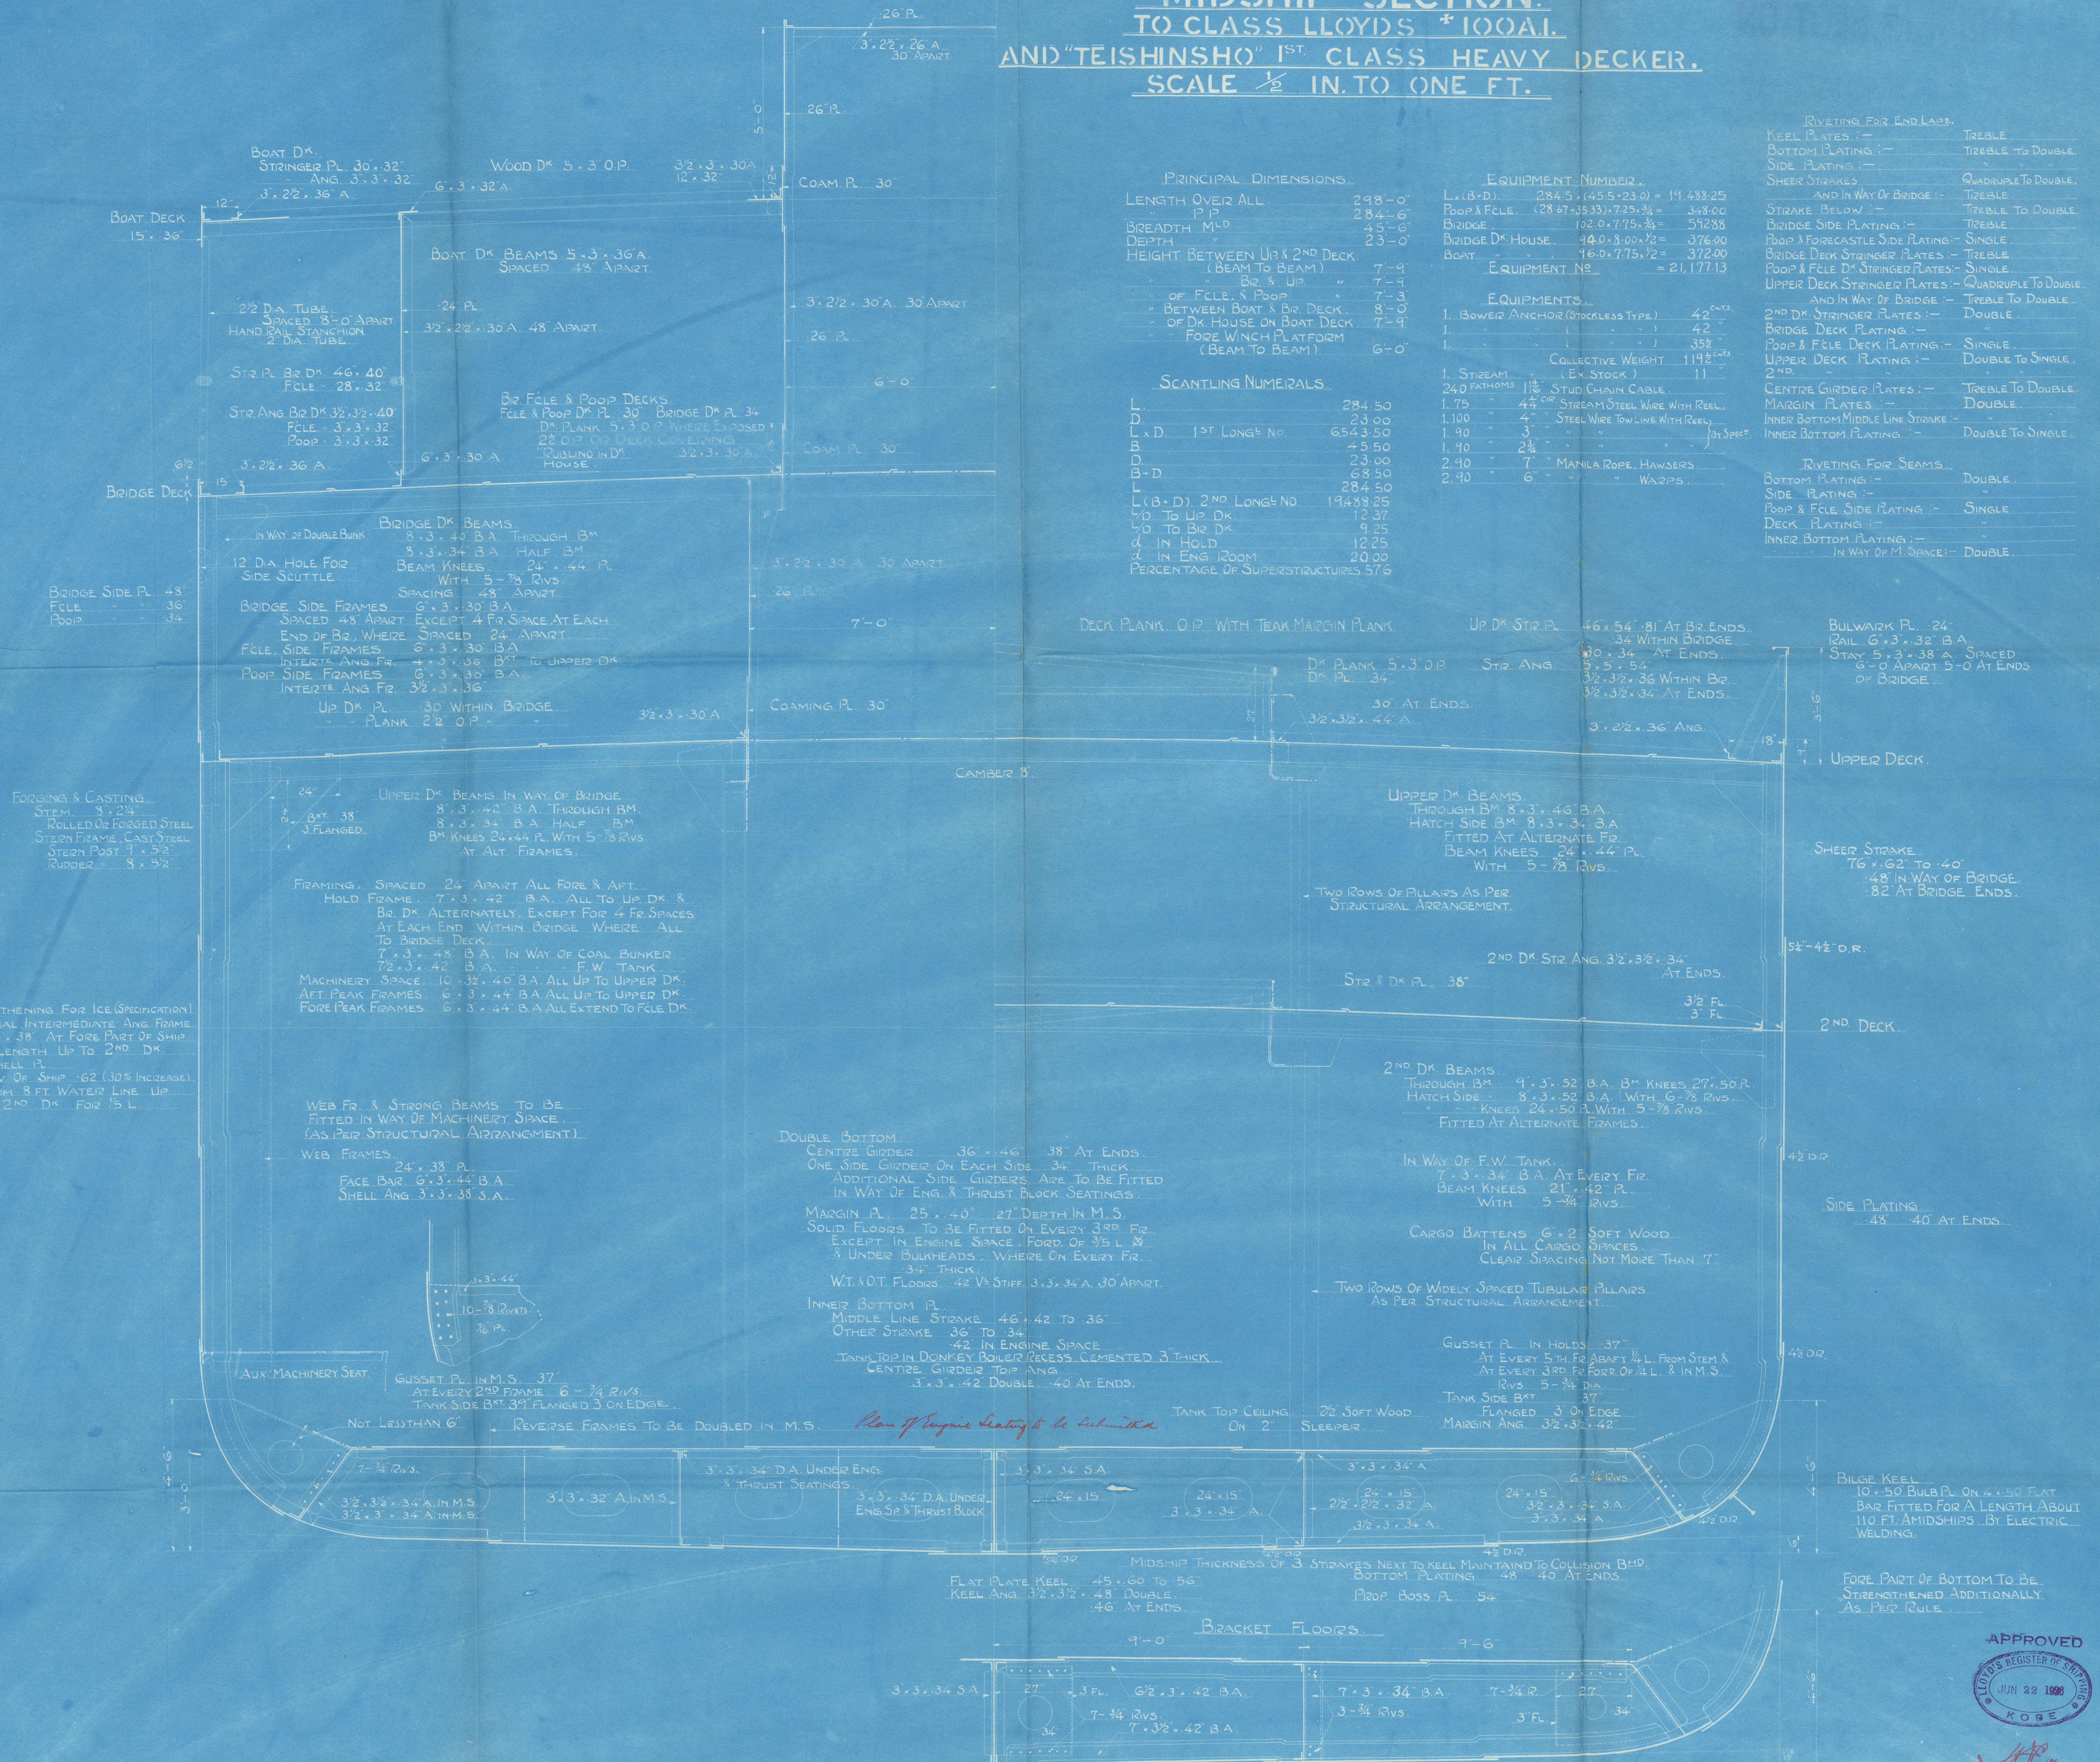

APPROVED
 LLOYD'S REGISTER OF SHIPPING
 JUN 22 1898
 KOBÉ

2021


Lloyd's Register Foundation

NO 1095
MIDSHIP SECTION

M.V. "CHOKO MARU"
KOBE. 5767.

(REVISED)

GEN. BOX NO 861.

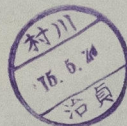

© 2021

Lloyd's Register
Foundation

W1331- 0078