

Nº 902 S.S. KOHSO MARU.

MIDSHIP SECTION


SCALE $\frac{1}{2}$ IN. TO ONE FT.

LENGTH	B.P.	305'-0"
BREADTH	MLD.	43'-9"
DEPTH	MLD.	27'-3"

LLOYD'S NUMERALS.

BREADTH	43.75	
DEPTH	27.25	
LENGTH	71.00	1ST NUMBER
	305.00	
	21655.00	2ND NUMBER

L/D TO UPPER DECK	11.20
L/D TO BRIDGE DECK	8.90


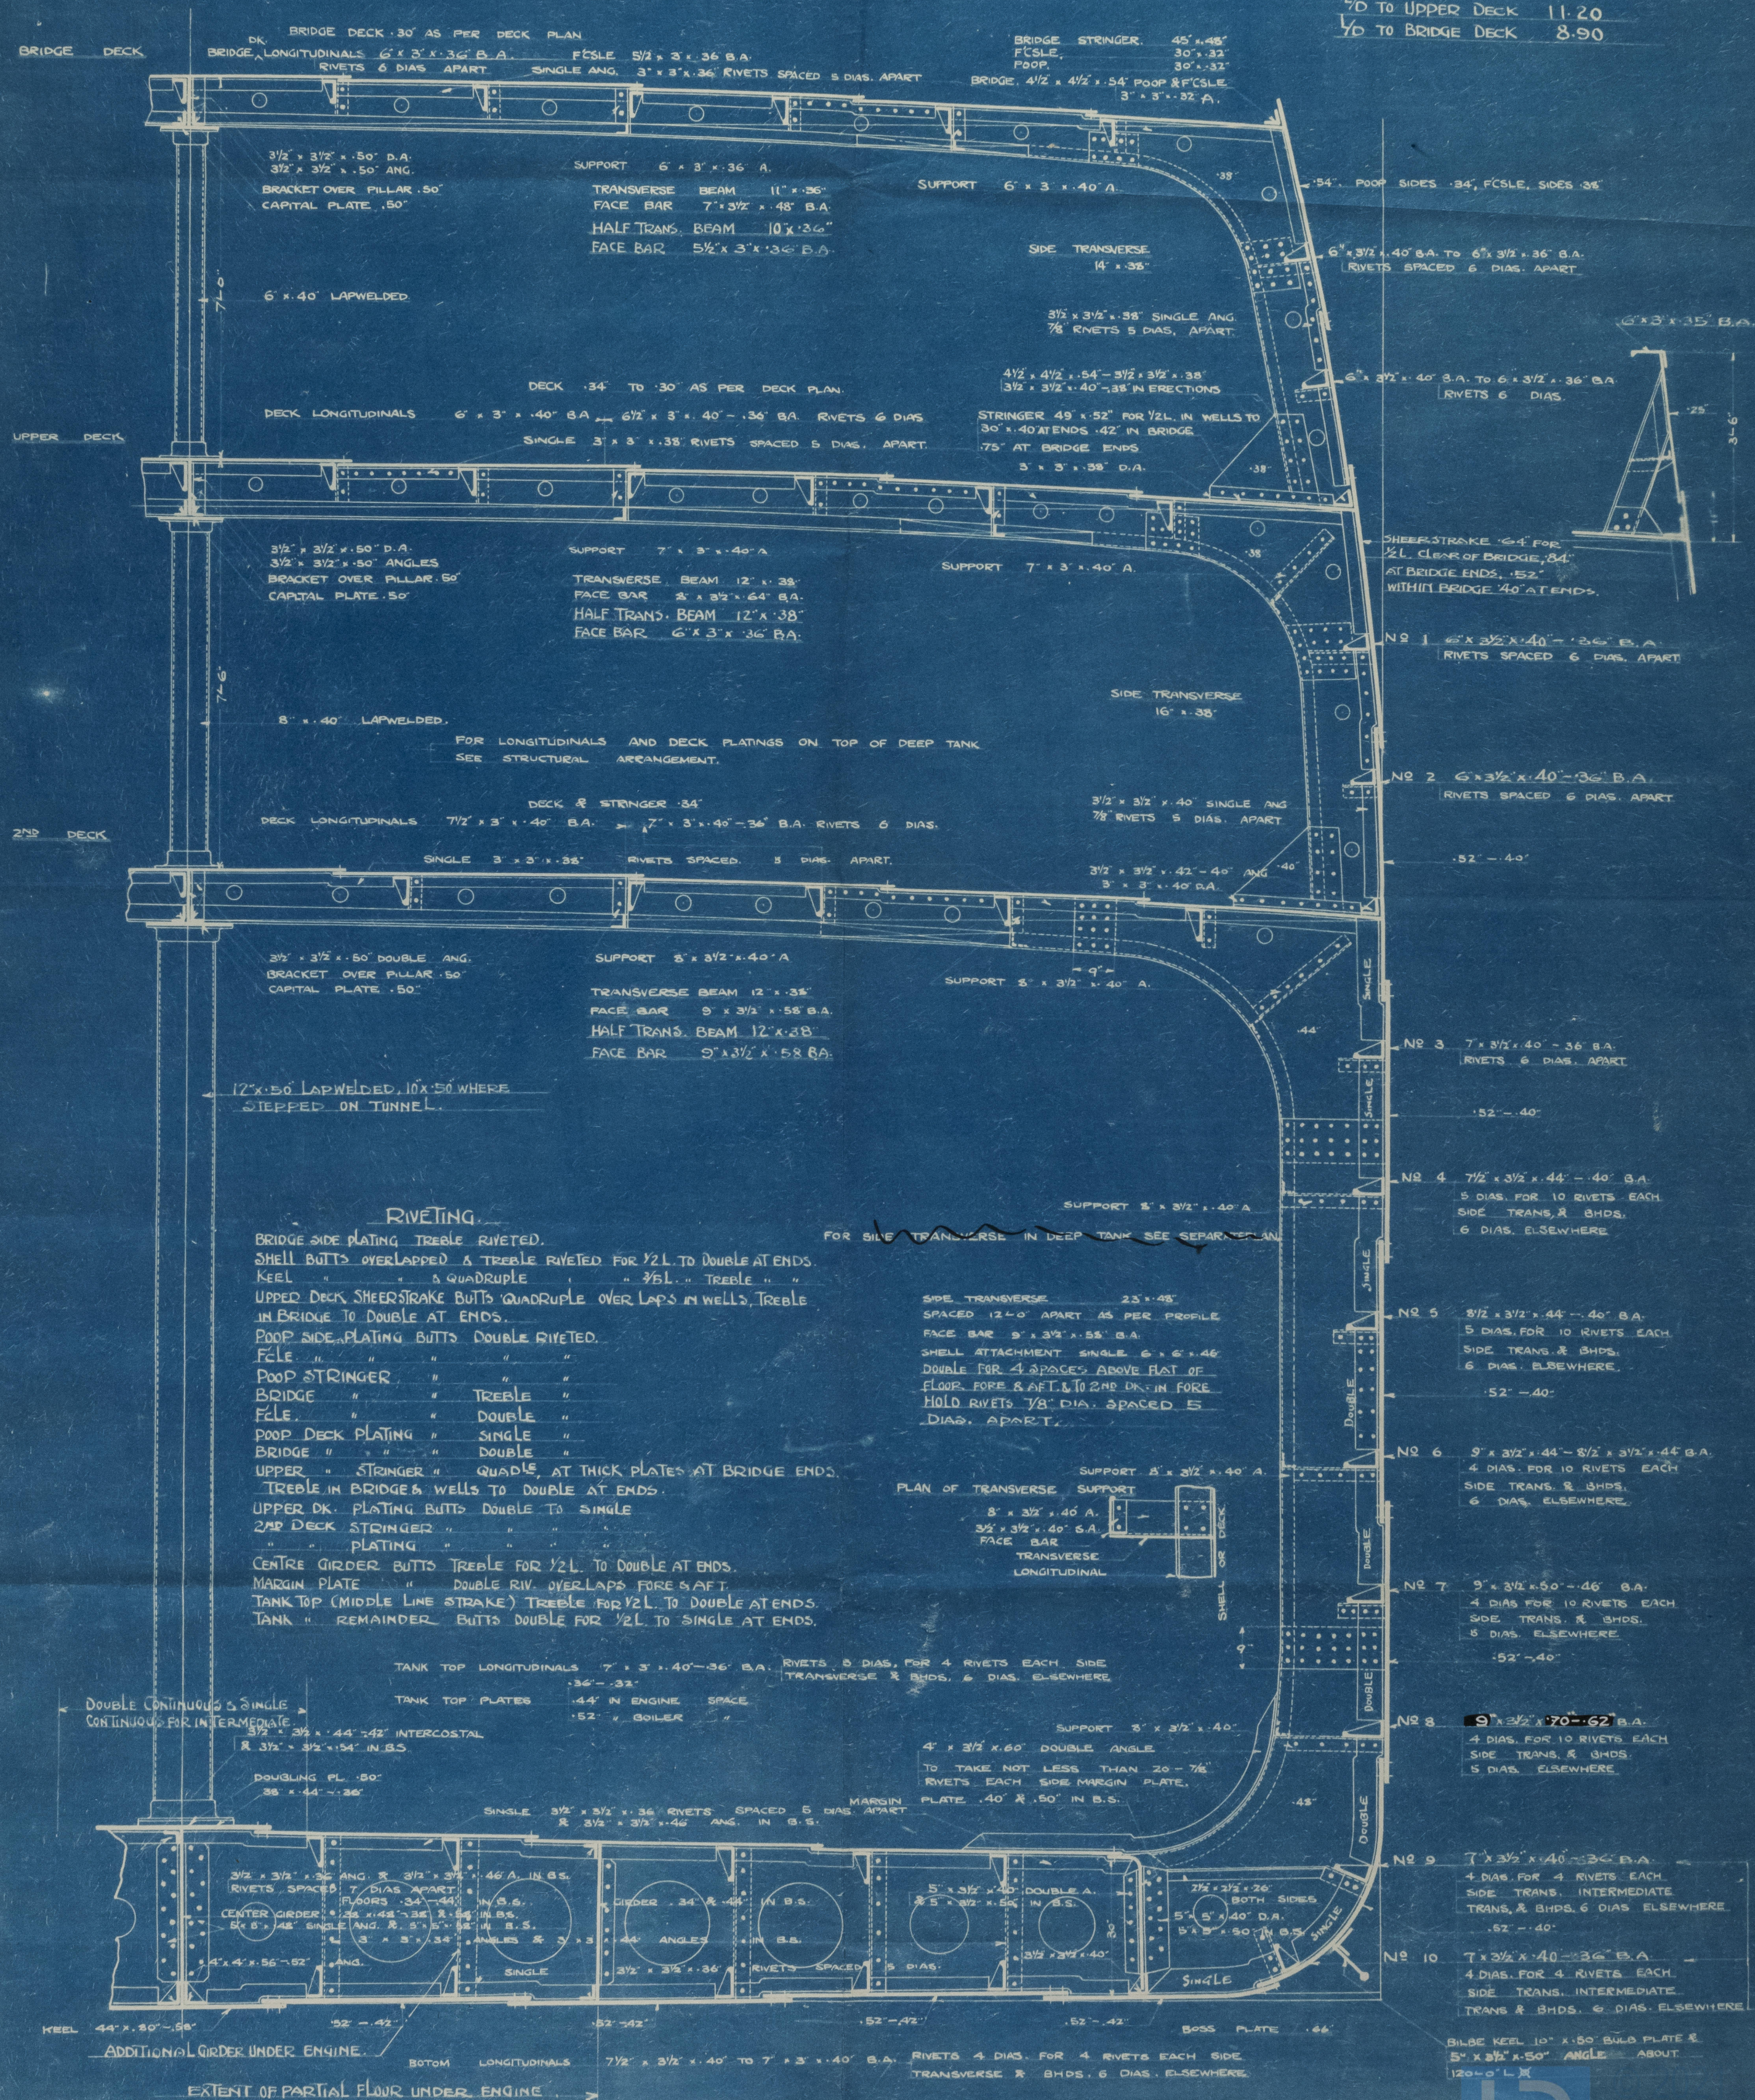


S. S. Kohso Maru
Osaka Iron Works

Yt. no 902

Midship Section

Kobe Rpt No. 2142

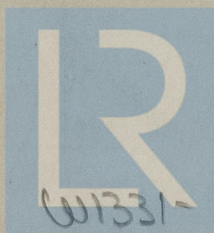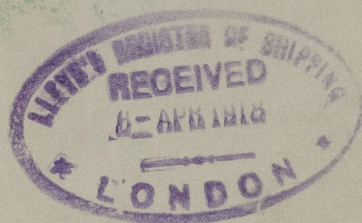

© 2021

Lloyd's Register
Foundation