



SCALE $\frac{1}{4}$ INCH

PLAN No. 4574.
FOR ENCLOSURE TO
MESSRS LLOYDS SURVEYOR.
HULL. FROM
COCHRANE & SONS, LTD.
SHIPBUILDERS, SEELY
DATE 2/17/14. (S.W.)

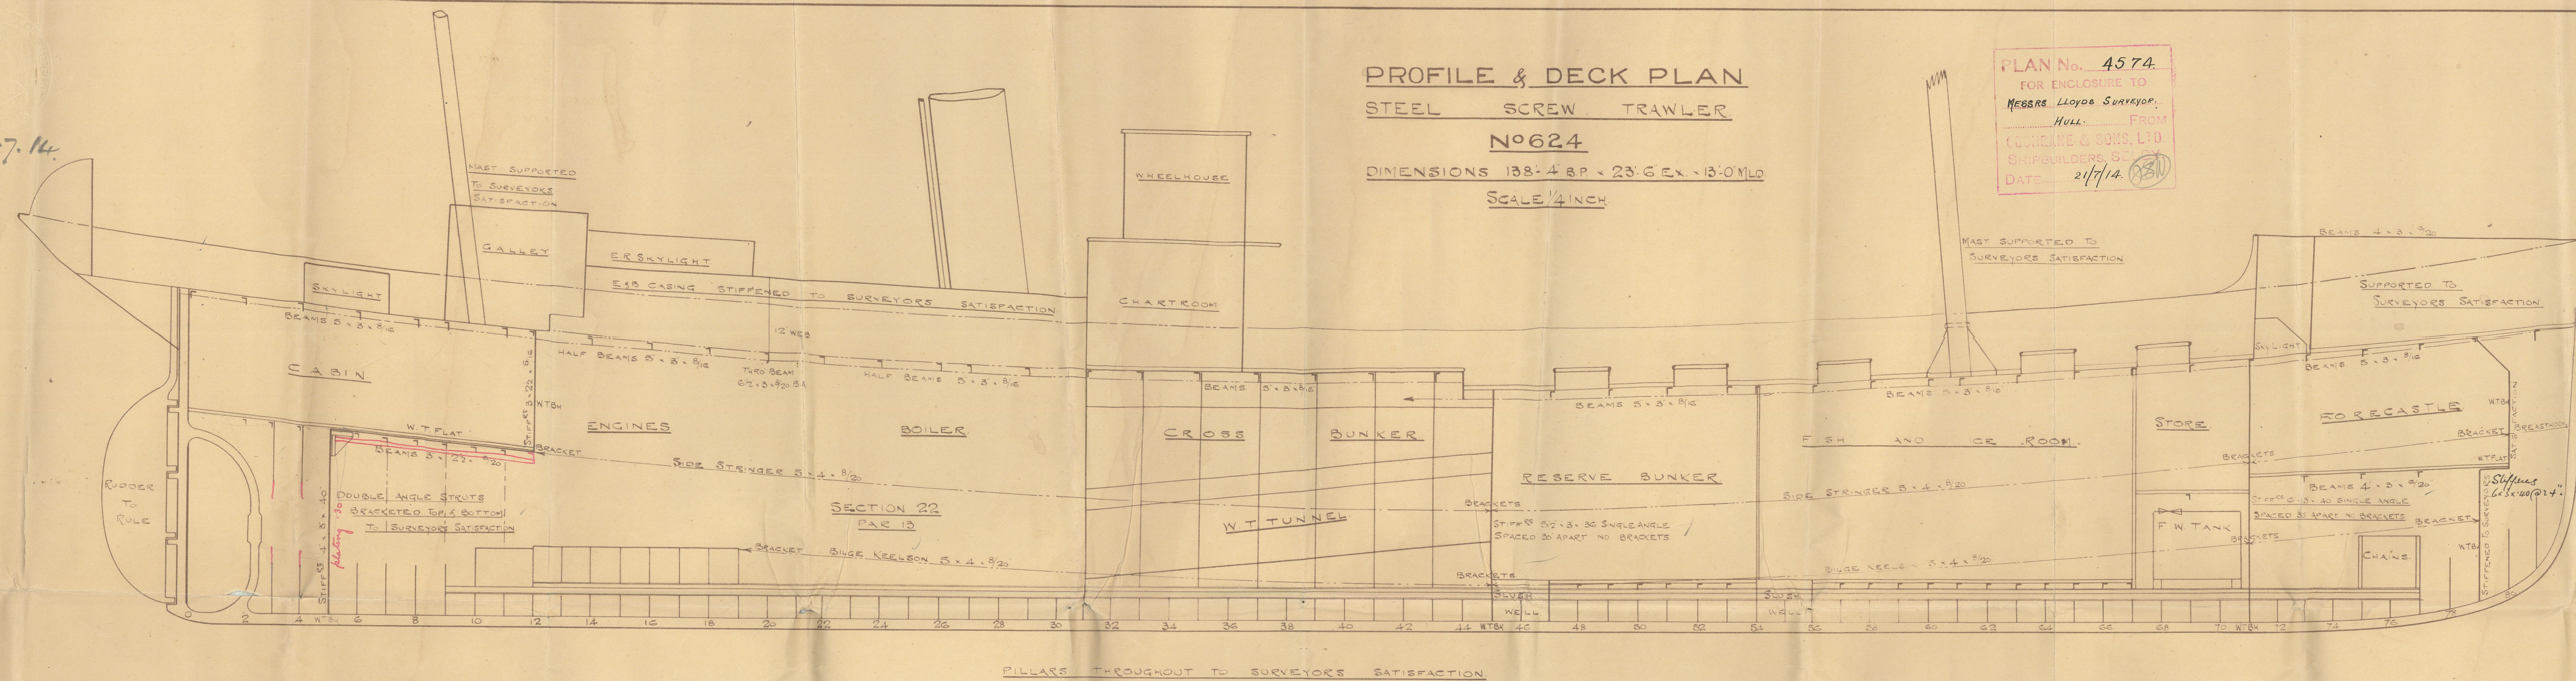

Jul.
24. 7. 14

Profits & Decks.

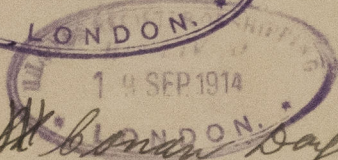

£/6 At Conner Bay.

Bull rept. no. 28375-

Lloyd's Register
Foundation