


Copy of plan
10/9/17

- N° 719 - PROFILE & DECK PLANS.

DIMENSIONS: LENGTH 87'4"00" BREADTH 14'0"00" DEPTH 14'3"10"


(SHEERWOOD SYSTEM (PATENT))

SCALE 1/4" = 1'0"

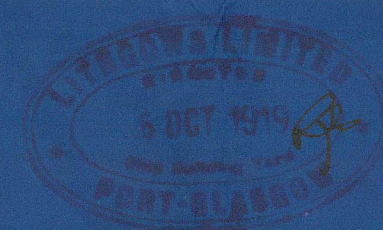

PLAN OF OIL-TIGHT COVERS
TO BE ARRANGED.

TRUNK TRANSFERS IN WAY OF
MATCHWAYS IN OIL TANKS
SCALE 1/2" = 1'00"

 

Sketch showing strengthening
of bottom forward to be submitted.

30
10/9/17

Longitudinal Chan
88 War Sackwar
Lithgow Limited no 719
brk pte bpt no 17540



© 2021

Lloyd's Register
Foundation