
 
 


$\frac{3}{4}$  to be classed 100. A.1. at Lloyds.

Wheel House	
Room 7 captain's Room.	

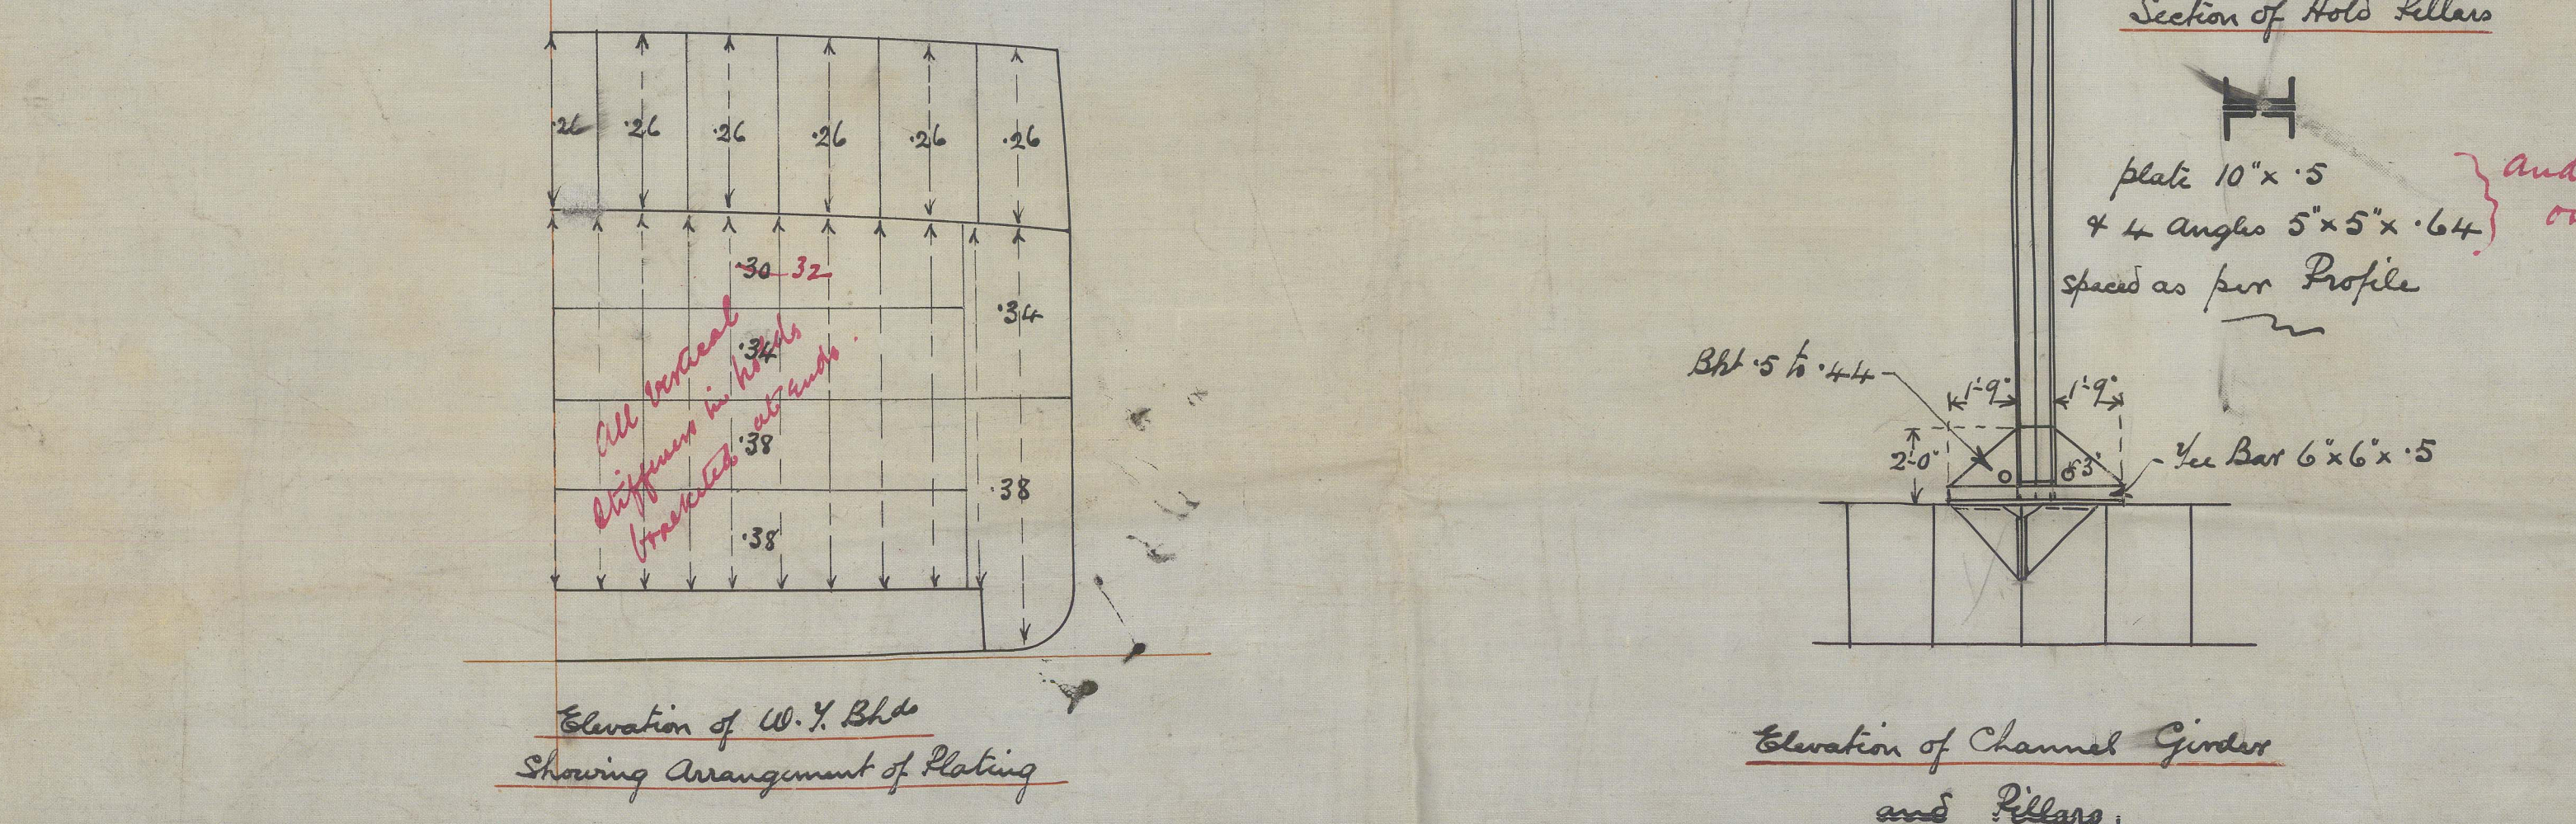

Deck Riving

Bats marked	Two	are	quadruple rived
"	"	"	Trible
"	"	"	Double
"	"	"	Single

---

Note: Upper Deck except Stringer has been increased .04 above Rule (for Spec)

6.809



Profile & Deck Plan  
Mess Napier, Miller & Co.

S.S. No. 169

S/S. 'Deu of Glamis'

29/131



© 2021

Lloyd's Register  
Foundation

WP339-0195