

S. S. N^o 133 MIDSHIP SECTION



DIMS.:- LENGTH 204'-0" BREADTH MLP 43'-9" DEPTH MLP 23'-6".

CLASS + 100 A.I. LLOYDS

SCALE 1/2" = 1 FT

NUMERALS.

L x D	294 x 23.5	=	6980
L x (B+D)	294 x (43.45 + 23.5)	=	19945
1/2 To UPPER DECK		=	12.64
" " BRIDGE "		=	9.686
" " "		=	19.896
LENGTH COVERED		=	42.88%

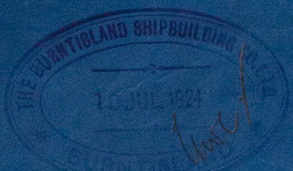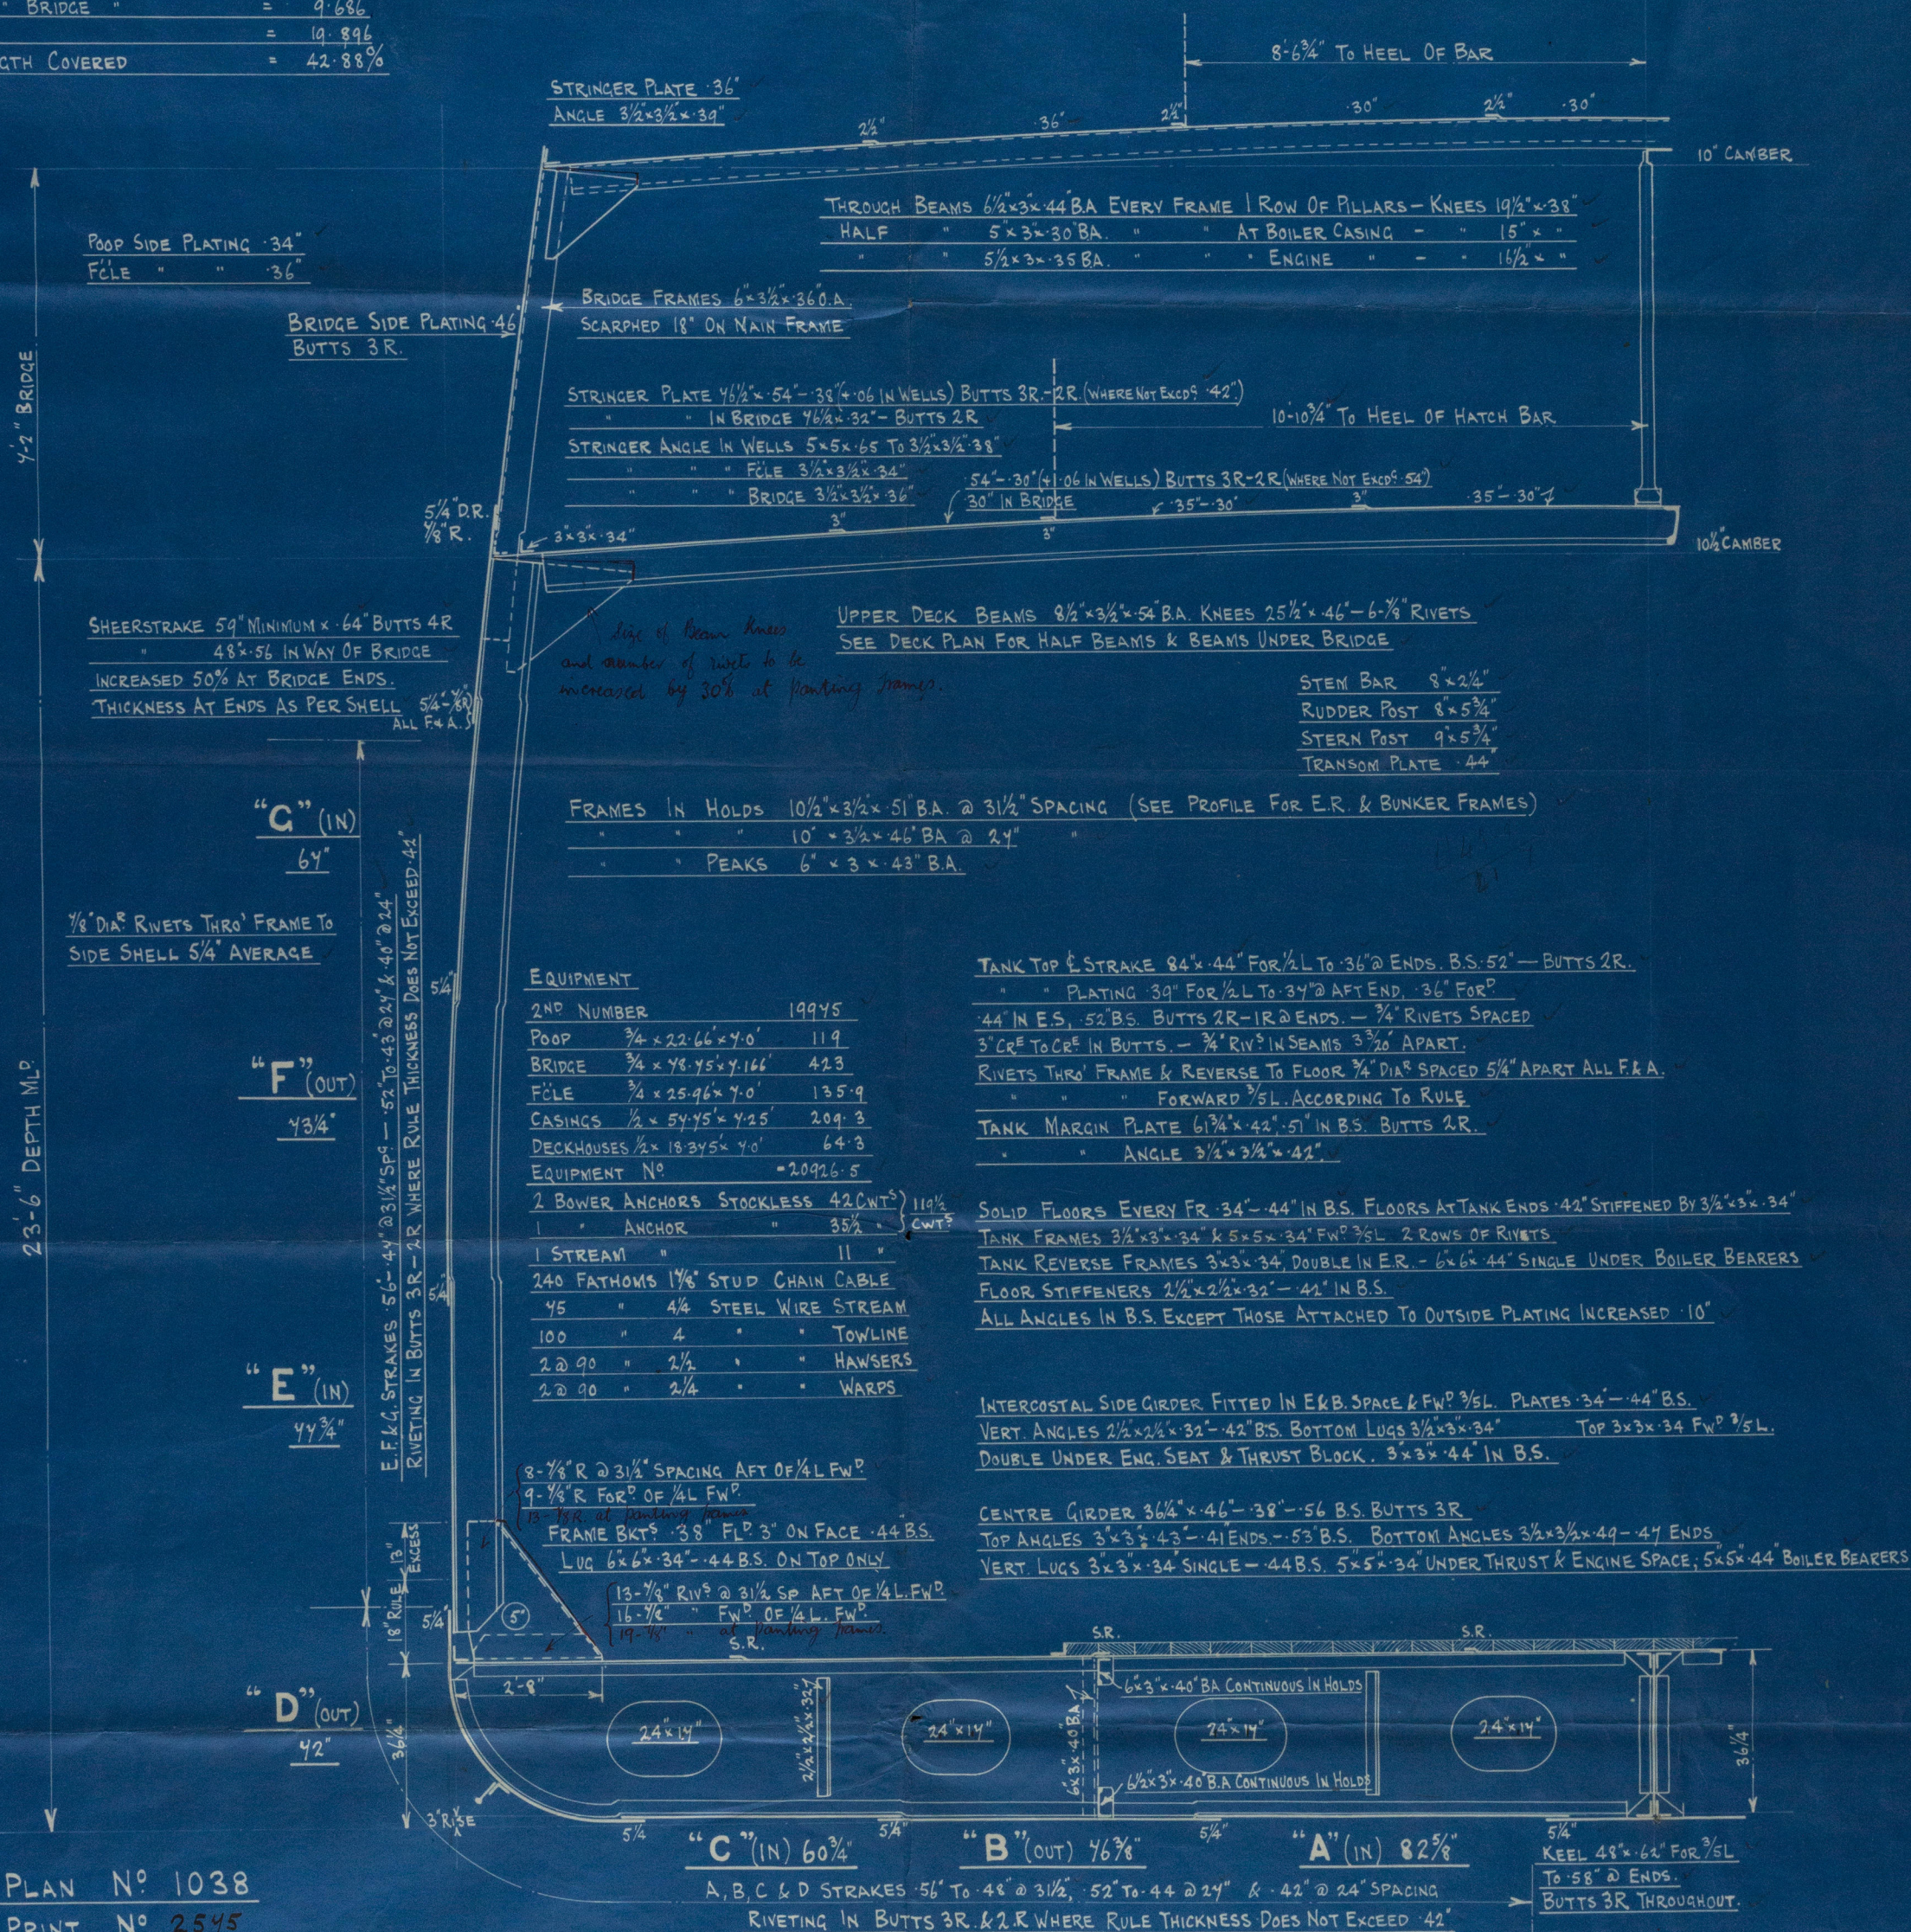

W134-0054


Us. 133.

Widship Section.

S. Markport N.N. "Balding"
Lth 16714

© 2019

Lloyd's Register
Foundation
W134-0054