


Revised

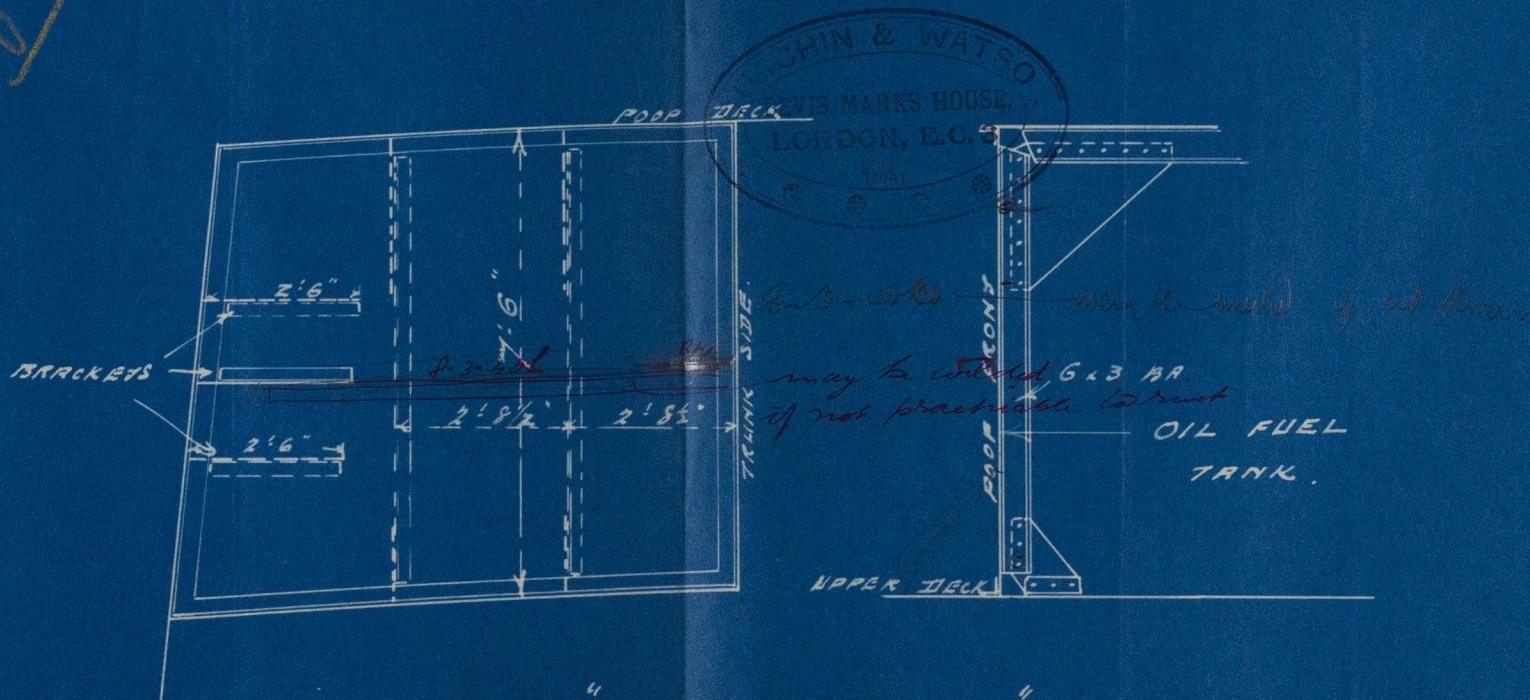

M.V. "WELLFIELD"


POOP FRONT STIFFENING.

1/2" SCALE.

W134-0141

10 Mr. 31

S.S. Wellfield
NWC 87999

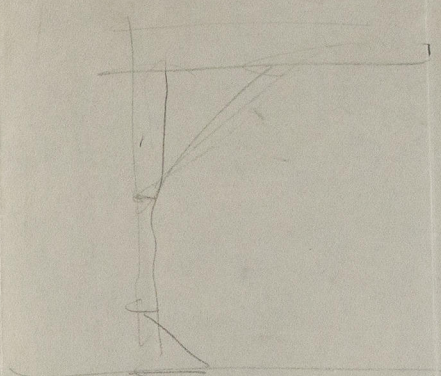

W134-0141



© 2019

Lloyd's Register
Foundation