



M. V. "WELLFIELD."
FORE HOLD HATCH COVER.
1/2" = 1 FOOT.

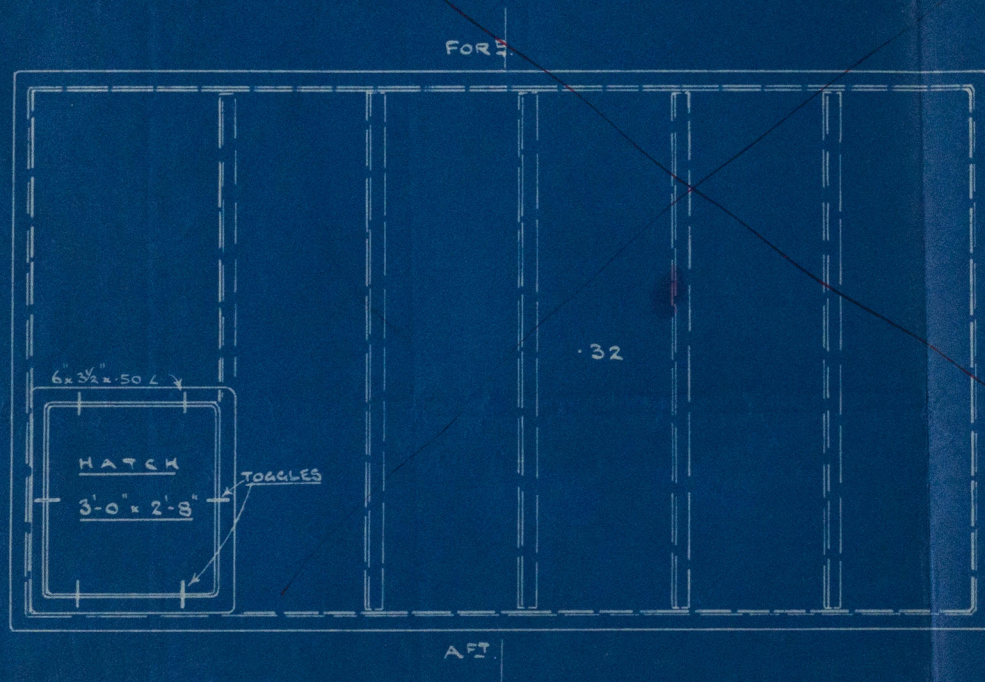

*Stiffeners fitted
 all workshops as per
 plan approved 16/10/31*

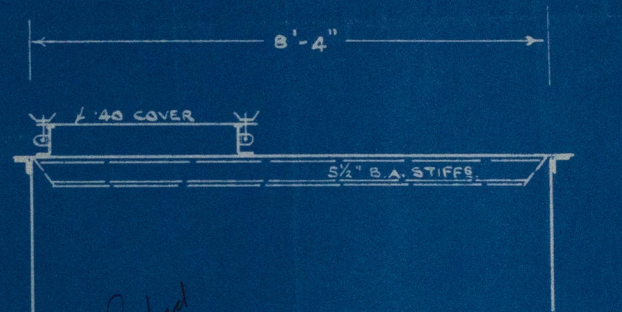

17/10/31
 Lloyd's Register
 Foundation

W1134-0144



M.V. "WELLFIELD"

NEWCASTLE ON TYNE.

Report No. 87999

Wellfield

W134-0144



© 2019

Lloyd's Register
Foundation