


SCALE 1/2" TO ONE FOOT.

SOLID FLOOR TO BE FITTED AT ALTERNATE FRAMES  
EX. IN E.R. UNDER BOILER BEAMS, ROLLERS, AND SOL. FLOOR  
TO COLLISION BMD, WHERE A EVERY FRAME.  
PARTIAL SOLID FLOOR UNDER THRUST RECESS  
2 ADDITIONAL SIDE PLATES FITTED IN E.R.



Tamor. Maru. D/Bay 201.  
esc  
Kaikyu Maru  
Ska 2484.

D.201.

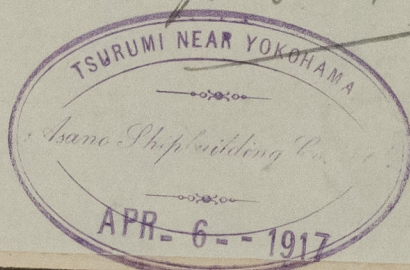

Ship's Name or No. NOS. 16 - 18.		X
Name	Midship section.	
of		
Drawing		
P. No.	Sending No.	2115

RETAIN



© 2021

Lloyd's Register  
Foundation  
W1341-0044



Asano



© 2021

Lloyd's Register  
Foundation