
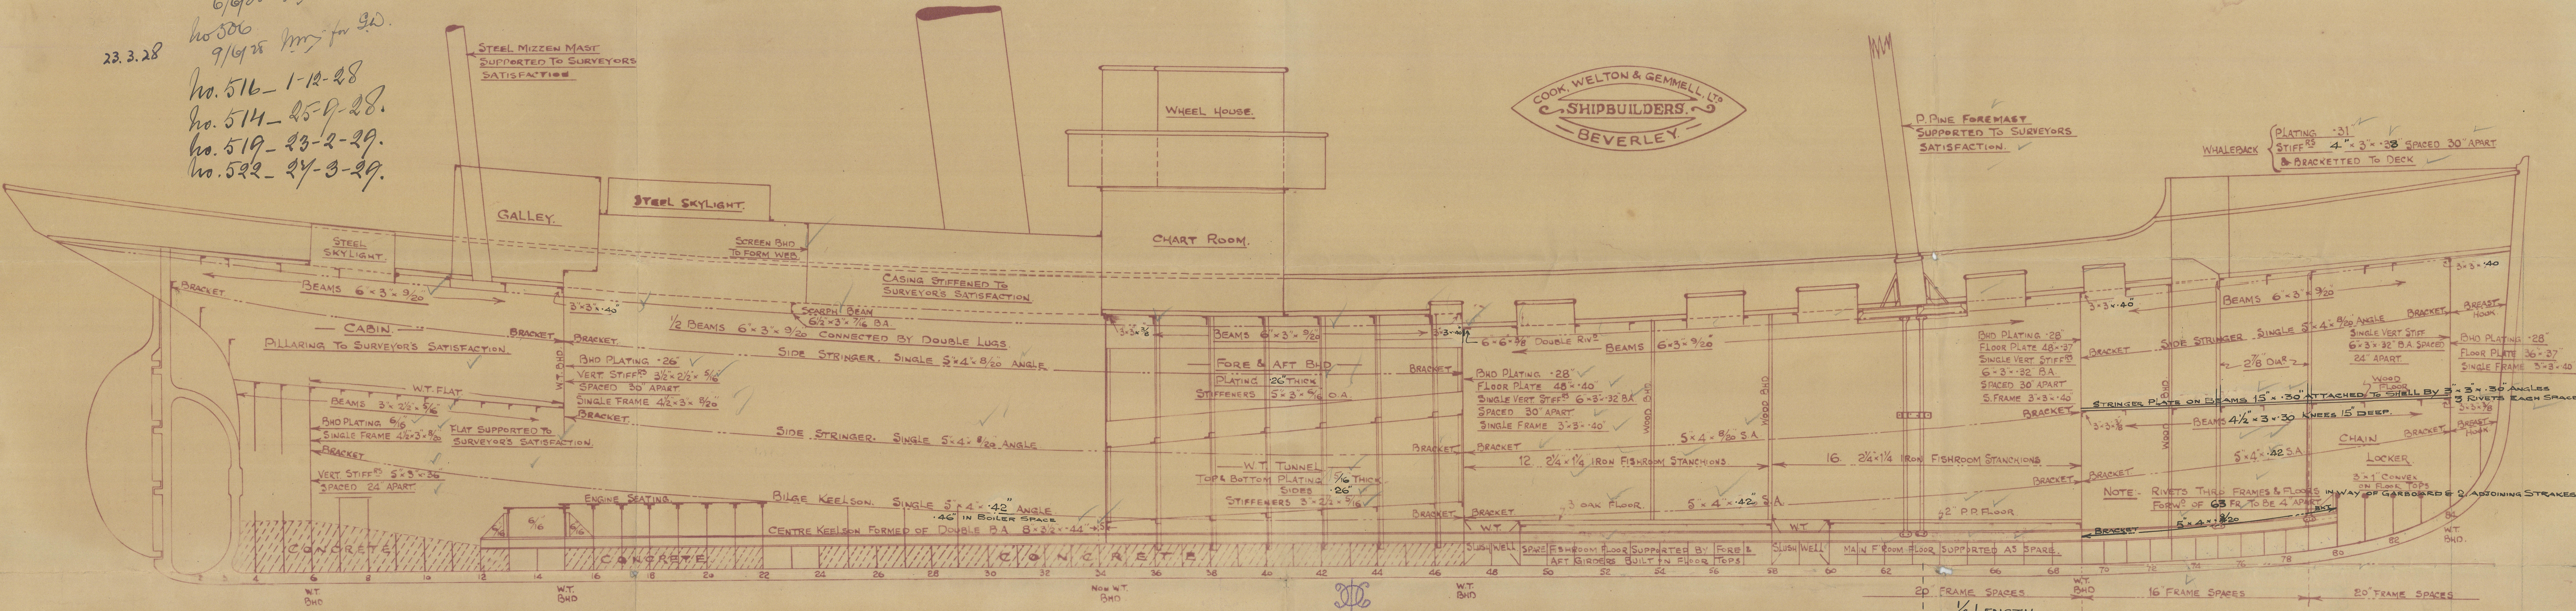


23.3.28

no. 505
6/6/28 m. for S.D.
no. 506
9/6/28 m. for S.D.
no. 516-1-12-28
no. 514-25-9-28
no. 519-23-2-29
no. 522-24-3-29

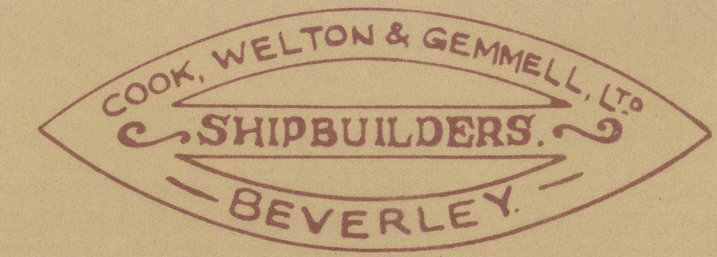


PROFILE AND DECKS.

PILLARING THROUGHOUT TO SURVEYORS' SATISFACTION.
DIMENSIONS:- 140-0" BP x 24-0" EXT. x 13-9" MLD DEPTH.
SCALE 1/4" = 1 FOOT.

N^{os} 485-6-7 & 8. & 492-3

N^o 501-5-6-14-16-19-22

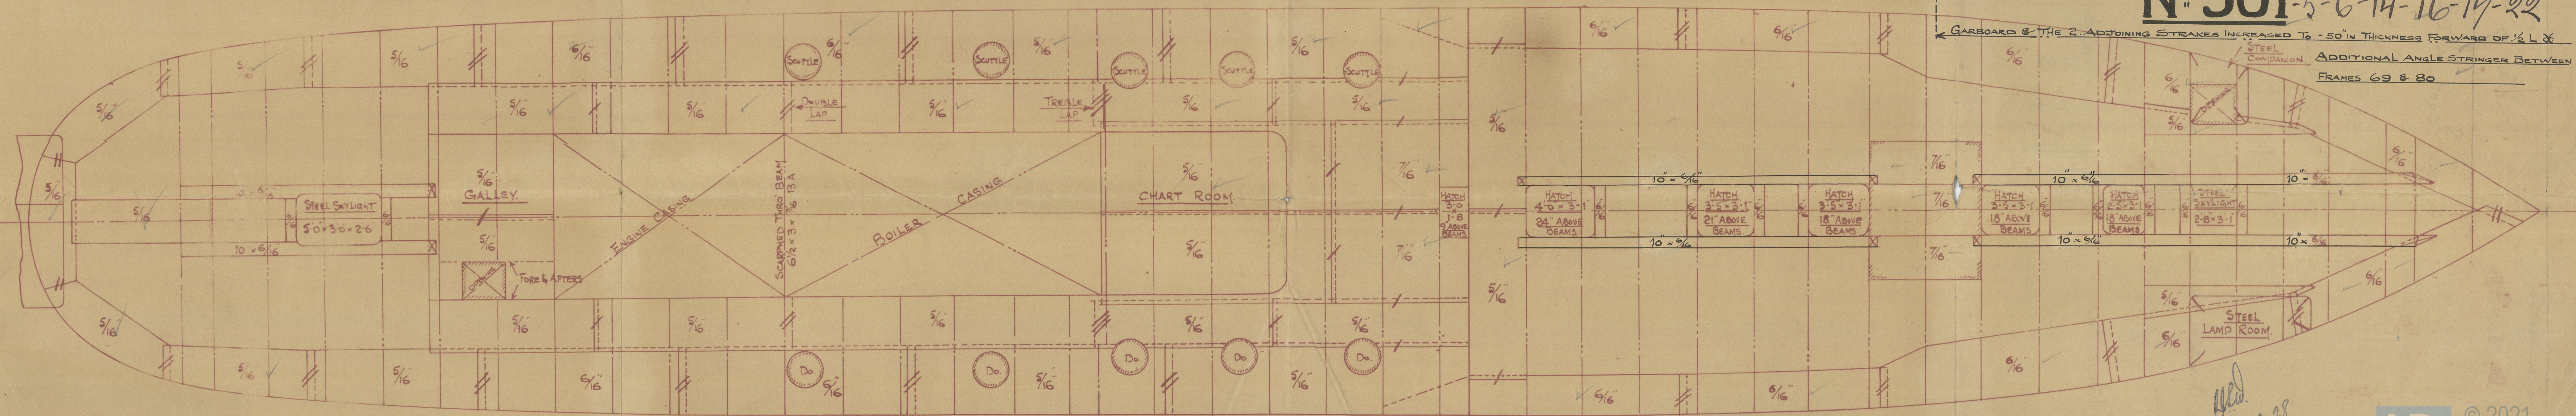

23.3.28

812
S.S. Kingston Sapphire

HULL REPORT No. 39646

816
S.S. Kingston Jacynth

HULL REPORT No. 39463

819
S.S. Kingston Turquoise

HULL REPORT No. 39894

822
S.S. Kingston Peridot

HULL REPORT No. 40049

825
S.S. "Beverlac"

HULL REPORT No. 40159


Week Box 126

Profile & Deck Plan

Book, Walton Symmell's

No. 501-5-6
No. 514-516-519-522-525

801

S.S. "Amethyst" 

HULL REPORT No. 39125

805

S.S. Kingston Jasper

HULL REPORT No. 39394

806

S.S. Kingston Garnet

HULL REPORT No. 39444

Transferred to Lloyd's Register
Rock Emball

W1343-0109

215
See Day sec 4