
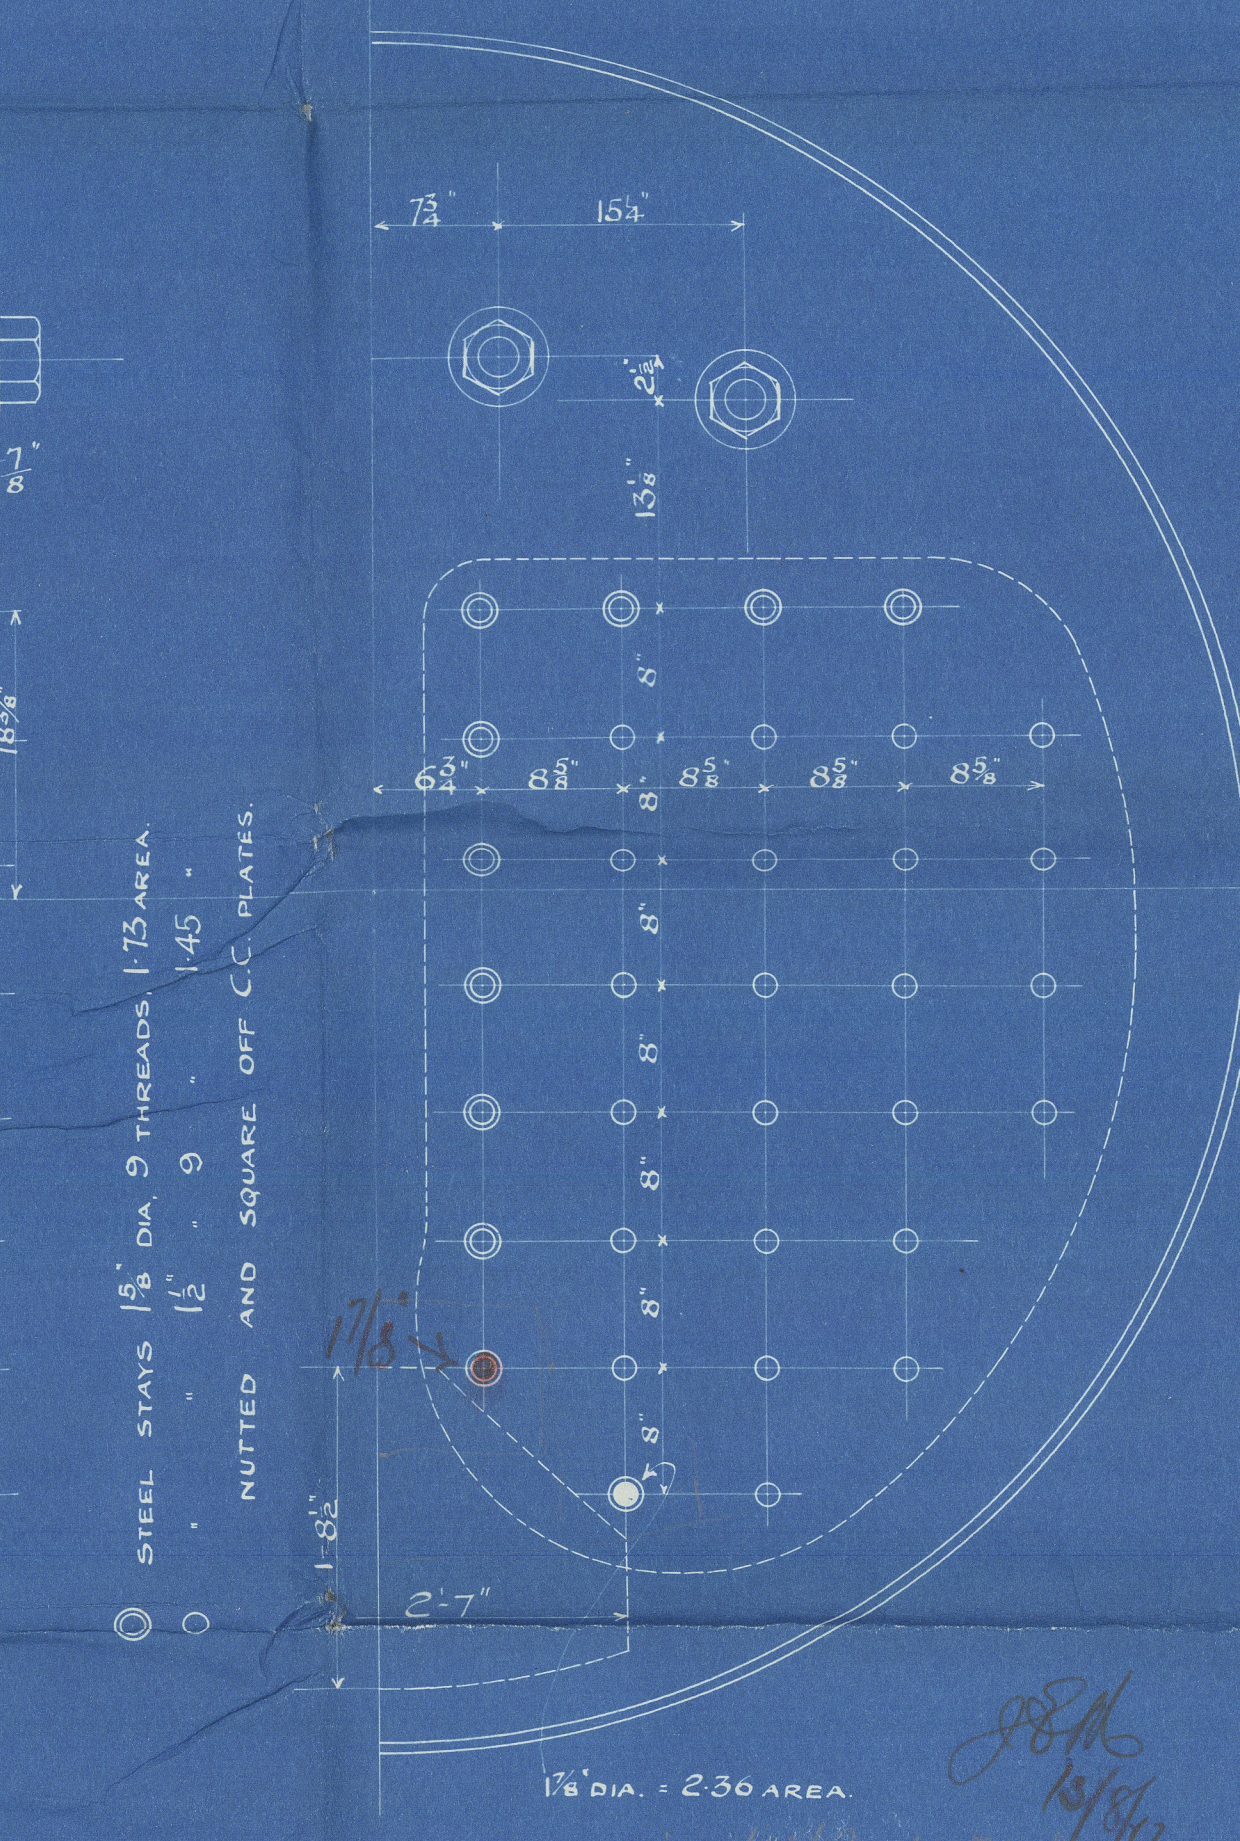
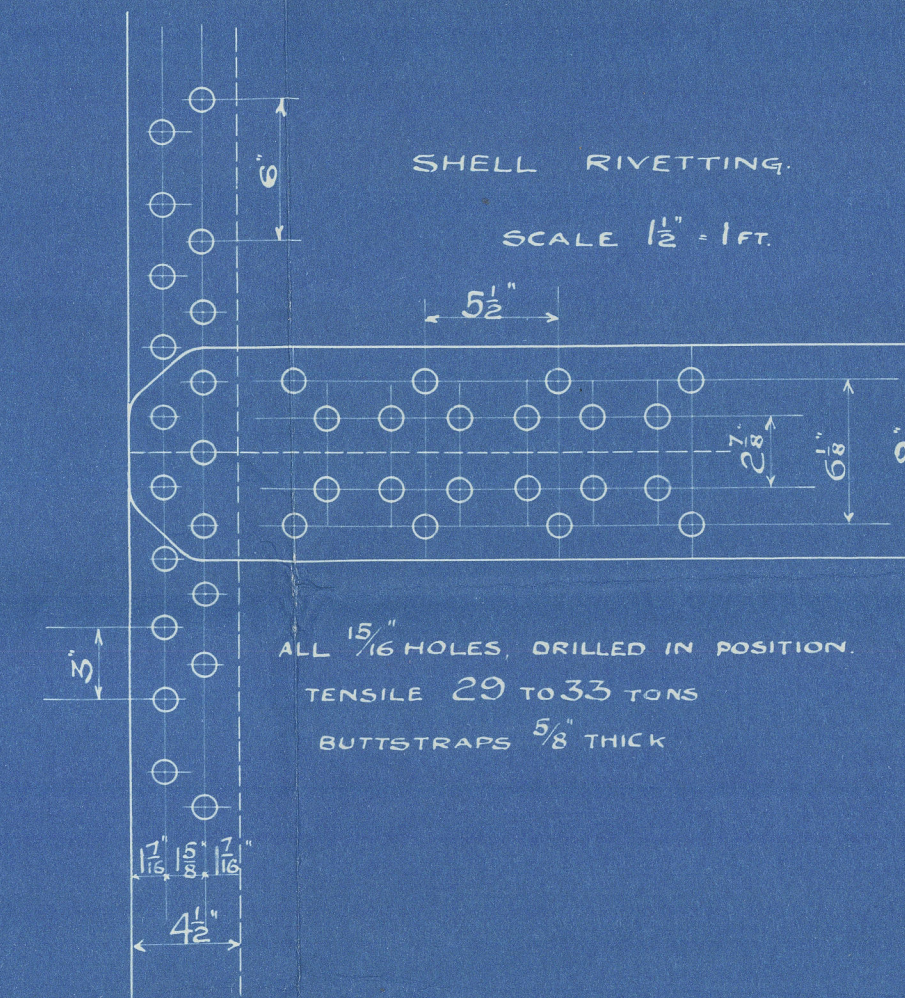
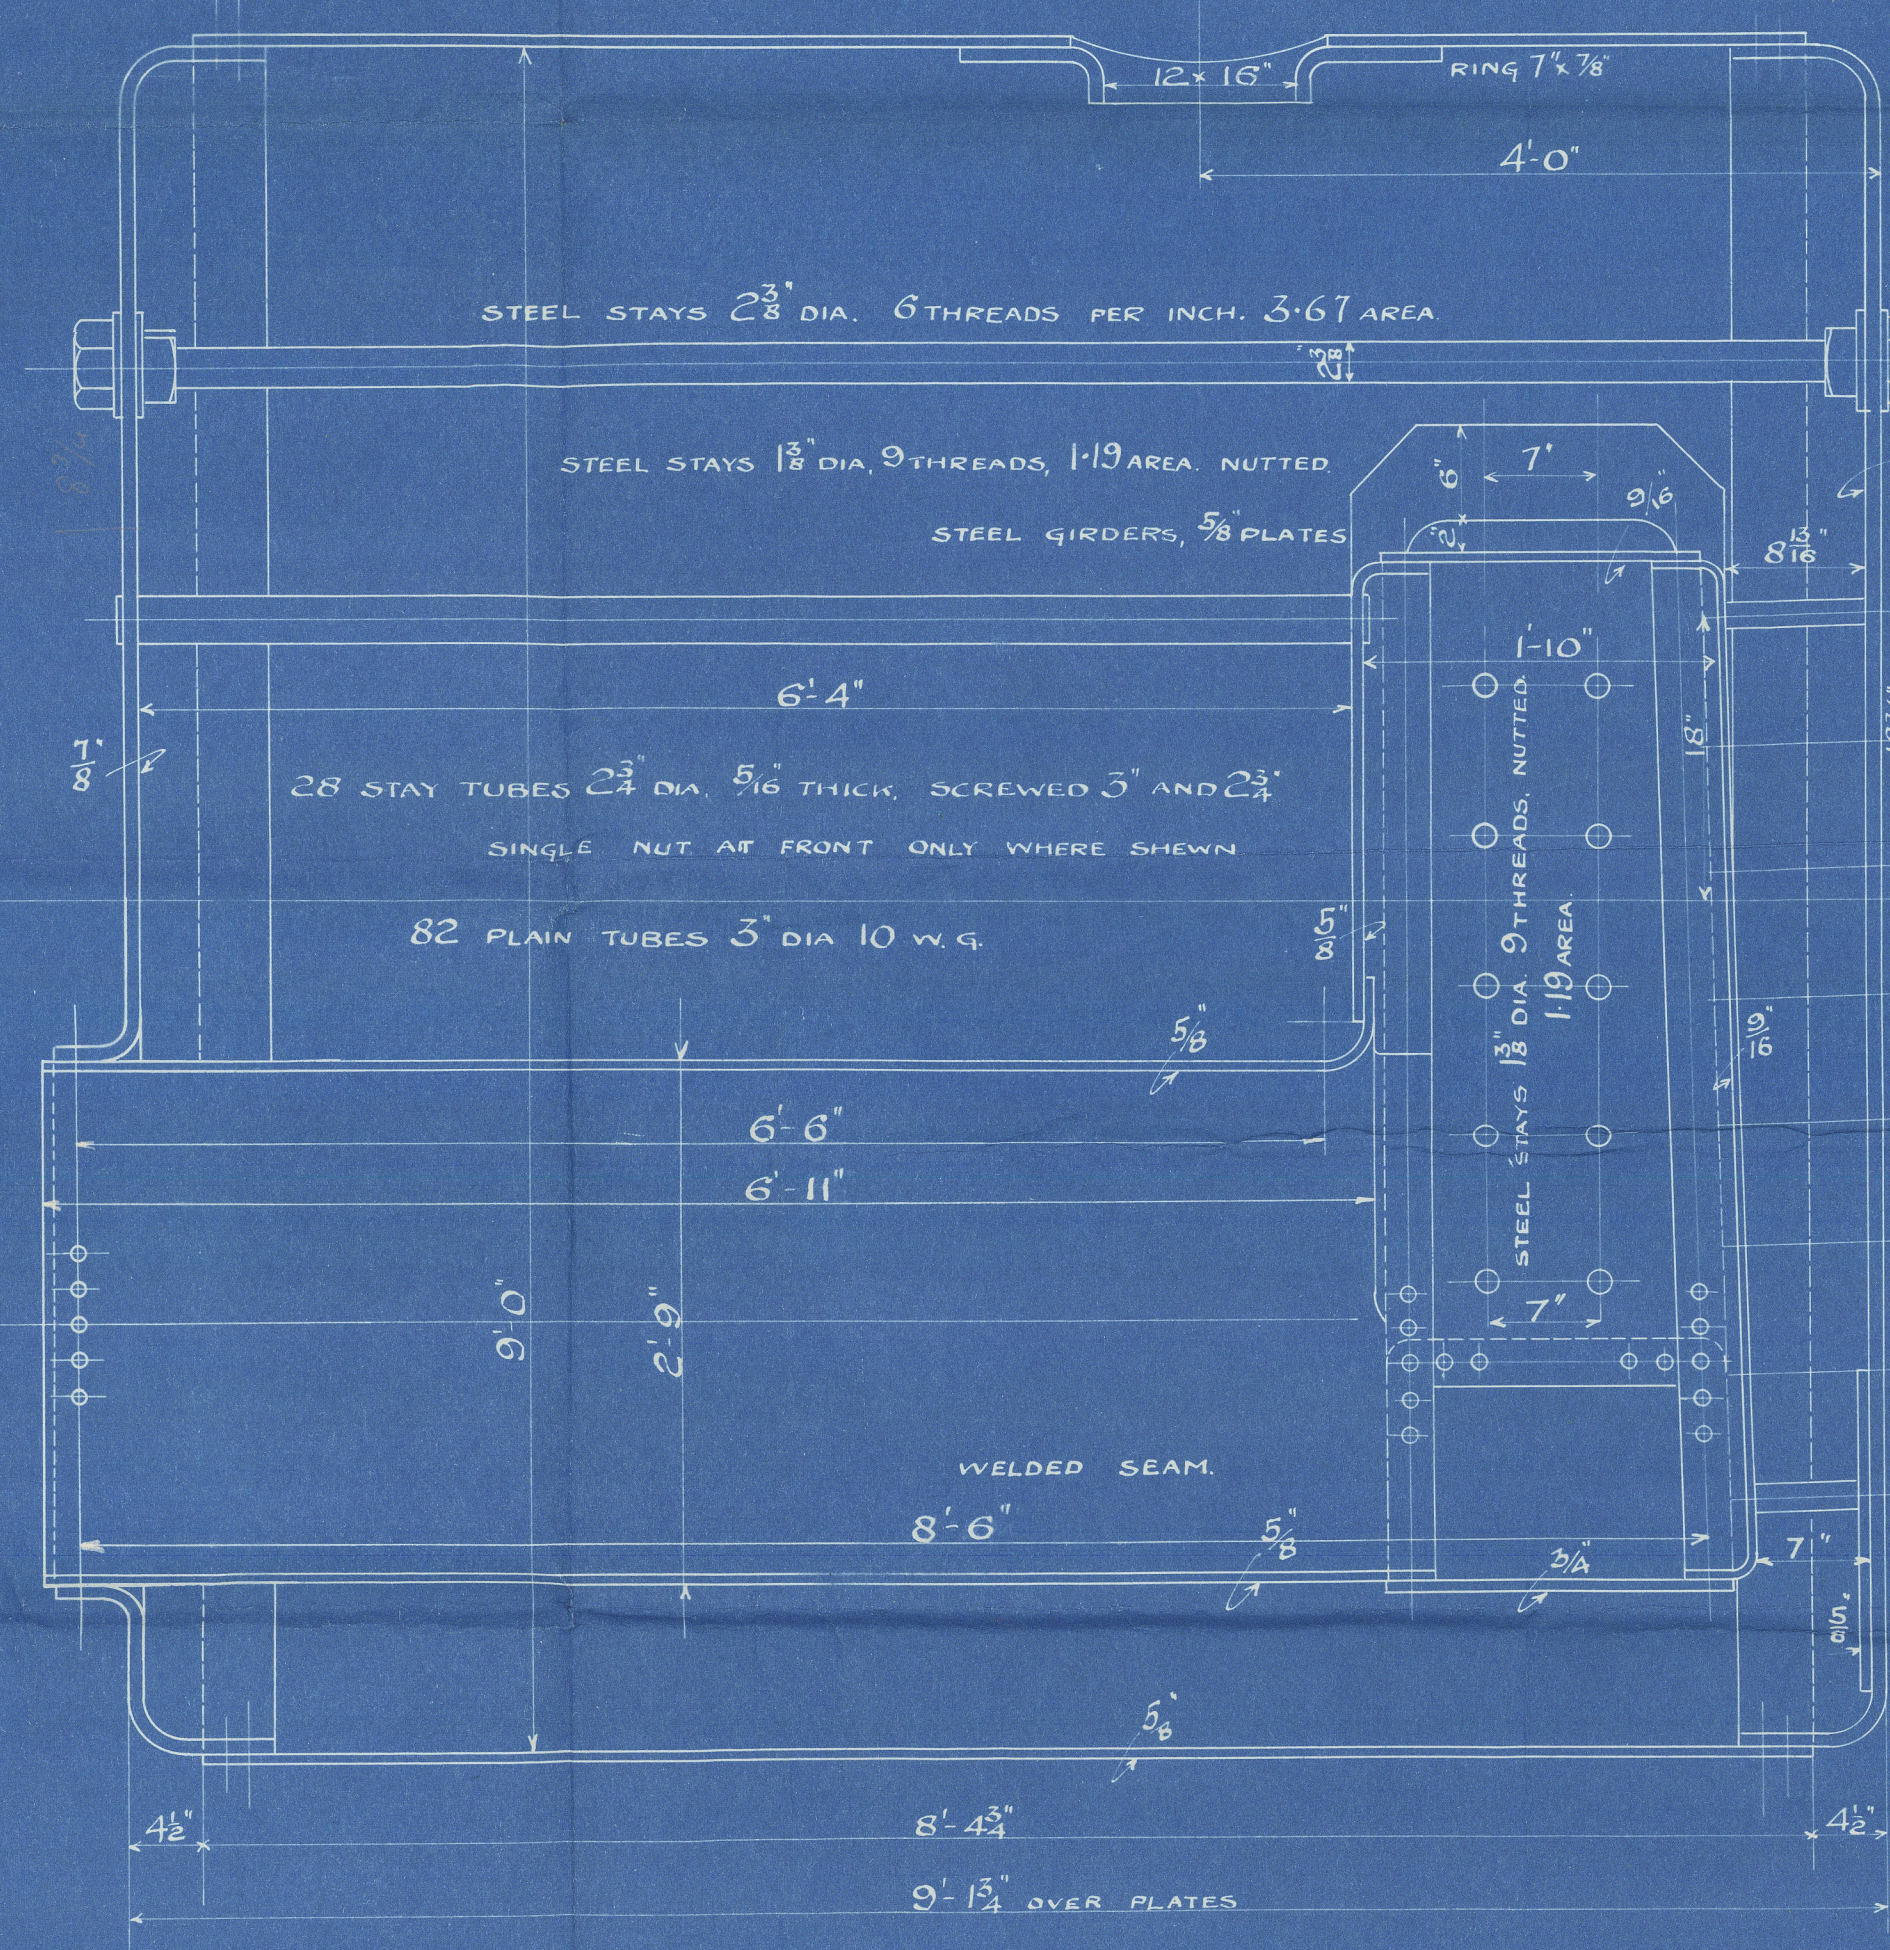



STEEL BOILER 9-0 DIA 9-0 LONG 140 LBS W.P. LLOYDS N^o 4504

14/5/12

RILEY BROS. (BOILERMAKERS) LTD.
STOCKTON ON TEES.

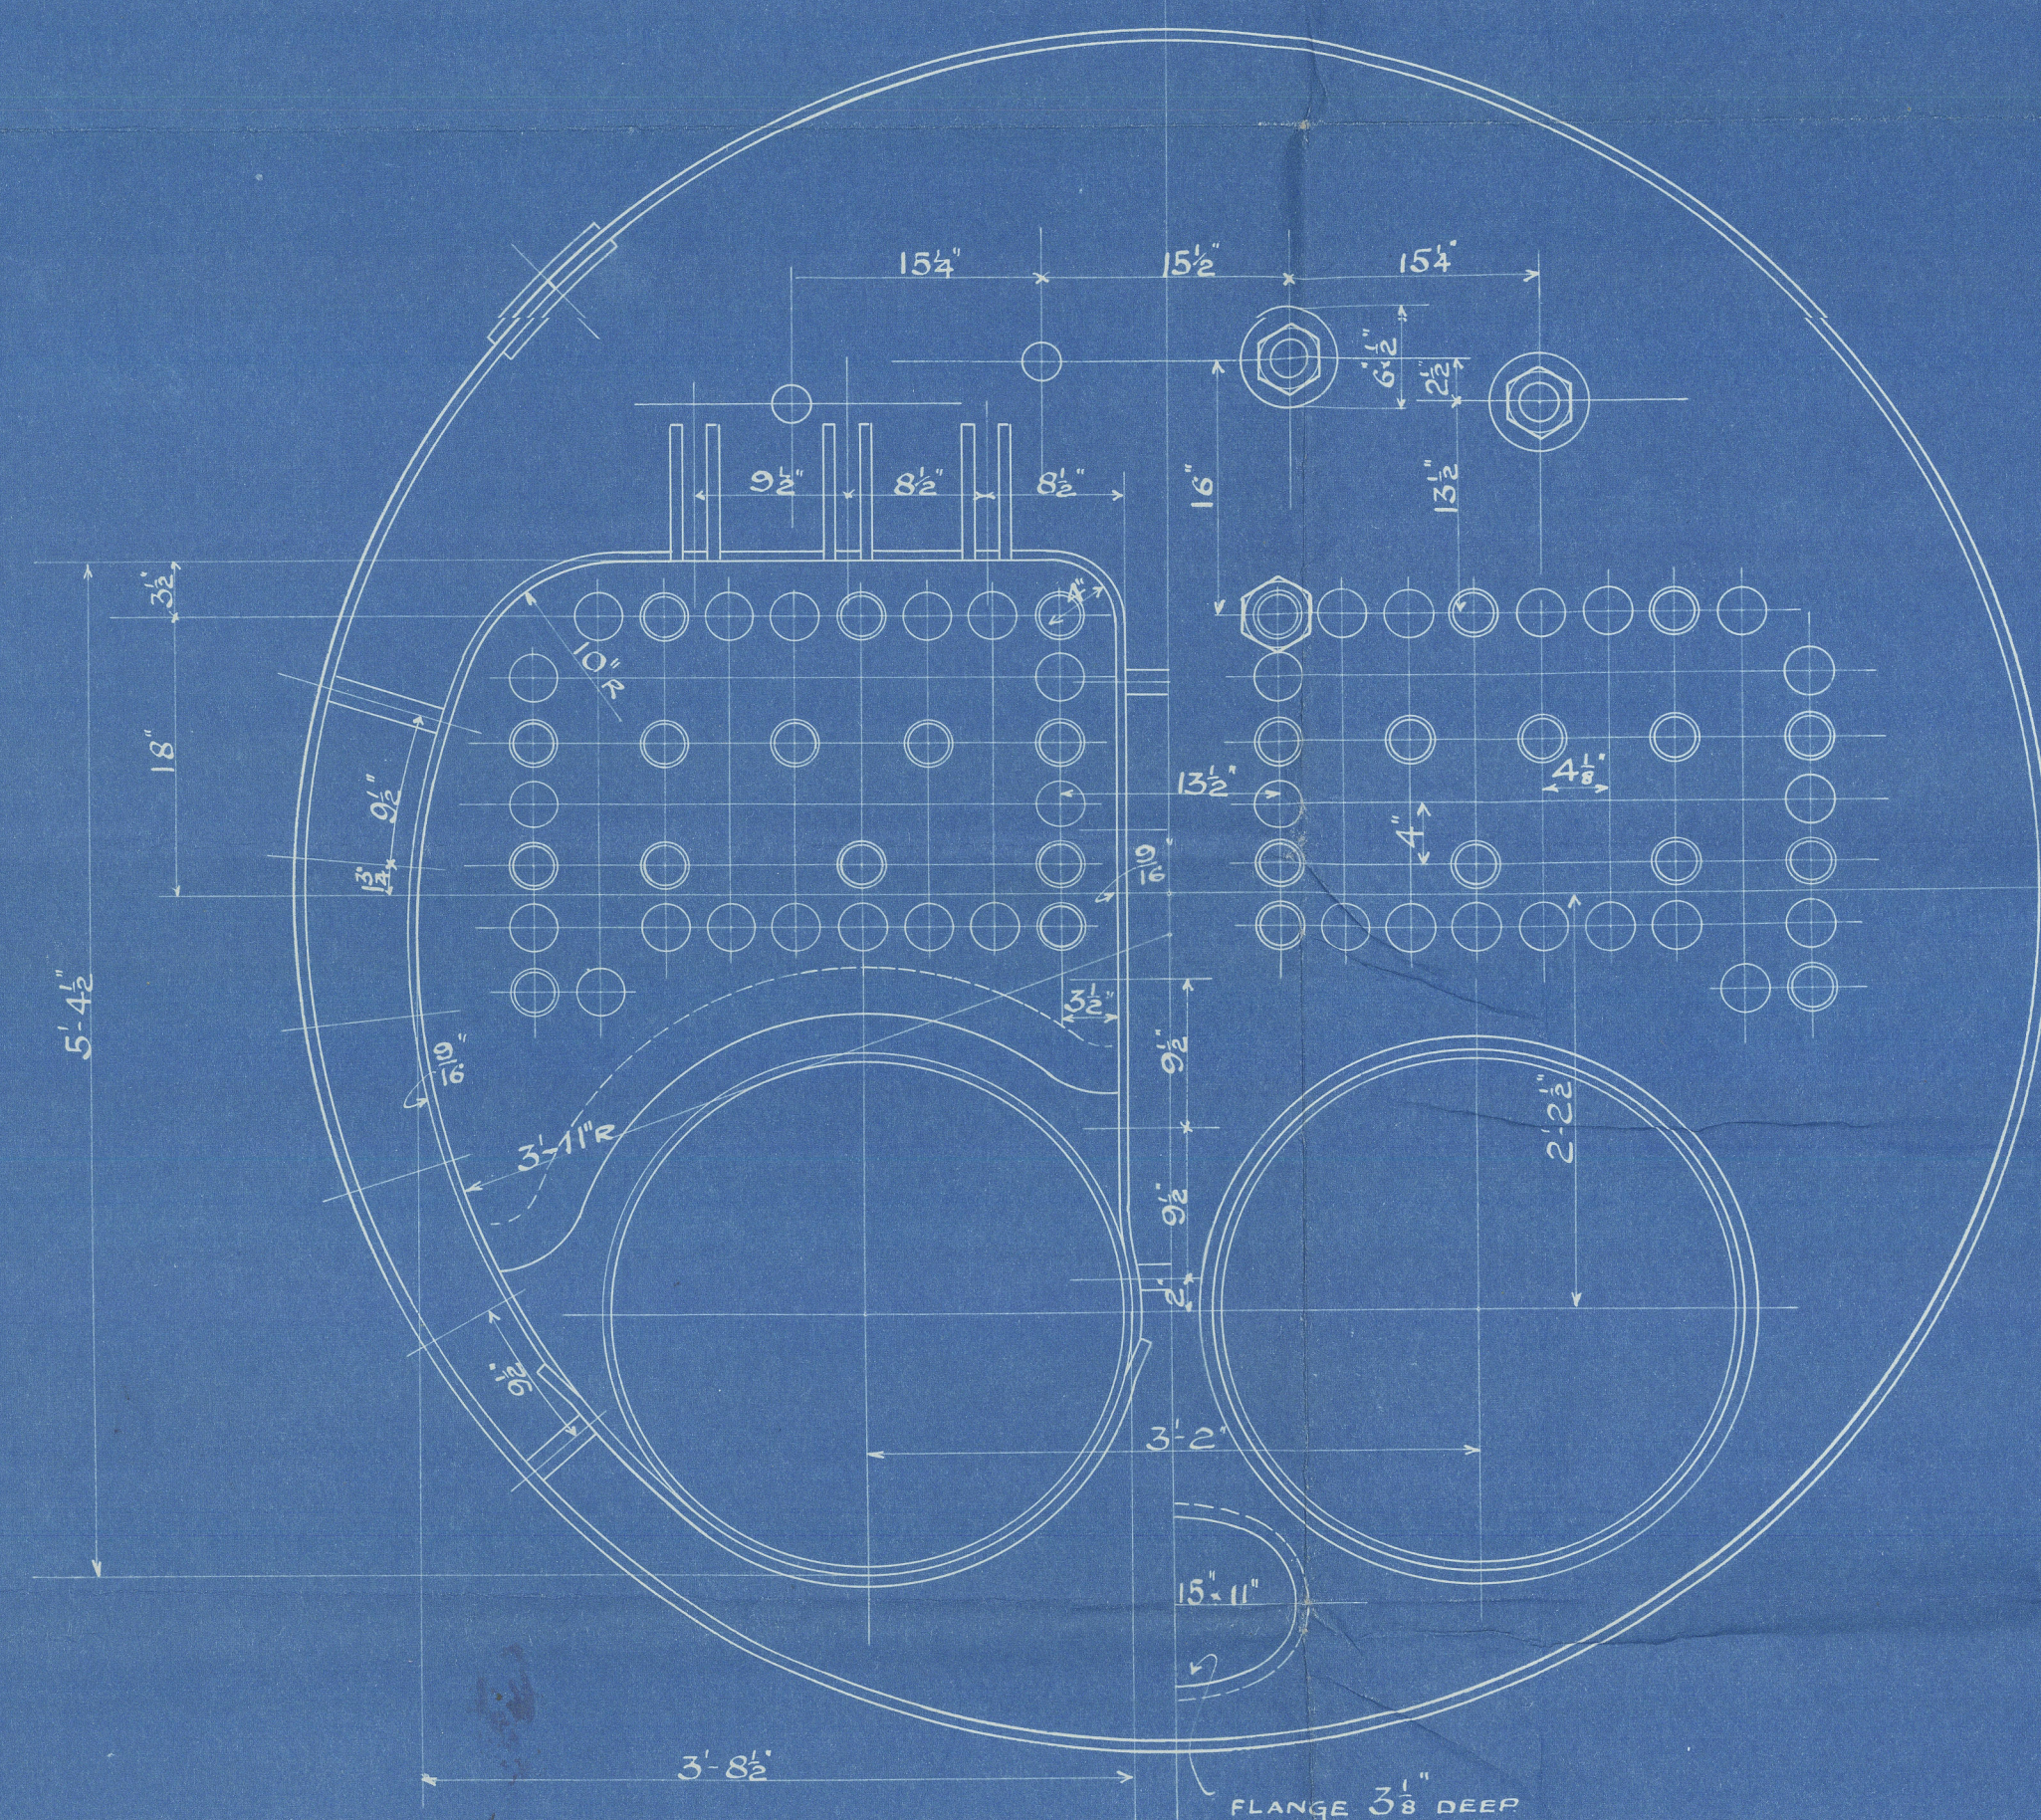

HEATING SURFACE 711 1/2 SFT.
GRATE AREA = 5.0' KNOWLES BARS = 26.4 SFT.

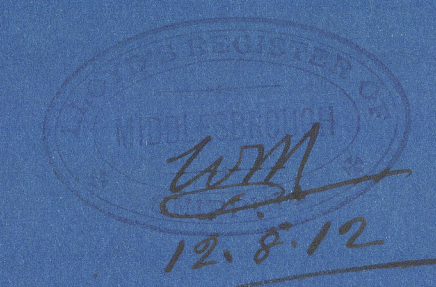

APR 14.8.12

Messrs Riley Bros

No. 4504

for

Messrs Vauxhall's West Hydraulic
Pump

Working Press 140 lbs



No. 5048
LLOYD'S TEST
280 lbs.
2.4.13 - WM

Indt Report-

No 7852.

1/2 Englishman.

Full 26413

RETAIN

R

© 2021

Lloyd's Register
Foundation

W1343-0165