


# M. S. NODA MARU.

## CONSTRUCTION PLAN.

SCALE  $\frac{1}{4}" = 1 \text{ FOOT}$ .

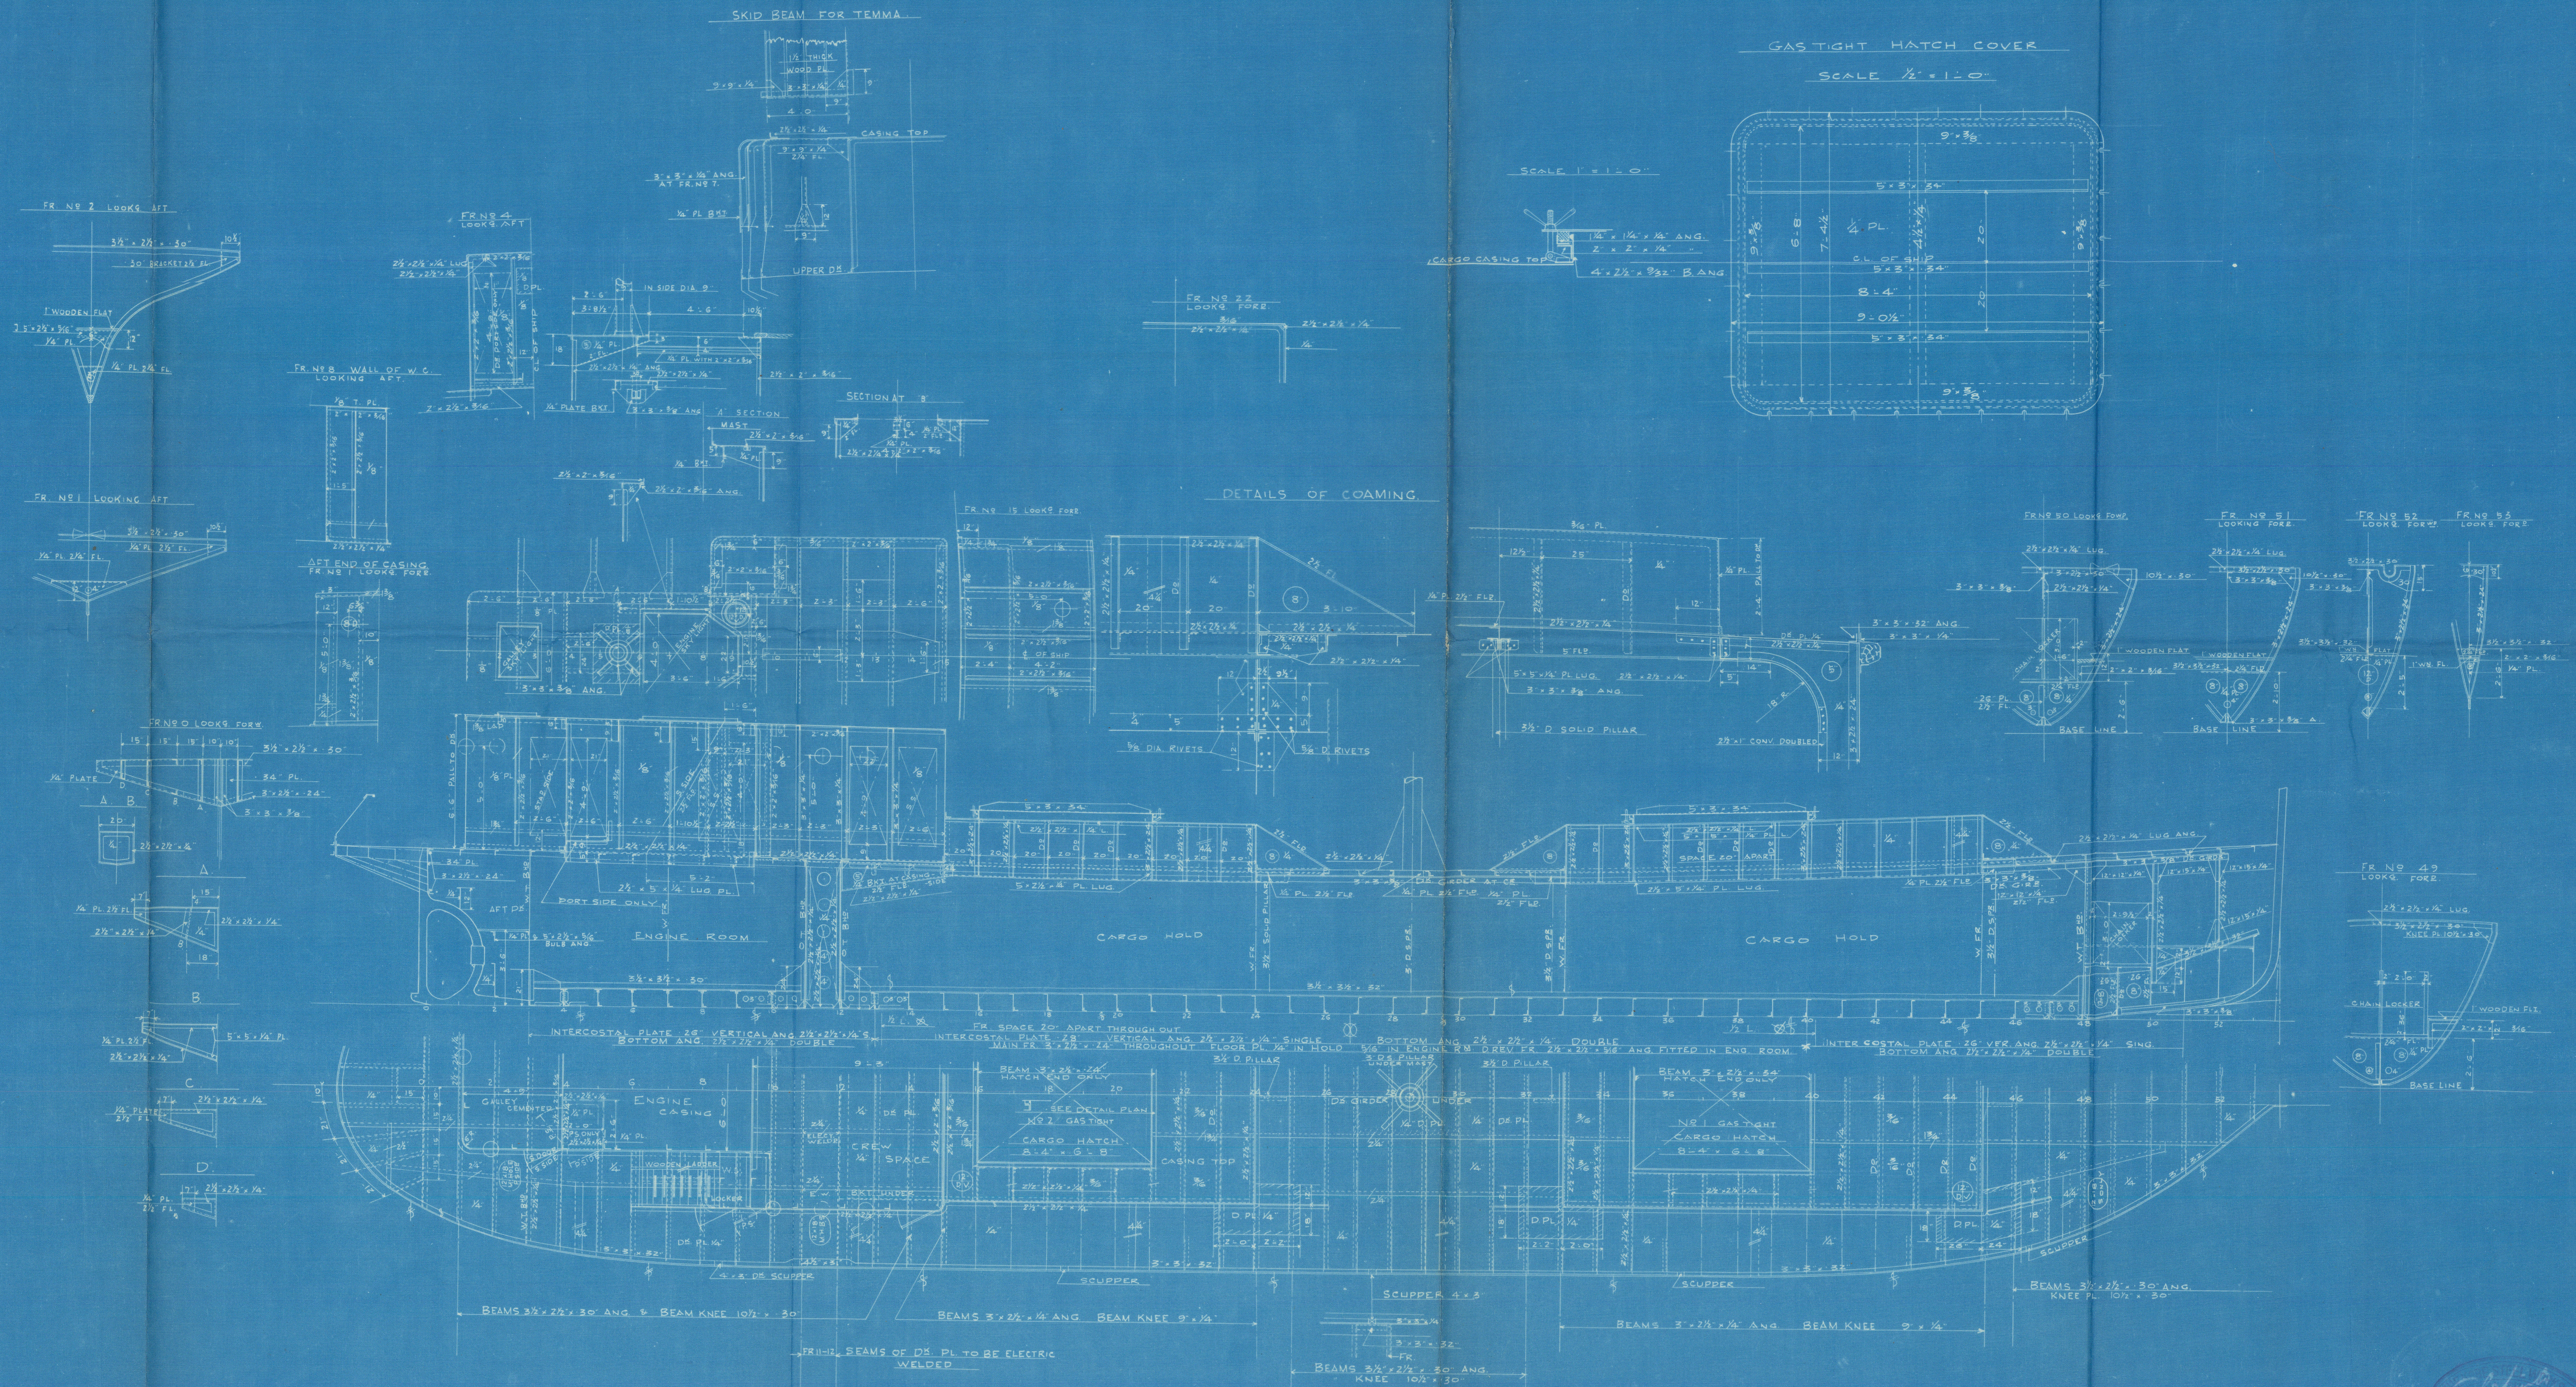

*Handwritten signature*



HARIMA YARD No. 122.


Ship's Name: M. S. "NODA MARU"

CONSTRUCTION PLAN.

(FINISHED PLAN)

No. 64078 *P/S*

THE KOBE STEEL WORKS, LTD., KOBE, JAPAN.

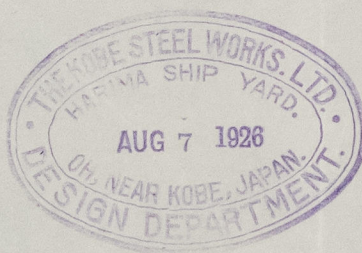

RETAIN

© 2021



Lloyd's Register  
Foundation

W11344-0192