

For the information of Surveyors and the Committee only.

22 DEC 1917

Received at Hull Office, 19

# Lloyd's Register of Shipping.

(Report on Vessel No. 30,519 Port Hull)  
J. J. William Bell

No. ✓ SHIP FORGINGS OR CASTINGS.

I have to report that the undermentioned Iron or Steel Forgings or Castings, manufactured by M<sup>essrs</sup> J. S. Forster & Sons L<sup>td</sup> of Sunderland for the Vessel No. 385, being built by Cook Weldon & Gemmill L<sup>td</sup> of Beverly, have been inspected by me as set forth below and found to be, so far as can be seen, Sound

on Forgings or Castings.


Lloyd's  
No. 692

D. W. Williamsow.

Sunderland, 20-12-17

	STERN FRAME.	RUDDER FRAME.	STEM.
Material*	<u>Scrap Iron</u>	<u>Scrap Iron</u>	
made	<u>Forged</u>	<u>Forged</u>	
Dimensions	<u>6" x 3"</u>	<u>4 1/2" dia 4 1/2" x 4" + 3 1/2" x 3"</u>	
Process on Inspection	<u>Forged &amp; Finished</u>	<u>Forged &amp; Finished</u>	
When Inspected	<u>12-9-17 to 19-10-17</u>	<u>4-12-17 to 18-12-17</u>	
CASTINGS.			
Tests on Standard Test Pieces.			
Tensile Test—			
Stress per square inch			
Elongation per cent.			
Bending Test—			
Angle before fracture			
Impact Test—			
Height from ground			
Welding Test—			
Made according to Rules and found satisfactory			

SKETCHES OF FRAMES SHOWING POSITION AND DESCRIPTION OF WELDS OF FORGINGS.

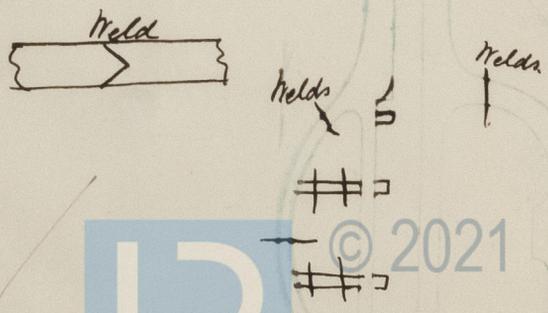

Fee (if any chargeable) £ ✓

To be paid at \_\_\_\_\_

If of Iron, state whether scrap or puddled Iron. If of steel, state whether made on the Open Hearth process.