

Nº 344

DIMENSIONS - 140'-0" BP x 24'-0" EX x 13'-10" MLD.

STEEL
STEAM TRAWLER

- LLOYDS NUMBERS

$$\begin{array}{rcl} L & = & 140' - 0'' \\ B+D & = & 37' - 70'' \\ d & = & 12' - 41'' \\ L \times (B+D) & = & 5278.00' \\ \frac{L}{d} & = & 10' - 12'' \end{array}$$

ANCHORS & CHAINS.

1 STOCKLESS ANCHOR 8 1/4 CWT. ✓


1	"	7 1/2	"	✓
1	RODGERS	3 1/4	"	✓ Ex STOCK. ✓

120 FATHOMS 1 1/2" STUD LINK CABLE.

60 " 6" HAWSER. ✓

60 " 5' WARP. ✓

4.5.15

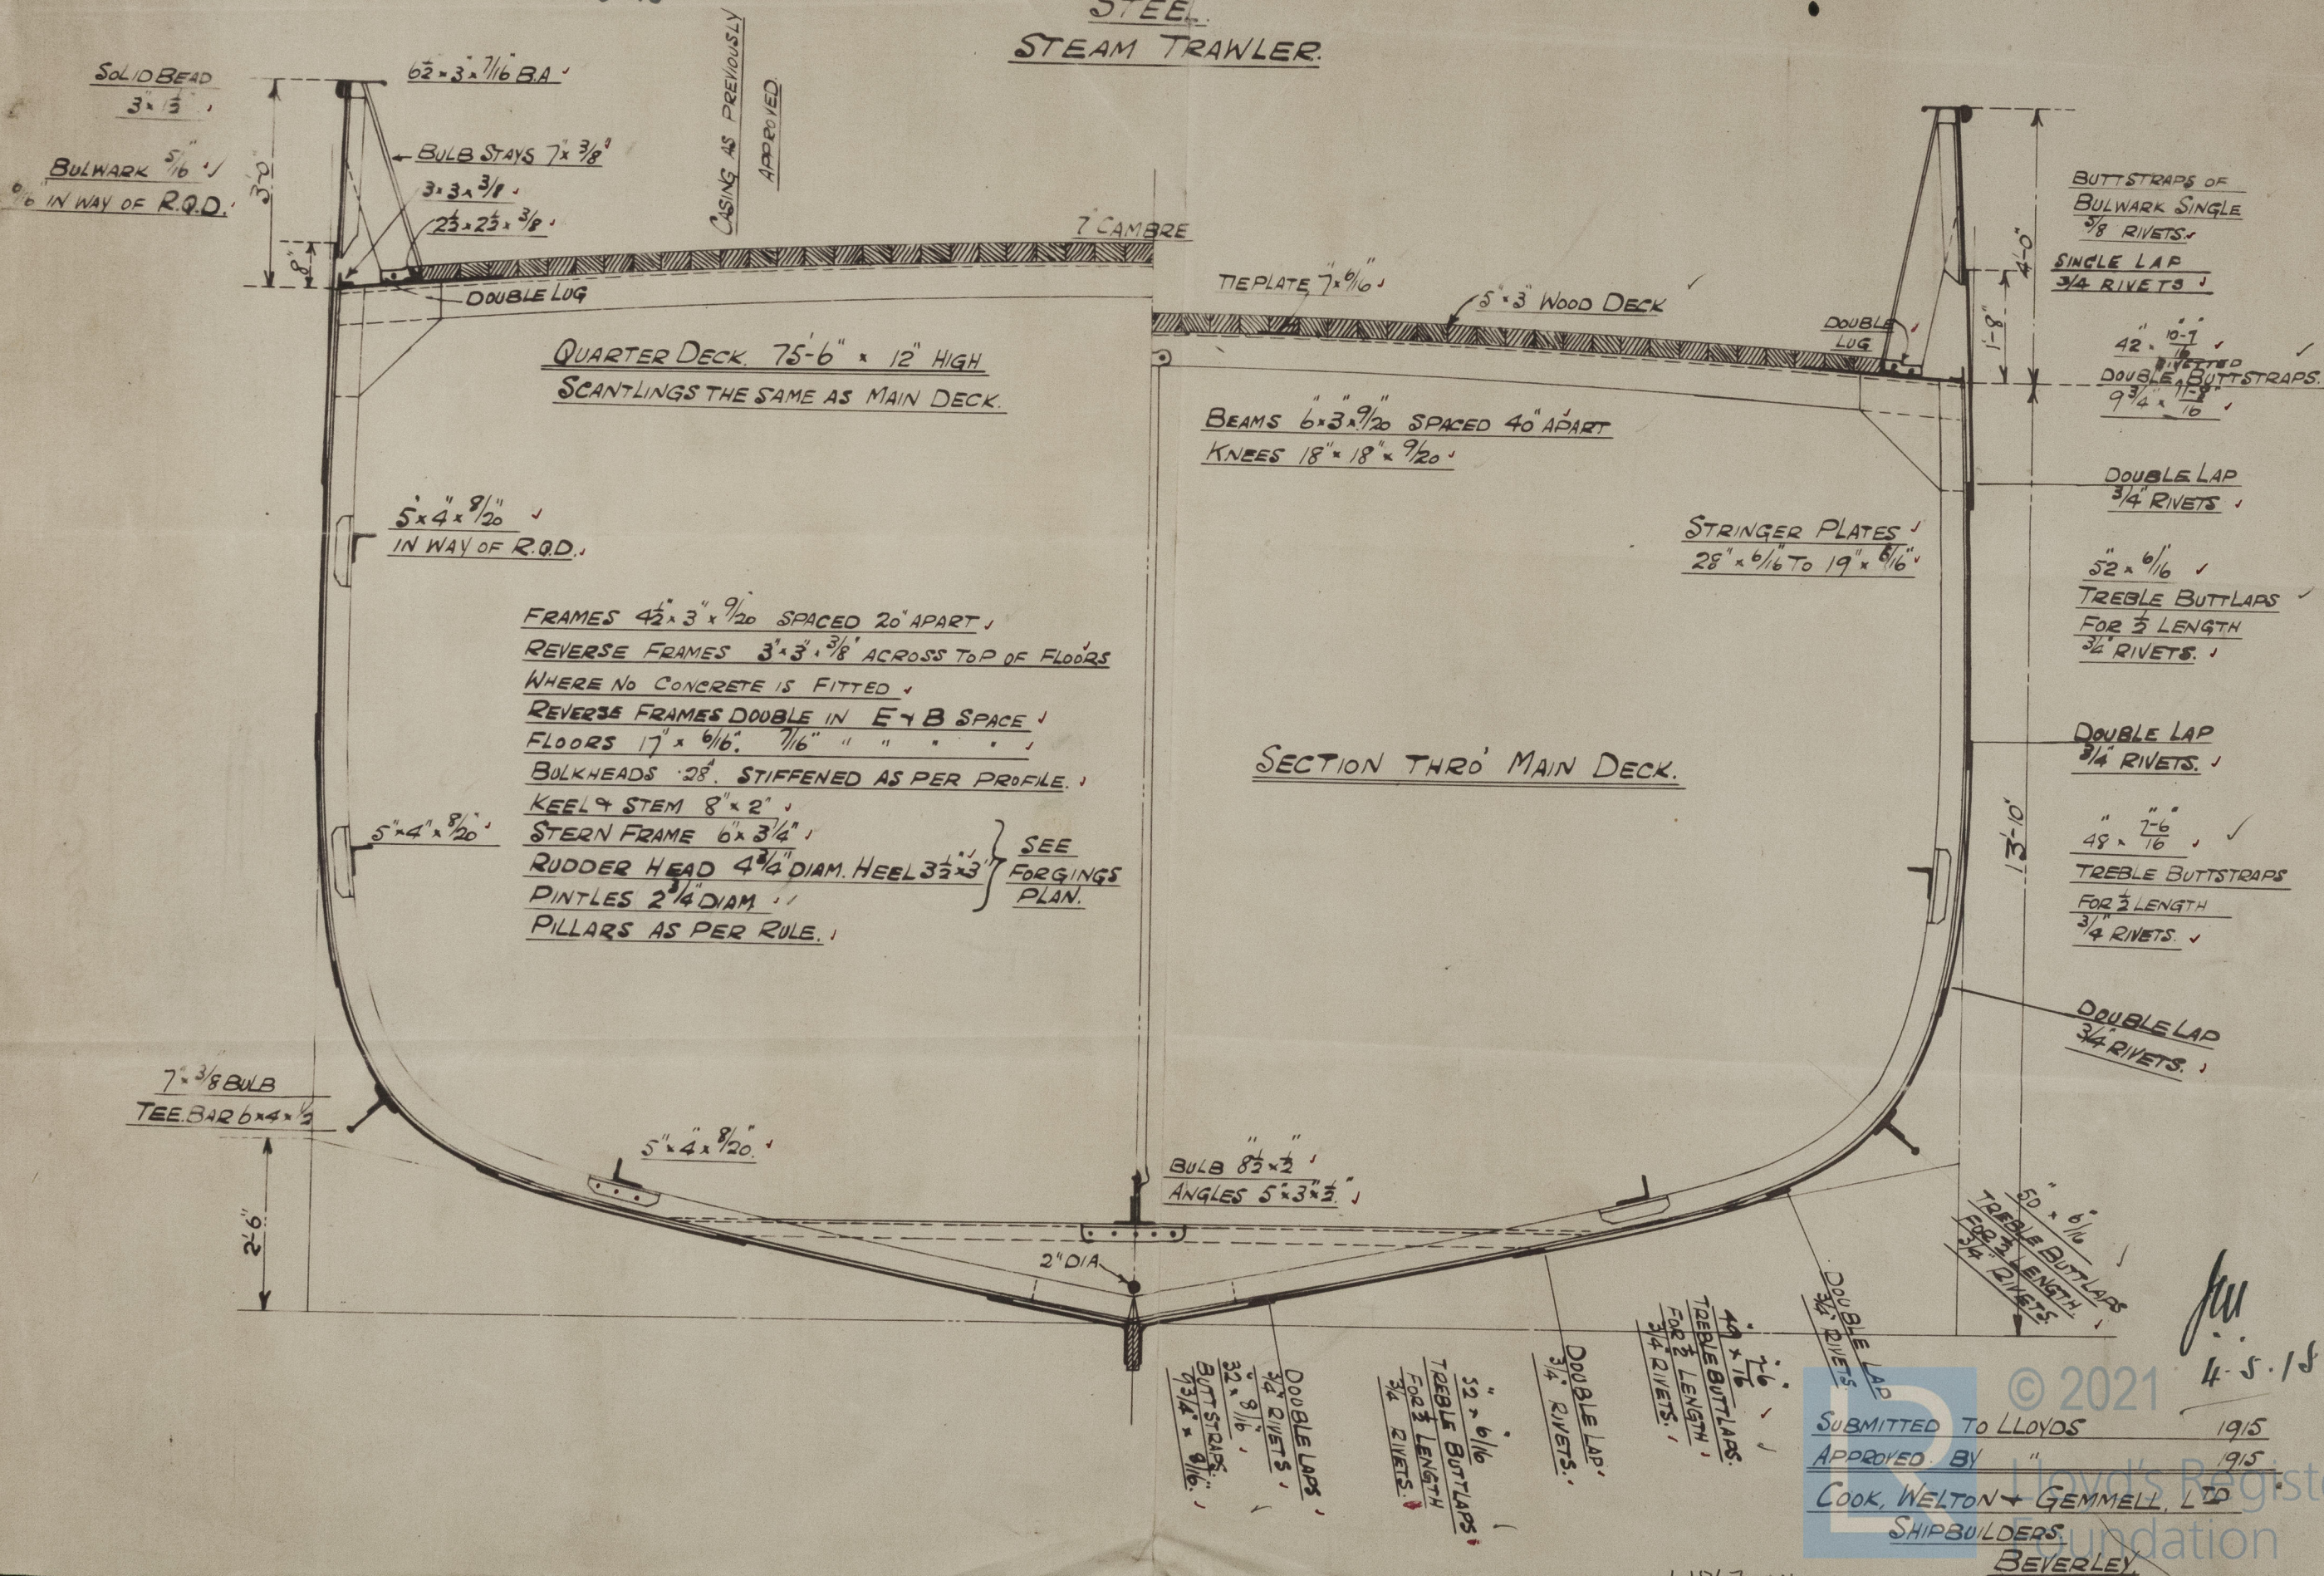


W1347-0011


Nº 344

MIDSHIP SECTION

COOK WELTON & GEMMELL

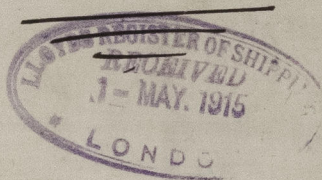

S.S. St. Hubert Hull 8720
no. 29553

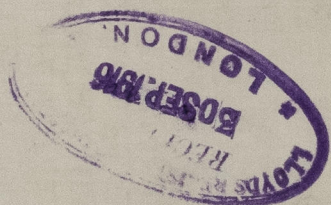

RETAIN

RETAIN



© 2021

Lloyd's Register
Foundation

W1347-0011