


STEEL BOILER 11'-0" DIA 10'-0" LONG 180 LBS W.P. LLOYDS

4231/41

2/12/10

RILEY BROS. (BOILERMAKERS) LTD.
STOCKTON ON TEES.

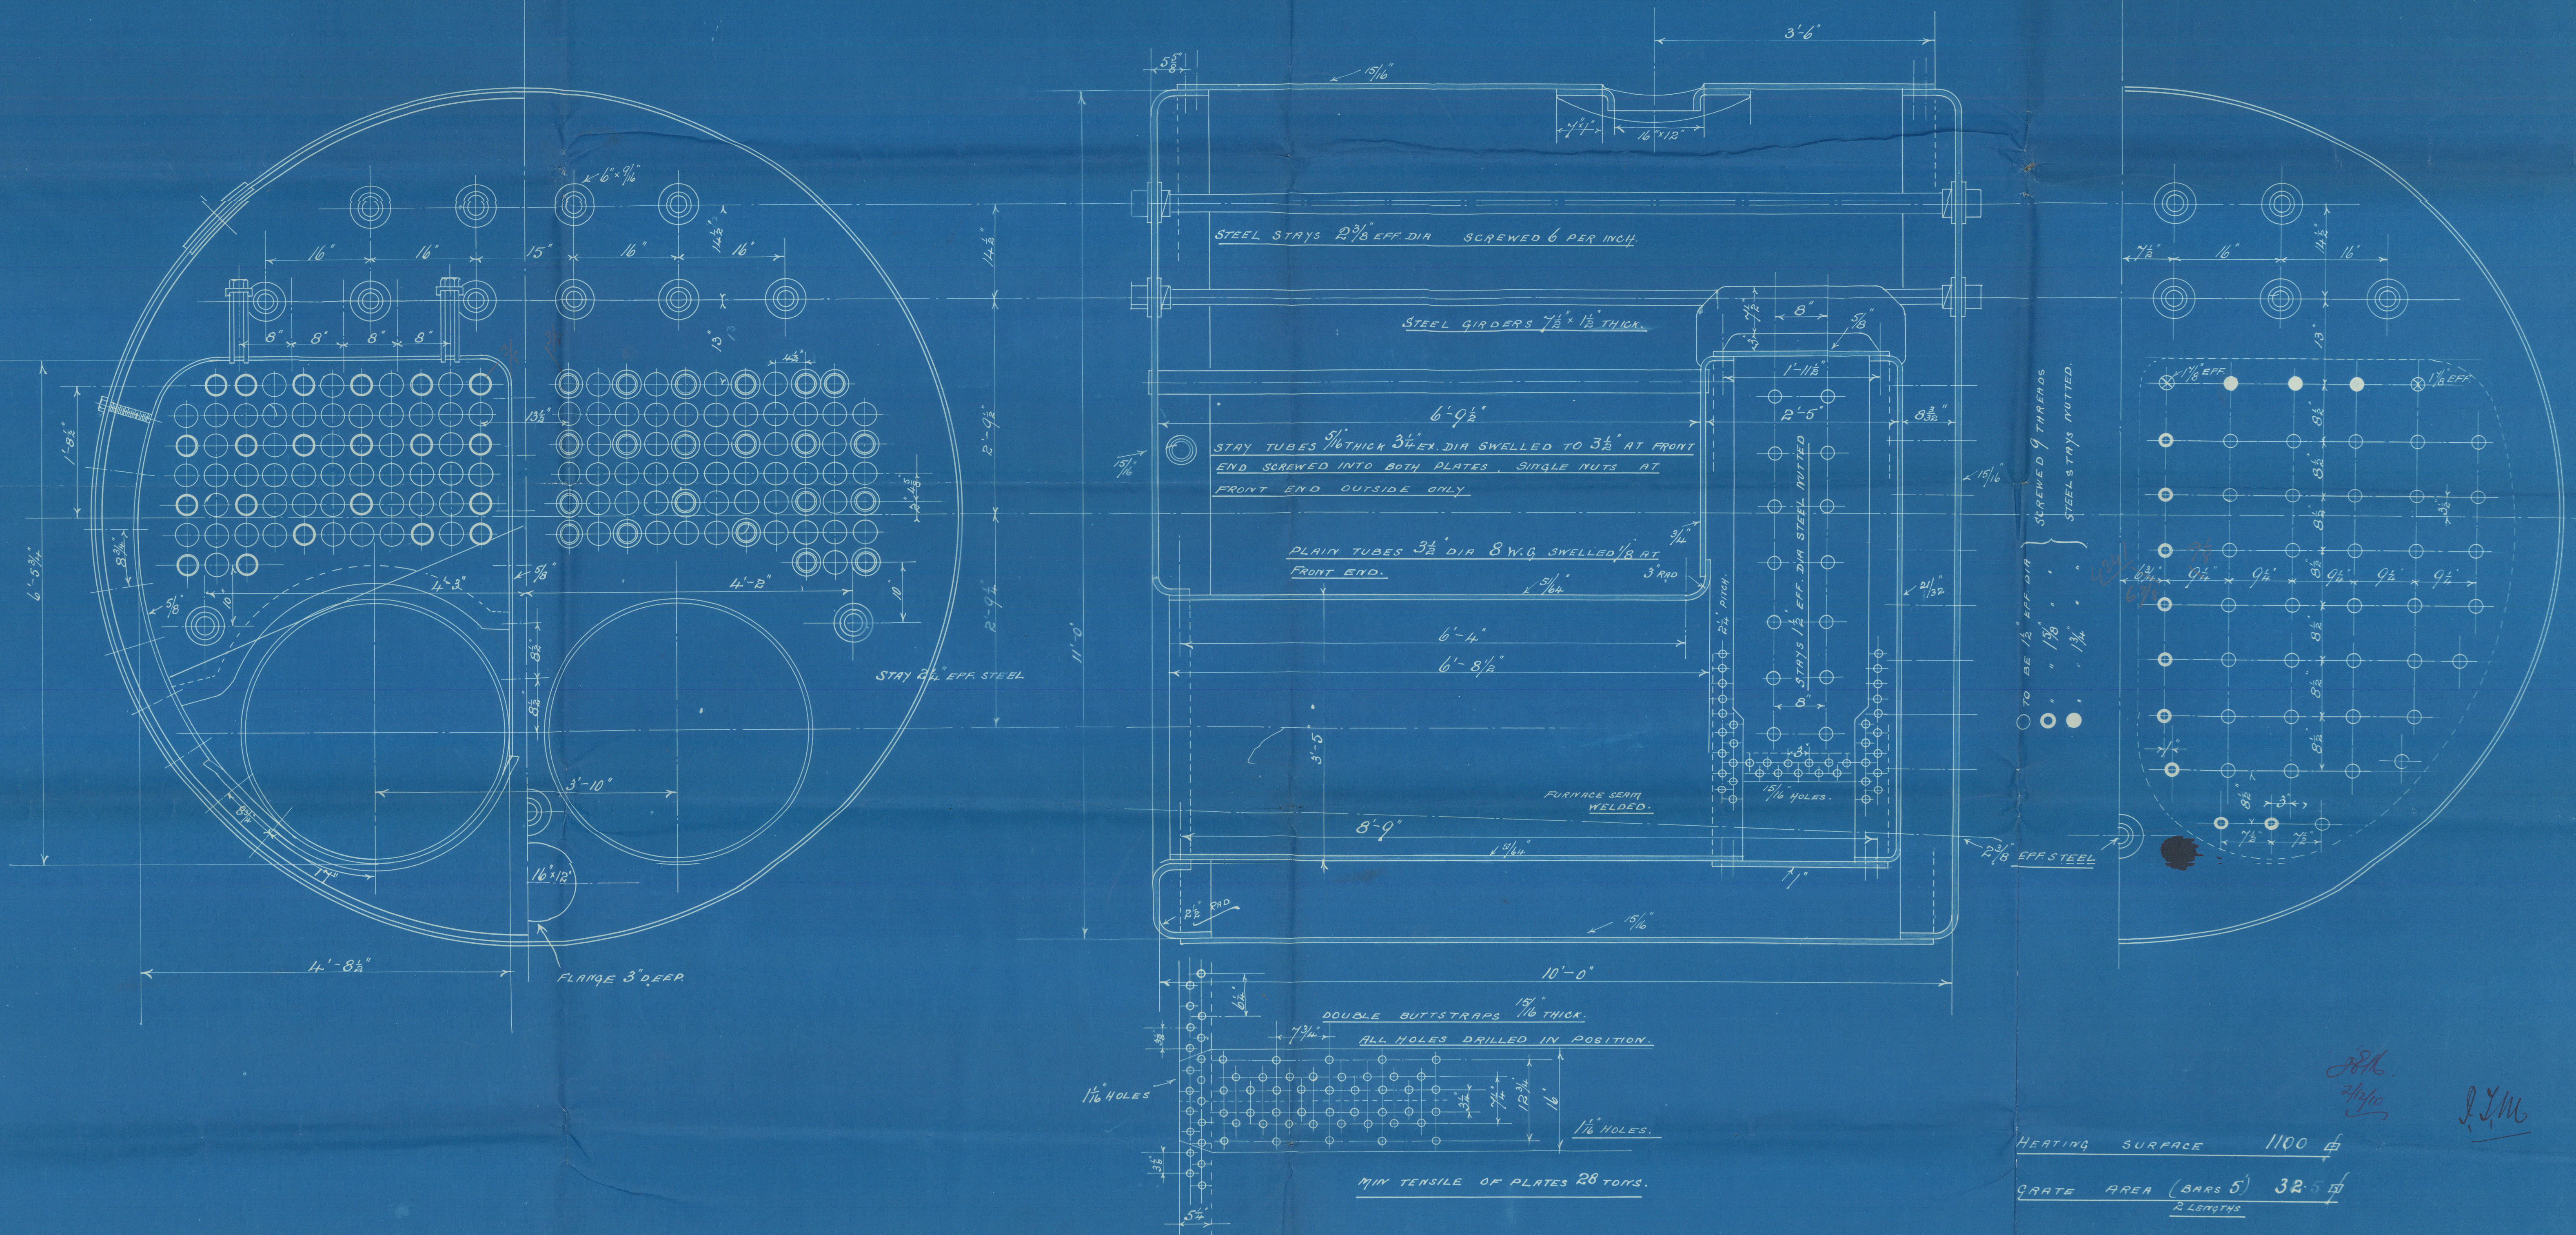

Hessan Riley Bros Lim.

Boilers 4231
4241

for

Thos John Priestman & Co

S.S. No 232


&

"Sir Raylton Dixon & Co Ltd

S.S. No 560

Respectively

Working Press 180 lbs.

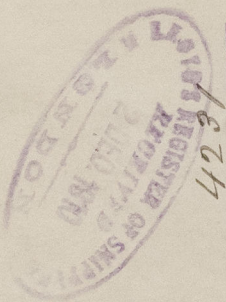

No.	4620
LLOYD'S TEST.	
	360 lbs.
	10.4.11
	W.M.

J. Priestman & Co

S.S. No 232

Heat Report
6913

4241

No.	4671
LLOYD'S TEST.	
	360 lbs.
	14.6.11
	W.M.

Heat Report 6868
"Rokkosaan Marie"



© 2021

Lloyd's Register
Foundation