


PATENT CANTILEVER TYPE.

✓
13-41

<u>EQUIPMENT.</u>					
b2.5 - .275					17108
POOP	b5.5 - .8	$\frac{3}{4}$ "			393
BRIDGE	15' - .8	$\frac{3}{4}$ "			90
Tide	31'	$\frac{7}{8}$ "	$\frac{3}{4}$ "		180
Houset	bo	.7	$\frac{1}{2}$ "		210
					<u>1801</u>
2	POWER ANCHORS	35#	Cups	EACH	Spacelless
1	"	30	"	"	"
1	TEAM	9 $\frac{1}{2}$ "	"	"	EX. Stock
1	KEDGE	4 $\frac{1}{2}$ "	"	"	"
140	PATHOMS	13 $\frac{1}{2}$ "	TRUD	CHAIN	CABLE
75		4"	Steel	WIDE	
90		3 $\frac{1}{2}$ "	"	"	"
2-90		7	HAWSEERS		HARPS
2-90		b	"	"	"

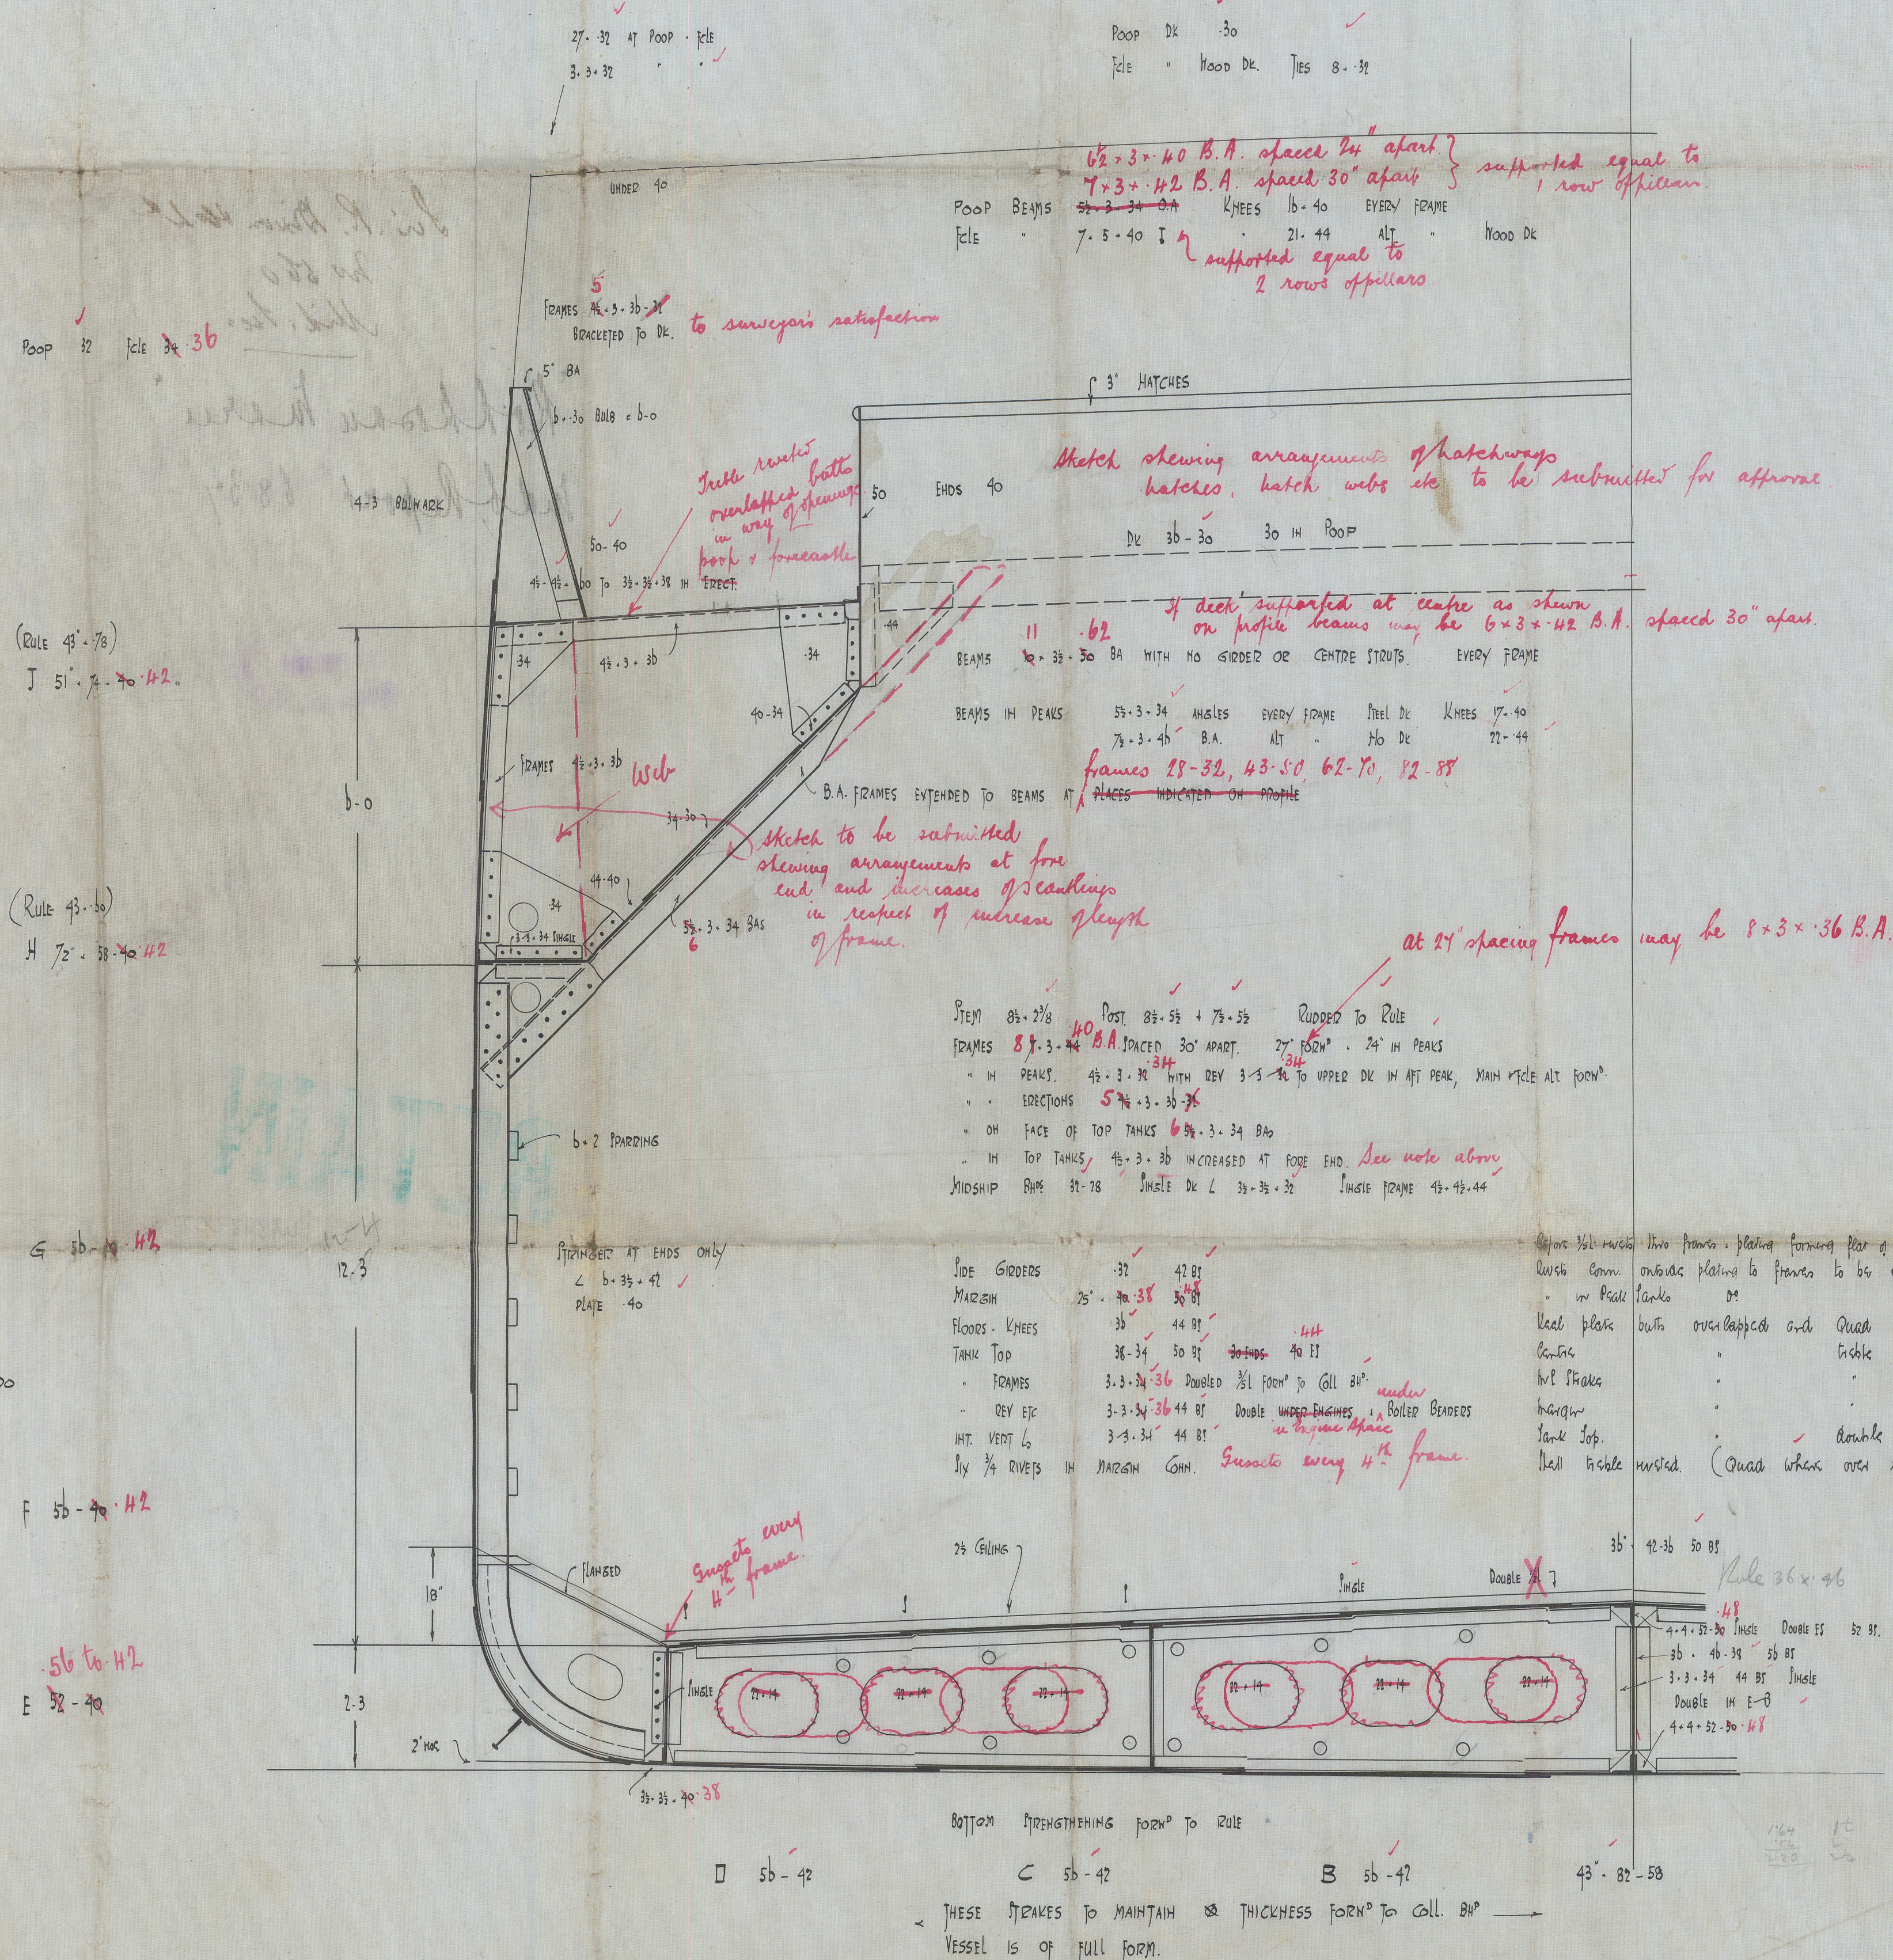

SIR RAYLTON DIXON & CO. LTD.
Nº 4584
18.7.10
CLEVELAND DOCKYARDS
MIDDLESBROUGH

Sir R. Dixon H^o L^d
No 560
Mil: Sec.

Rokkosaun Maru
Ind. Report 6837



© 2021

Lloyd's Register
Foundation

W1348-0072