


24.7.10  
17.11.10  
5-12.10  
24.2.11

Sketch of Midship Bulkheads

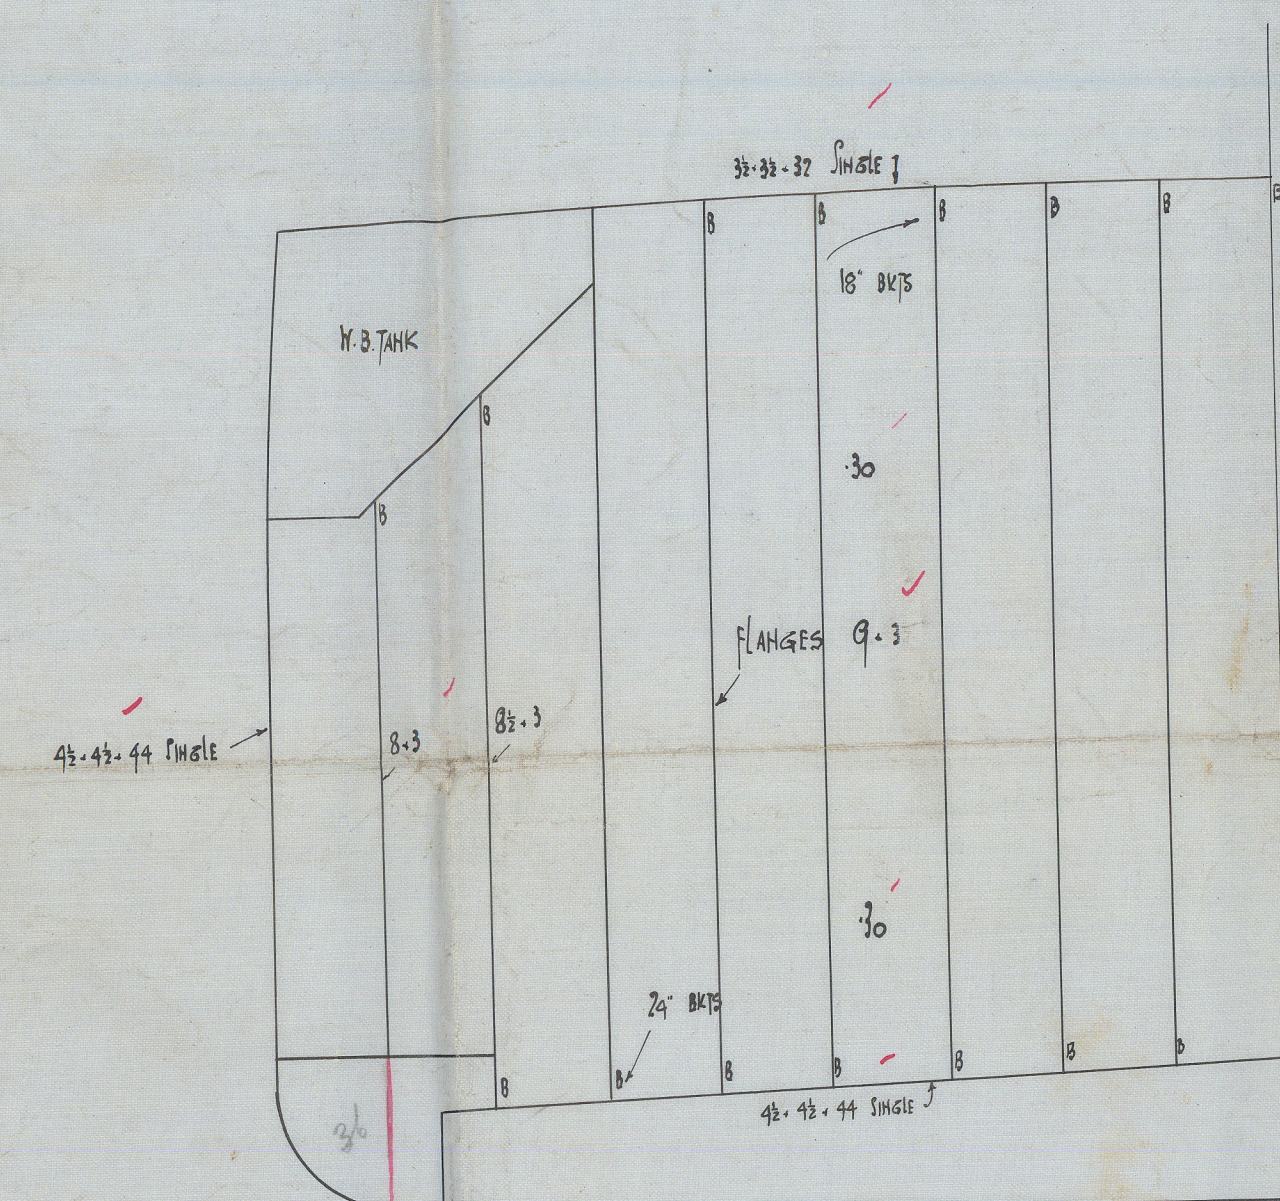


No 560 P.P.  
PROFILE + DECK PLANS  
275 - 42' 10" - 8-6  
To CLASS 100 A1 Lloyd's  
 $\frac{1}{8}" = 1 \text{ ft.}$   
PATENT CANTILEVER TYPE

11.11.10  
17.11.10  
5-12.10  
24.2.11



C.F.  
22/7/10

24.7.10

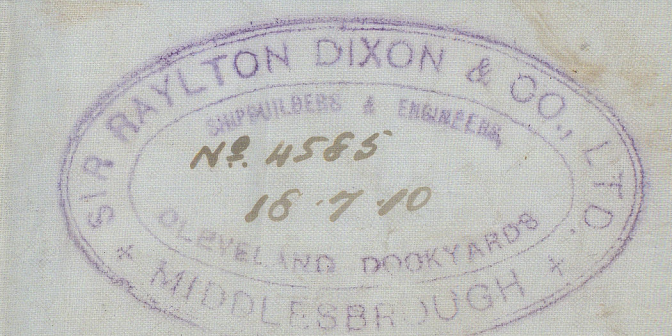



Sir. R. Dixon & Co  
No 560

Profile & Docks

"Kokkosa Maru"  
M.B. Report 6837



© 2021

Lloyd's Register  
Foundation

W1348-0073