

-4-

Lloyd's Register of Shipping,

3, Wilhadistrasse,

Bremen, 17th November, 1938.




Reference

Dear Sir,

Having reference to a discussion with Dr. Montgomerie and Mr. Johnson on Tuesday, the 8th instant, at Bremen, regarding test samples of shell and deck plate of the s.s. "ANNELIESE ESSBERGER", as requested to be sent to London, I beg to inform you that the samples have been prepared (standard test piece A) by Messrs. Deutsche Schiff-und Maschinenbau A.G., Werk Act. Ges. "Weser", Bremen, and will be forwarded to London direct by the Yard to-day or to-morrow.

The test samples have been marked as follows:-

	Deck Stringer	Shell Sheer Strake
Longitudinal Samples	Nos.2,4,6 & 8	Nos.10,12,14 & 16
Transverse Samples	" 1,3,5 & 7	" 9,11,13 & 15
Samples for Analysis :- A, B, C & D.		

The figures have been centre punched, thus  and further all samples are stamped:- A.H.


The samples having a crack edge (Nos.2,4,6,8, A,B,C & D), this crack edge has been marked by centre

-2-

Samples "Anneliese Essberger".


-2-

punched line

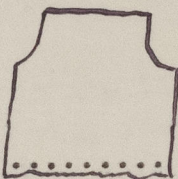


Position of the test pieces are shown by the following diagrams:-

Shell:

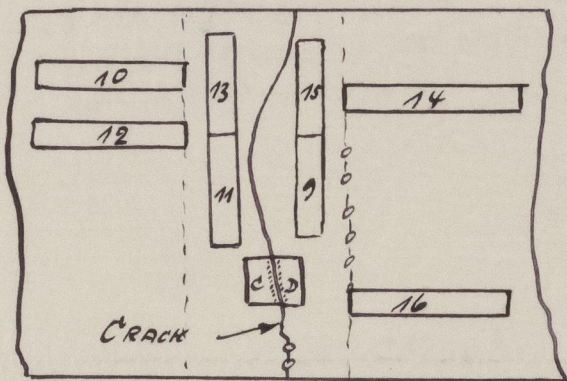

Deck:

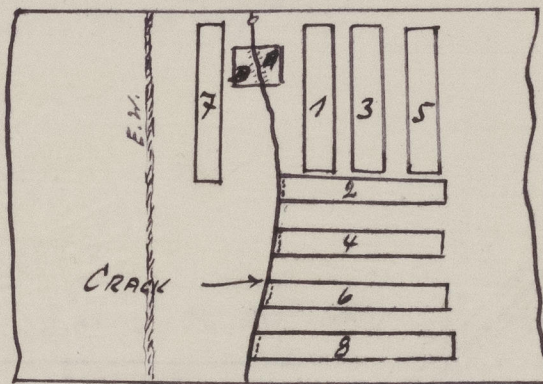

I am, Dear Sir,

Yours faithfully,

A. Holte.

The Secretary,

LONDON.

© 2021

Lloyd's Register
Foundation

W1341-0232 P2

M1344-053582

Referred to the Chief Ship Surveyor.

19 NOV 1938

Jay

H.B.



LONDON.

The Secretary,




I am, Dear Sir,

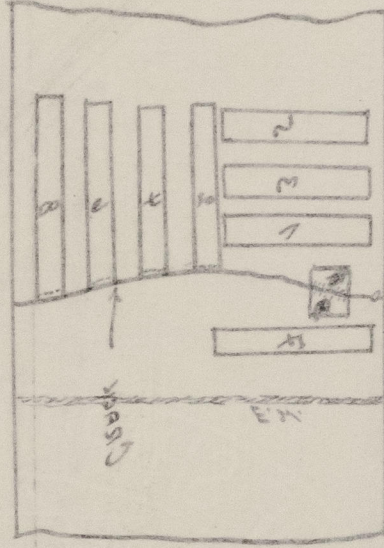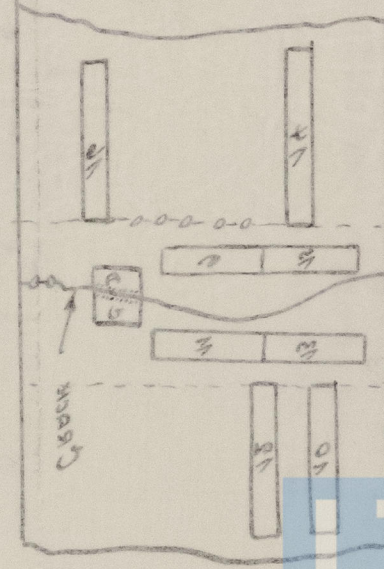

Following diagram:-


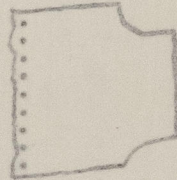


-3-


© 2021

Lloyd's Register
Foundation