


S.S. "CANADIAN RANCHER"

MIDSHIP SECTION

SCALE: 1/2" = 1 FOOT

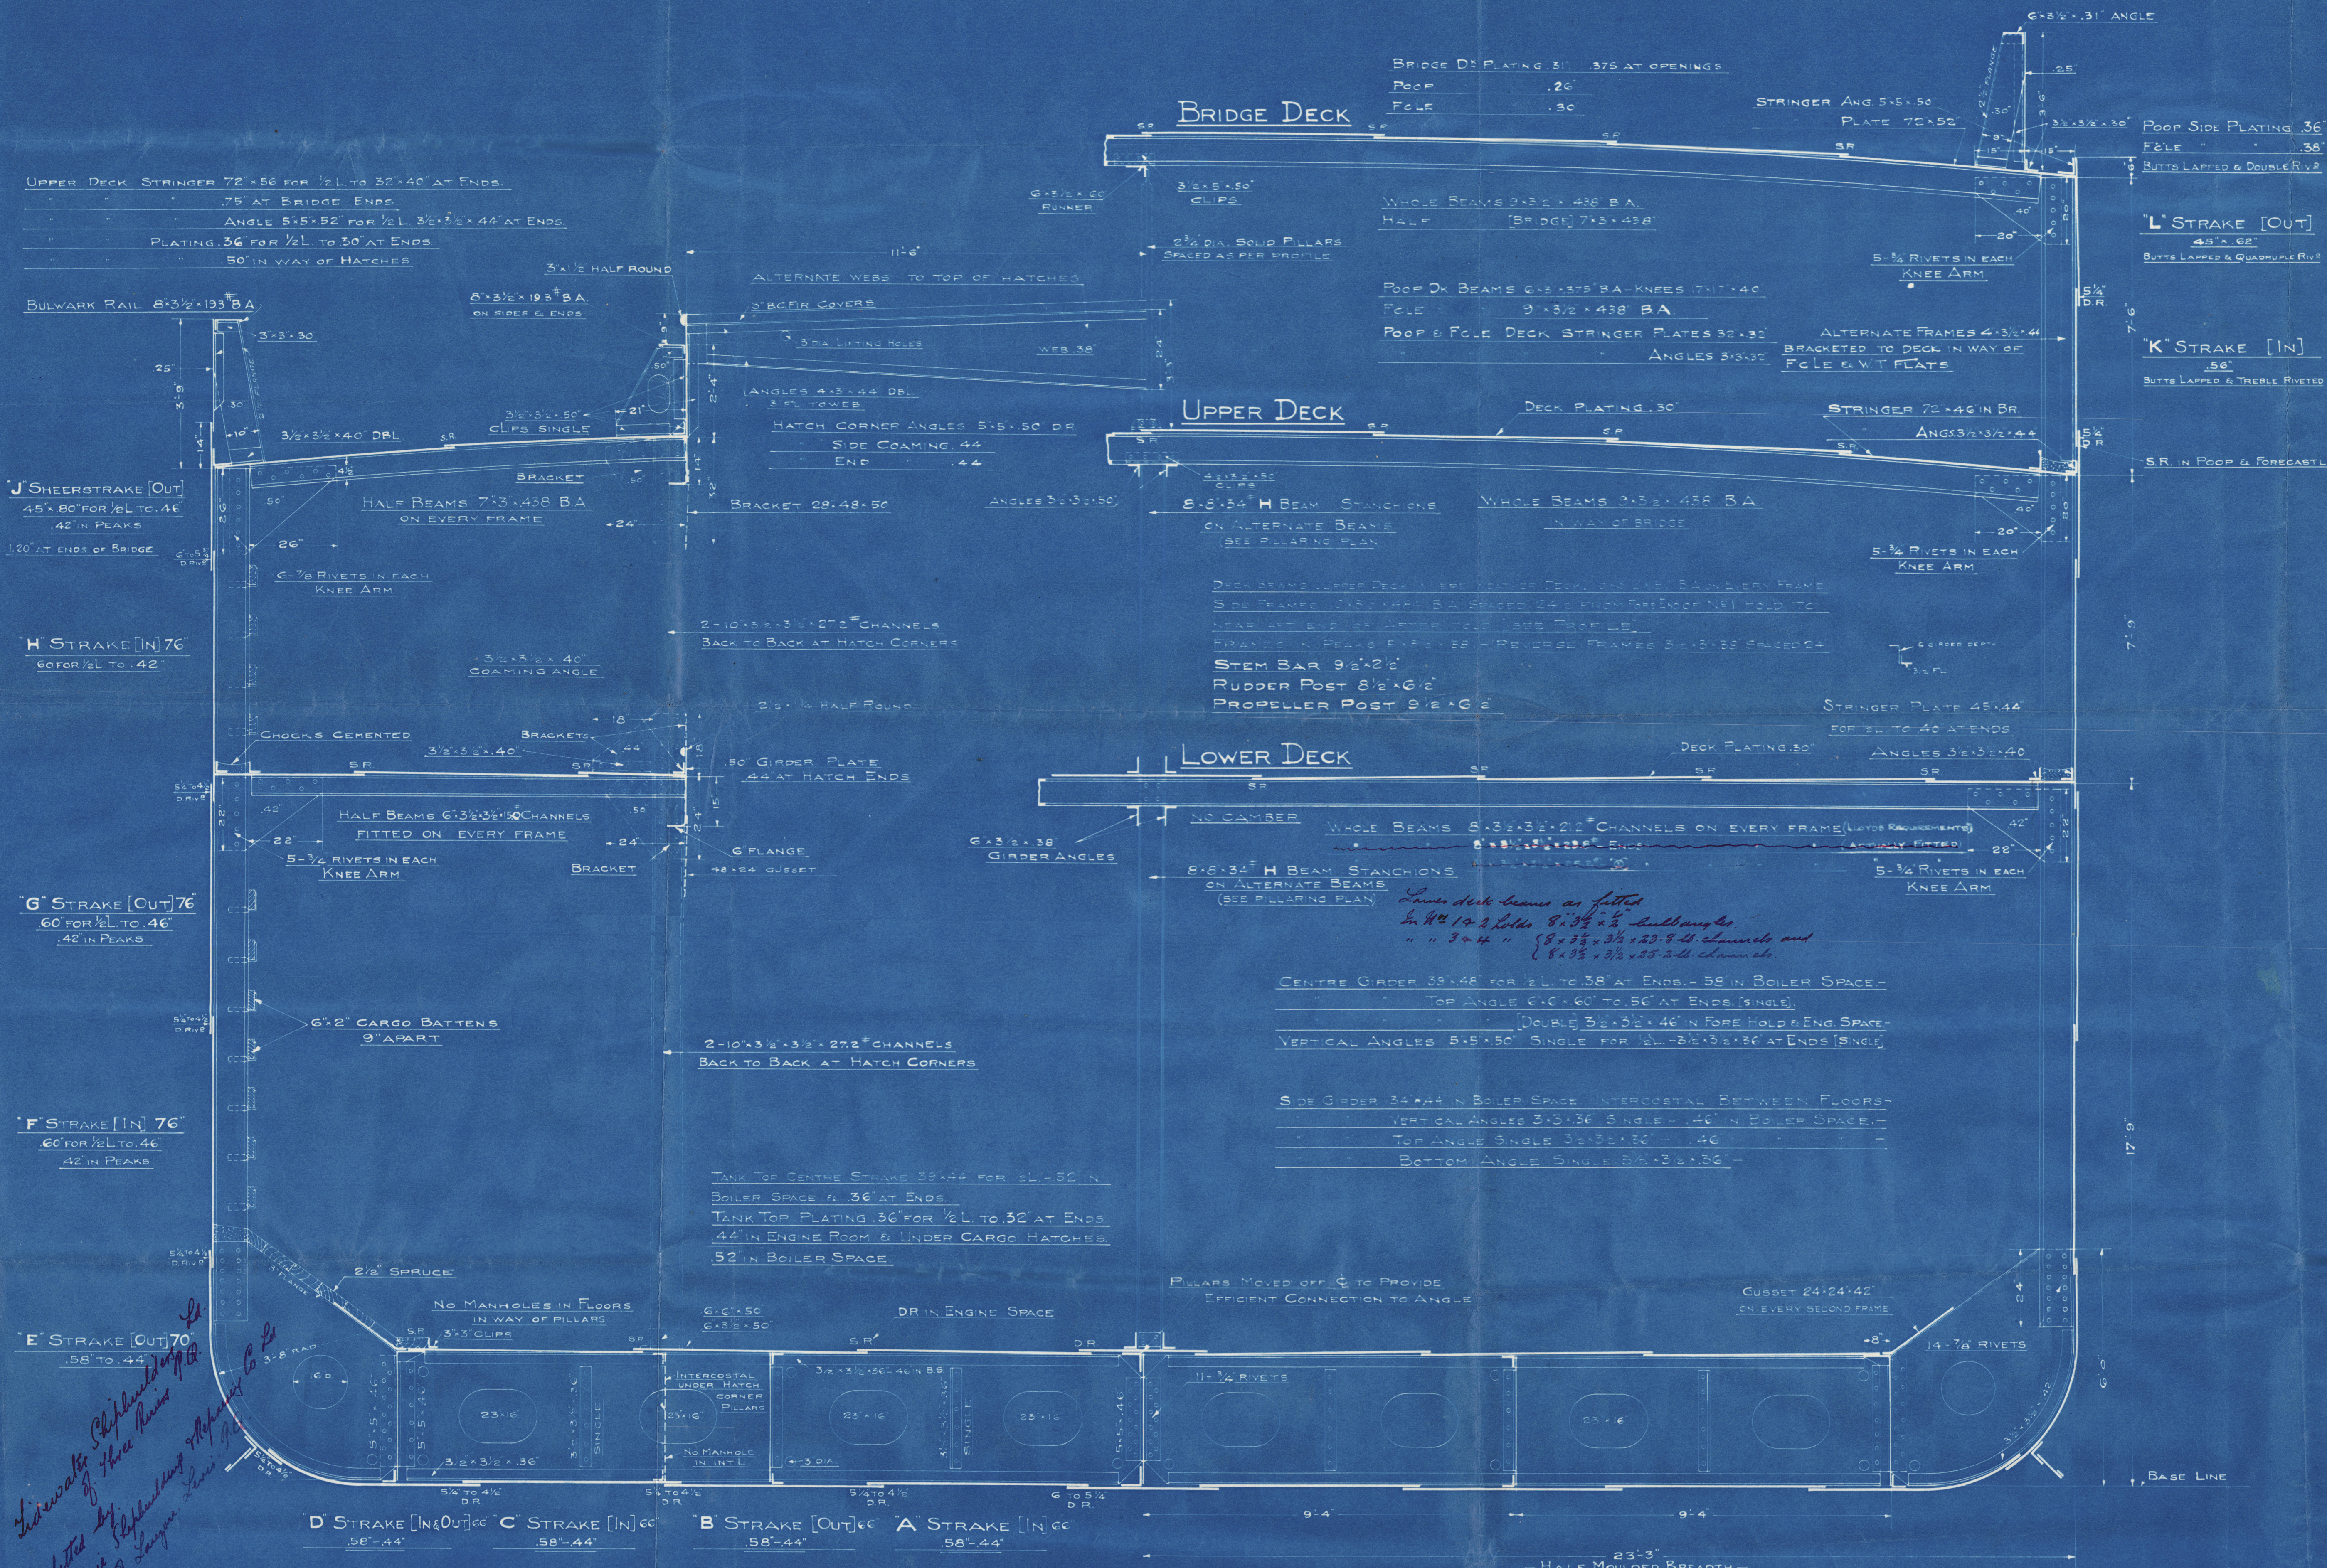

—RIVETING—

KEEL BUTTS LAPPED & QUADRUPLE RIVETED.—
CENTRE GIRDER BUTTS LAPPED & TREBLE RIVETED.—
SHELL PLATING **A** TO **E** STRAKES (INCL) BUTTS LAPPED & TREBLE RIVETED.—
SHELL PLATING **F** TO **H** STRAKES (INCL) BUTTS LAPPED & QUADRUPLE RIVETED FOR 3/4 L. TREBLE RIVETED AT ENDS.—
UPPER DECK SHEERSTRAKE **J** BUTTS LAPPED & QUADRUPLE RIVETED FOR 1/2 L. TREBLE RIVETED AT ENDS. QUINTUPLE RIVETED AT BRIDGE ENDS.—
TANK TOP CENTRE STRAKE BUTTS LAPPED & TREBLE RIVETED FOR 1/2 L. DOUBLE RIVETED AT ENDS.—
TANK TOP PLATING BUTTS LAPPED & DOUBLE RIVETED. TREBLE RIVETED IN PLATING OVER .48" IN THICKNESS.—
TANK MARGIN BUTTS LAPPED & DOUBLE RIVETED. TREBLE RIVETED IN BOILER SPACE.—
UPPER DECK STRINGER BUTTS LAPPED & TREBLE RIVETED. QUADRUPLE RIVETED AT BRIDGE ENDS.—
UPPER DECK PLATING BUTTS LAPPED & DOUBLE RIVETED. TREBLE RIVETED IN PLATING OVER .48" IN THICKNESS.—
BRIDGE DECK STRINGER BUTTS LAPPED & TREBLE RIVETED.—
BRIDGE DECK PLATING BUTTS LAPPED & DOUBLE RIVETED.—
POOP & FORECASTLE DECK STRINGER BUTTS LAPPED & DOUBLE RIVETED. PLATING, SINGLE RIVETED.—

—EQUIPMENT [LETTER V]—

2 BOWER ANCHORS STOCKLESS EACH 48 1/2 CWTs. COLL. WEIGHT 139 CWTs.—
1 BOWER ANCHOR STOCKLESS 41 1/2 CWTs.—
1 STREAM ANCHOR EX. STOCK 13 CWTs.—
1 KEDGE ANCHOR EX. STOCK 5 1/2 CWTs.—
270 FATHOMS 2" STUD LINK CHAIN—
90 " 4 1/2" STEEL WIRE IN LIEU OF STREAM CHAIN.—
120 " 4" " " TOWLINE.—
2 90 FATHOMS EACH 7" MANILLA HAWSEERS.—
2 30 " 7" " " WARPS.—

—NUMERALS—

TRANSVERSE NUMBER 46.5 + 25.5 = 72
LONGITUDINAL " 331 x [46.5 + 25.5] = 23832
DEPTH "d" 25.5 - 3.25 = 22.25
EQUIPMENT NUMBER = 25115

—PROPORTIONS—

L/D UPPER DECK 331/25.5 = 12.98
L/D BRIDGE " 331/35 = 10.03

—DIMENSIONS—

LENGTH B.P. 331'-0"
BREADTH MOULDED 46'-6"
DEPTH MOULDED UPPER DECK 25'-6"
" " BRIDGE " 33'-0"
NO TUMBLE HOME NO RISE OF FLOOR
CAMBER 11 1/8" IN 46 FEET 6 INCHES

To CLASS 100-A-1 AT LLOYDS

HULL No 6

W35-0160

"Widestone"

ex

S.S. "Canadian Rancher"

built by

Lidewater Shipbuilders Ltd.
Three Rivers, P.Q.

(Hull Deck fitted by Davis B.R. Co Ltd)
Langen Lewis P.Q.


MIDSHIP SECTION.

OF VESSEL AS COMPLETED

For attachment to Dec. 75. Rpt.

Dec. 1980.

W135-0160

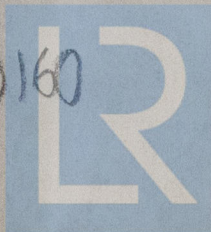

© 2020

Lloyd's Register
Foundation