





LOYD'S REGISTER
KOBLENZ
C. 24

№ 922 S.S. SURABAYA MARU.
STRUCTURAL ARRANGEMENT
SCALE 1/8 IN TO ONE FT.
DECK PLAN


BRIDGE DECK PLAN

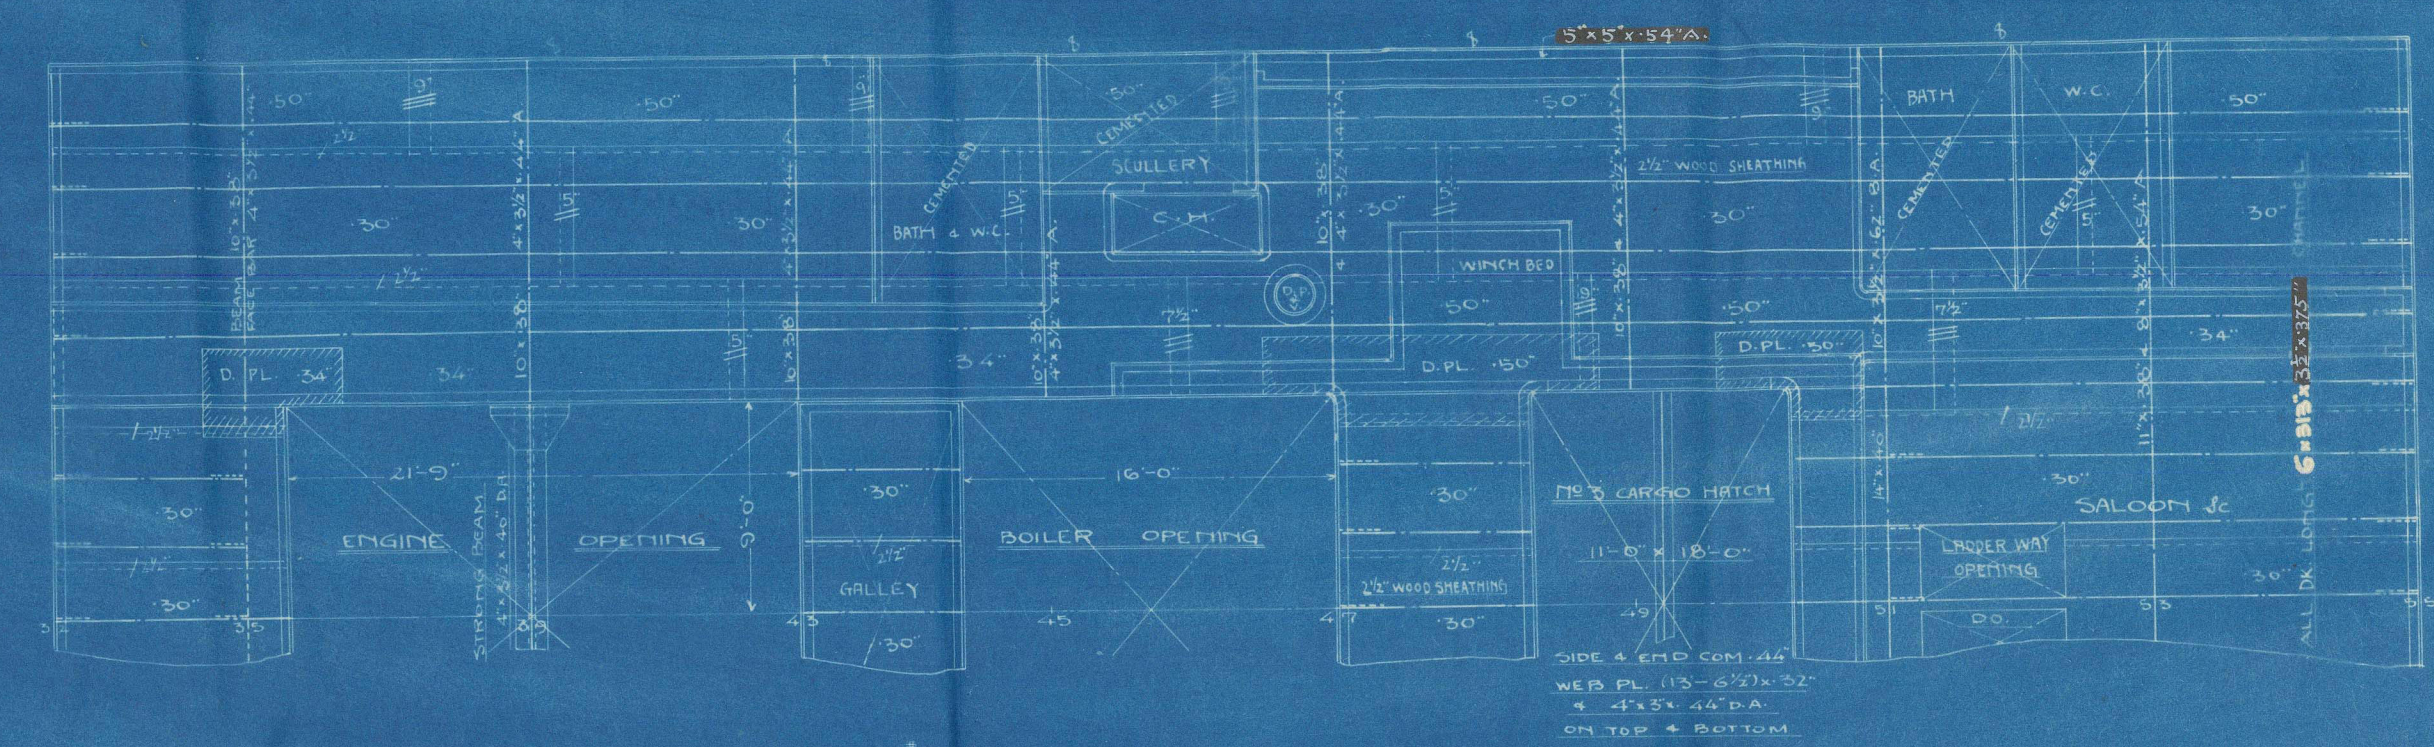


FORECASTLE DECK PLAN

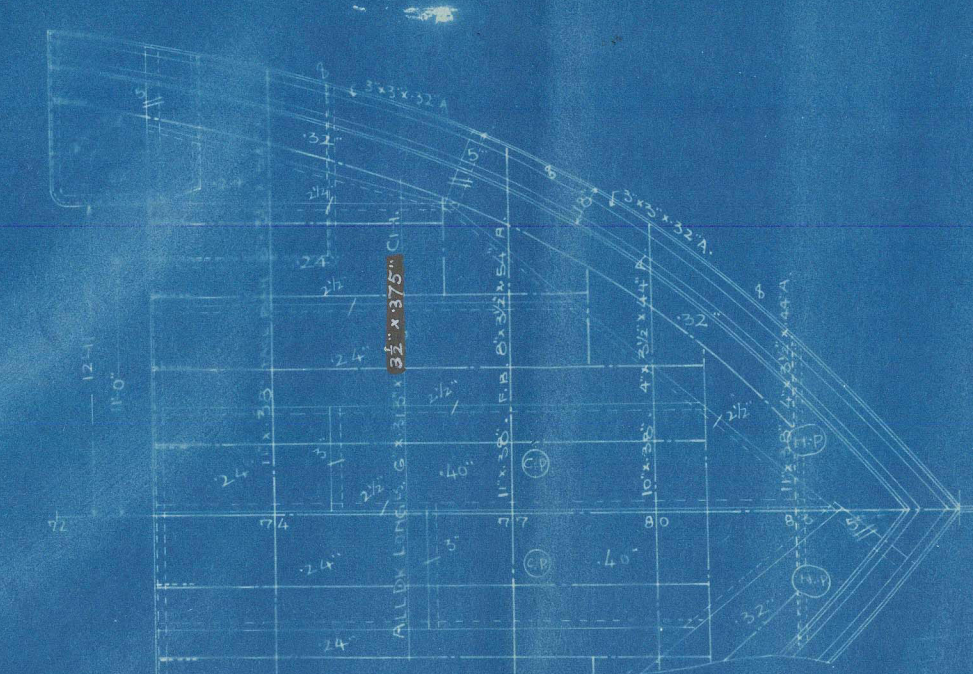


POOP DECK PLAN

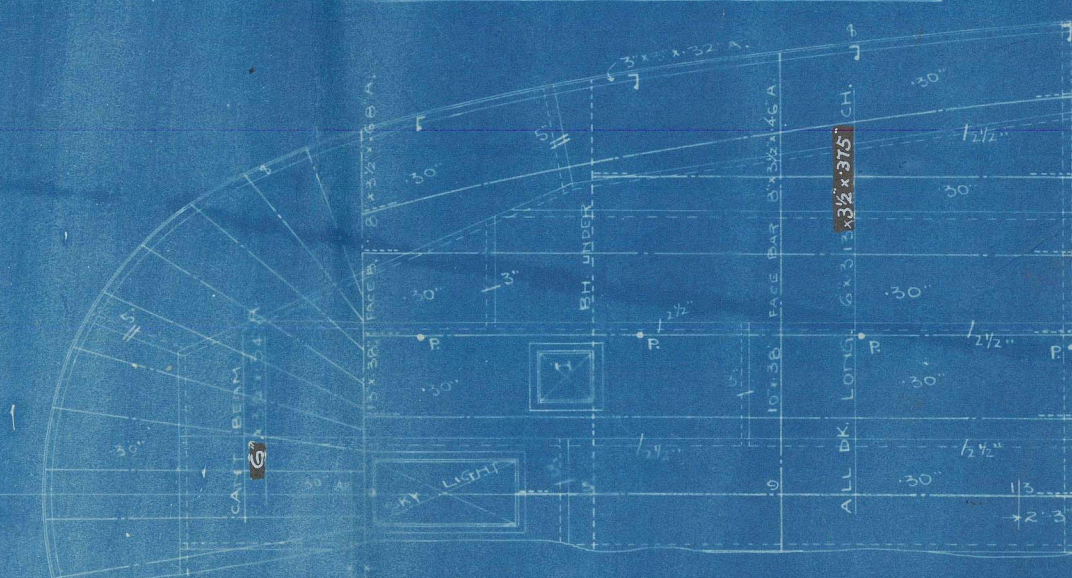

SHELTER DECK PLAN

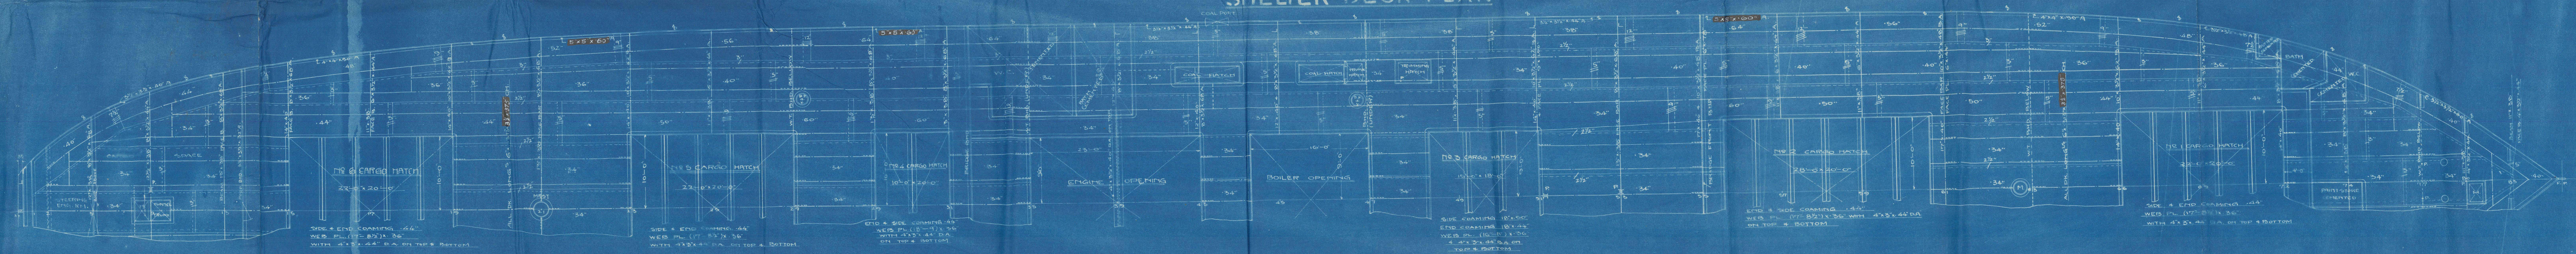

UPPER DECK PLAN

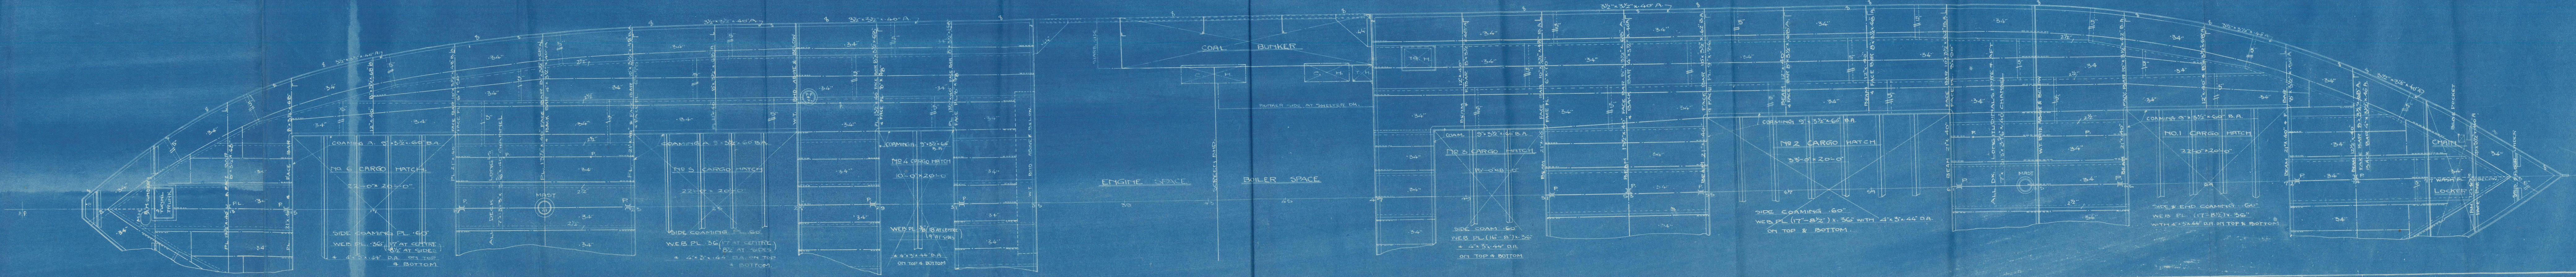


Decks

S. S. SURABAYA MARU

Asaka Iron Works

Nº 922

Kobe Reft. Nº 23 75-

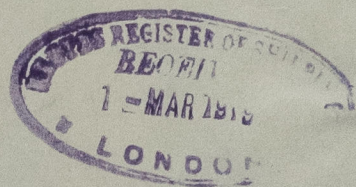

RETAIN

W1350-0191

SAT. - 1. MAR. 1919

W1350-0191



© 2020

Lloyd's Register
Foundation