


SCALE $\frac{1}{8}$ INCH TO ONE FOOT

17. 8-75.
up. 8-let.

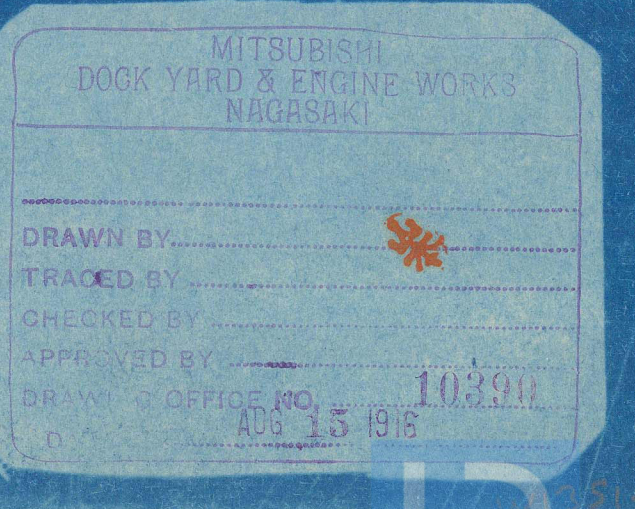


Profile & Decks as
built

J. S. S. N^o 249-50-57

Yokawa Maru

Nagasaki Refl. N^o 1083

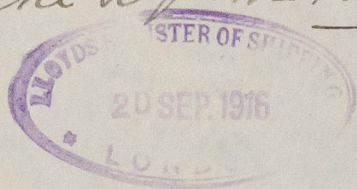

RETAIN



© 2021

Lloyd's Register
Foundation

W1351-0060